


CHANNEL STA 50+63.5 LT  
 BEGIN STRUCTURE EXCAVATION  
 GRANULAR BACKFILL FOR STRUCTURES

CHANNEL STA 50+26.4 LT  
 BEGIN UNCLASSIFIED CHANNEL EXCAVATION  
 GEOTEXTILE UNDER STONE FILL  
 STONE FILL, TYPE IV  
 GRUBBING MATERIAL

CHANNEL STA 50+33.7 RT  
 BEGIN STRUCTURE EXCAVATION  
 GRANULAR BACKFILL FOR STRUCTURES

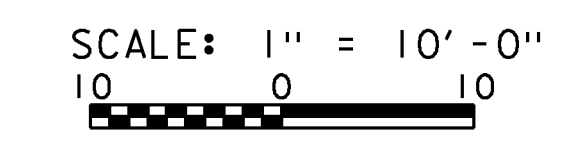

STA. 50+00 TO STA. 50+75

PROJECT NAME:	STOWE	PLOT DATE:	17-JUN-2013
PROJECT NUMBER:	BRF 029-1(17)	DRAWN BY:	R. PELLETT
FILE NAME:	s85e037xsl.dgn	CHECKED BY:	G. ROY
PROJECT LEADER:	C. CARLSON	SHEET	51 OF 70
DESIGNED BY:	H. SALLS	CHANNEL CROSS SECTIONS	2