

# RIGHT - OF - WAY DETAIL SHEET


TABLE OF PROPERTY ACQUISITION

PARCEL NO.	PROPERTY OWNER	SHEET NO.	BEGINNING STATION	ENDING STATION	TAKE	REMAINDER	RIGHT			RECORDING DATA				REMARKS					
					AREA±	AREA±	TYPE	(T)/(P)	AREA ±	TITLE	DATE	TOWN / CITY	BOOK		PAGE				
1	LONGE, CARLTON	5	14+81.42 RT	16+40.03 RT	0.12 A		ALL R. T. & I.			WD	04/19/12	STOWE	827	321-322	VT RTE 100 HWY EASE.; 5,300 SF±				
			14+87 RT	16+16 RT		DETOUR	(T)	0.23 A											
			15+09 RT	15+68 RT		CHANNEL	(P)	1,500 SF											
			15+56 RT	16+16 RT		CONST	(T)	0.14 A											
			15+69 RT	16+12 RT		ALL R. T. & I.												TO REMOVE OLD BUILDING; 6,100 SF±	
			15+88 RT	16+16 RT		UTILITY	(P)	470 SF										BUILDING TO BE REMOVED	
			15+91 RT				INSTALL & MAINT	(P)							GUY WIRE & ANCHOR				
2A	GOLD BROOK CAMPGROUND	4, 5	13+75.00 LT	14+68.83 LT	1,290 SF					WDIF	05/17/13	STOWE	860	46-47					
			12+39 LT	14+00 LT		CONST	(T)	1,110 SF											
			13+10 LT	14+59 LT		UTILITY	(P)	1,870 SF										INCL. BF & EC	
2B		5	12+75.00 LT	14+81.42 RT	0.11 A		ALL R. T. & I.								VT RTE 100 HWY EASE.; 4,840 SF±				
3A	HACKETT, EDSON B. LIFE ESTATE; HACKETT, WILLIAM B.; HACKETT, PARKER M.; PETERSON, ANNA H.	5, 6	14+58.87 LT	16+00.00 LT	1,990 SF					WDIF	03/07/13	STOWE	854	273-278					
			14+50 LT	15+86 LT		UTILITY	(P)	2,520 SF											
			15+39 LT			INSTALL & MAINT	(P)											GUY WIRE & ANCHOR	
			15+50 LT	15+73 LT		CONST	(T)	30 SF										INCL. BF	
			15+73 LT			INSTALL & MAINT	(P)												GUY WIRE & ANCHOR
			15+88 LT	17+00 LT		INSTALL	(T)	270 SF											PDF
			18+14 LT				INSTALL	(T)								TEMP SERVICE POLE			
3B		5, 6	14+68.83 LT	18+94.18 LT	0.24 A		ALL R. T. & I.								VT RTE 100 HWY EASE.; 10,330 SF±				
4	BOUCHARD, STEWART P. JR & PRISCILLA Y.	5	13+06 RT	15+19 RT			DETOUR	(T)	0.16 A			STOWE				INCL. PDF, EC, REMOVING TREES;			
			13+35 RT		DRIVE	(T)										6,950 SF±			
			14+45 RT	14+82 RT	CHANNEL	(P)	620 SF									40' WIDE PAVED, MM 0148			
																INCL. REMOVE WINGWALL			

TABLE OF REVISIONS

REVISION NO.	SHEET NO.	DESCRIPTION	DATE
1	2, 5	PARCEL 1, LONGE - ADD CONST (T) AROUND CREAMERY BUILDING ON LAYOUT AND DETAIL SHEET. COMPLETED BY: MT C.O. #9764 APPROVED BY: HP	02/23/12
2	2, 5	PARCEL 4, BOUCHARD - REMOVE ALL R. T. & I. IN EXISTING R.O.W. COMPLETED BY: MT C.O. #9786 APPROVED BY: HP	12/21/12
3	3, 5, 6	PARCEL 5, PEARSON - REMOVE ALL R. T. & I. IN EXISTING R.O.W. COMPLETED BY: MT C.O. #9787 APPROVED BY: HP	12/21/12
4	2, 5, 6	PARCEL 5, PEARSON - ACQUISITION OF EXISTING HIGHWAY EASEMENT. COMPLETED BY: MT C.O. #9795 APPROVED BY: HP	03/28/13
5	5	PARCEL 6, TOWN OF STOWE - REVISED DESIGN OF GOLD BROOK ROAD. NO CHANGES TO RIGHTS NEEDED. COMPLETED BY: MT C.O. #9796 APPROVED BY: HP	03/28/13

PLAN LEGEND

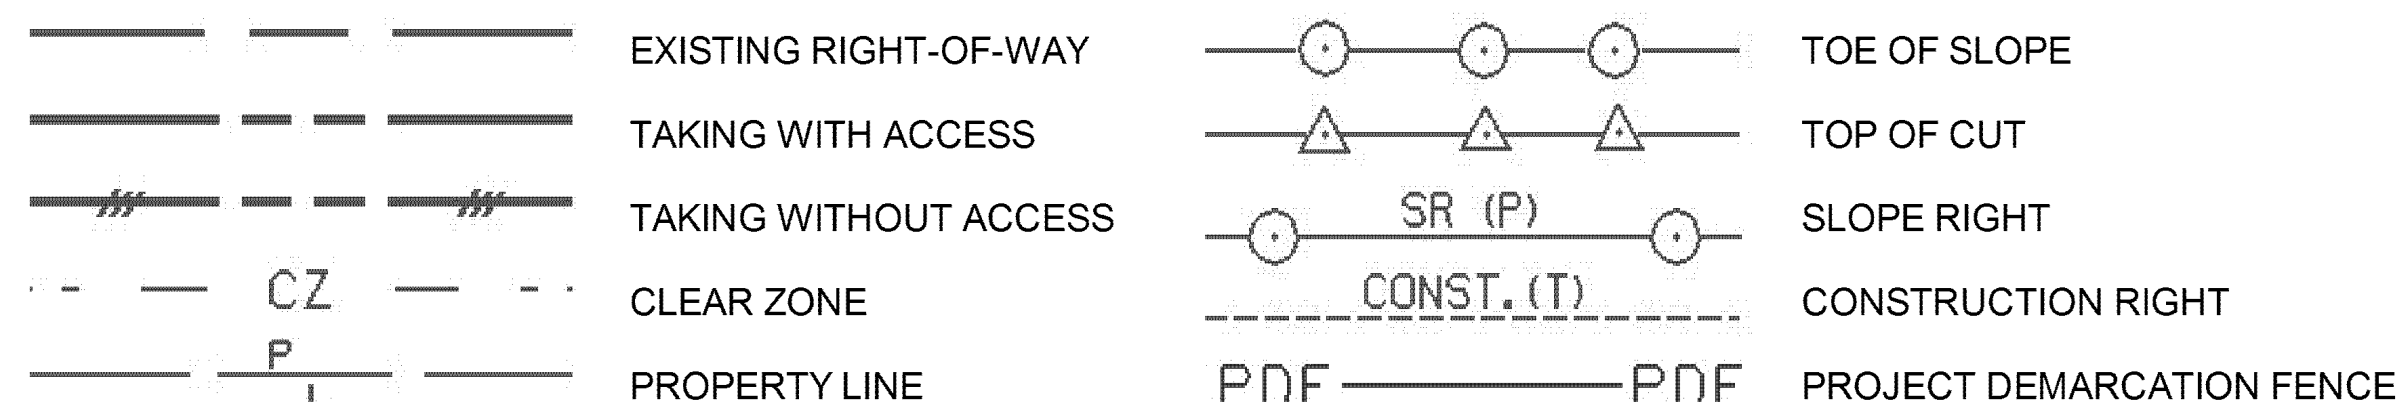

- PDF -PROJECT DEMARCATION FENCE
- EC -EROSION CONTROL
- (P) -PERMANENT
- (T) -TEMPORARY
- DR. -DRAINAGE RIGHT
- DIT. -DITCHING RIGHT
- CH. -CHANNEL RIGHT
- DRIVE -DRIVE RIGHT
- CUL. -CULVERT RIGHT
- C&T -CLEARING & TRIMMING RIGHT
- SR -SLOPE RIGHT
- UE -UTILITY EASEMENT

APPROVED: HARRY PETROYS DATE: 02-21-12  
CHIEF, PLANS & TITLES

PROJECT NAME: **STOWE**  
PROJECT NUMBER: **BRF 029-1 (17)**

FILE NAME: r85e037\_detail.xls PLOT DATE: 17-JUN-2013  
 PROJECT LEADER: C. WILLIAMS DRAWN BY: M. TROTTIER  
 DESIGNED BY: E. CHARBONNEAU CHECKED BY: E. PIERCE  
 R.O.W. DETAIL SHEET 1 OF 2 SHEET **66** OF **70**