


1 CURVED FLANGE LAYOUT
 B4 $3/16" = 1'-0"$

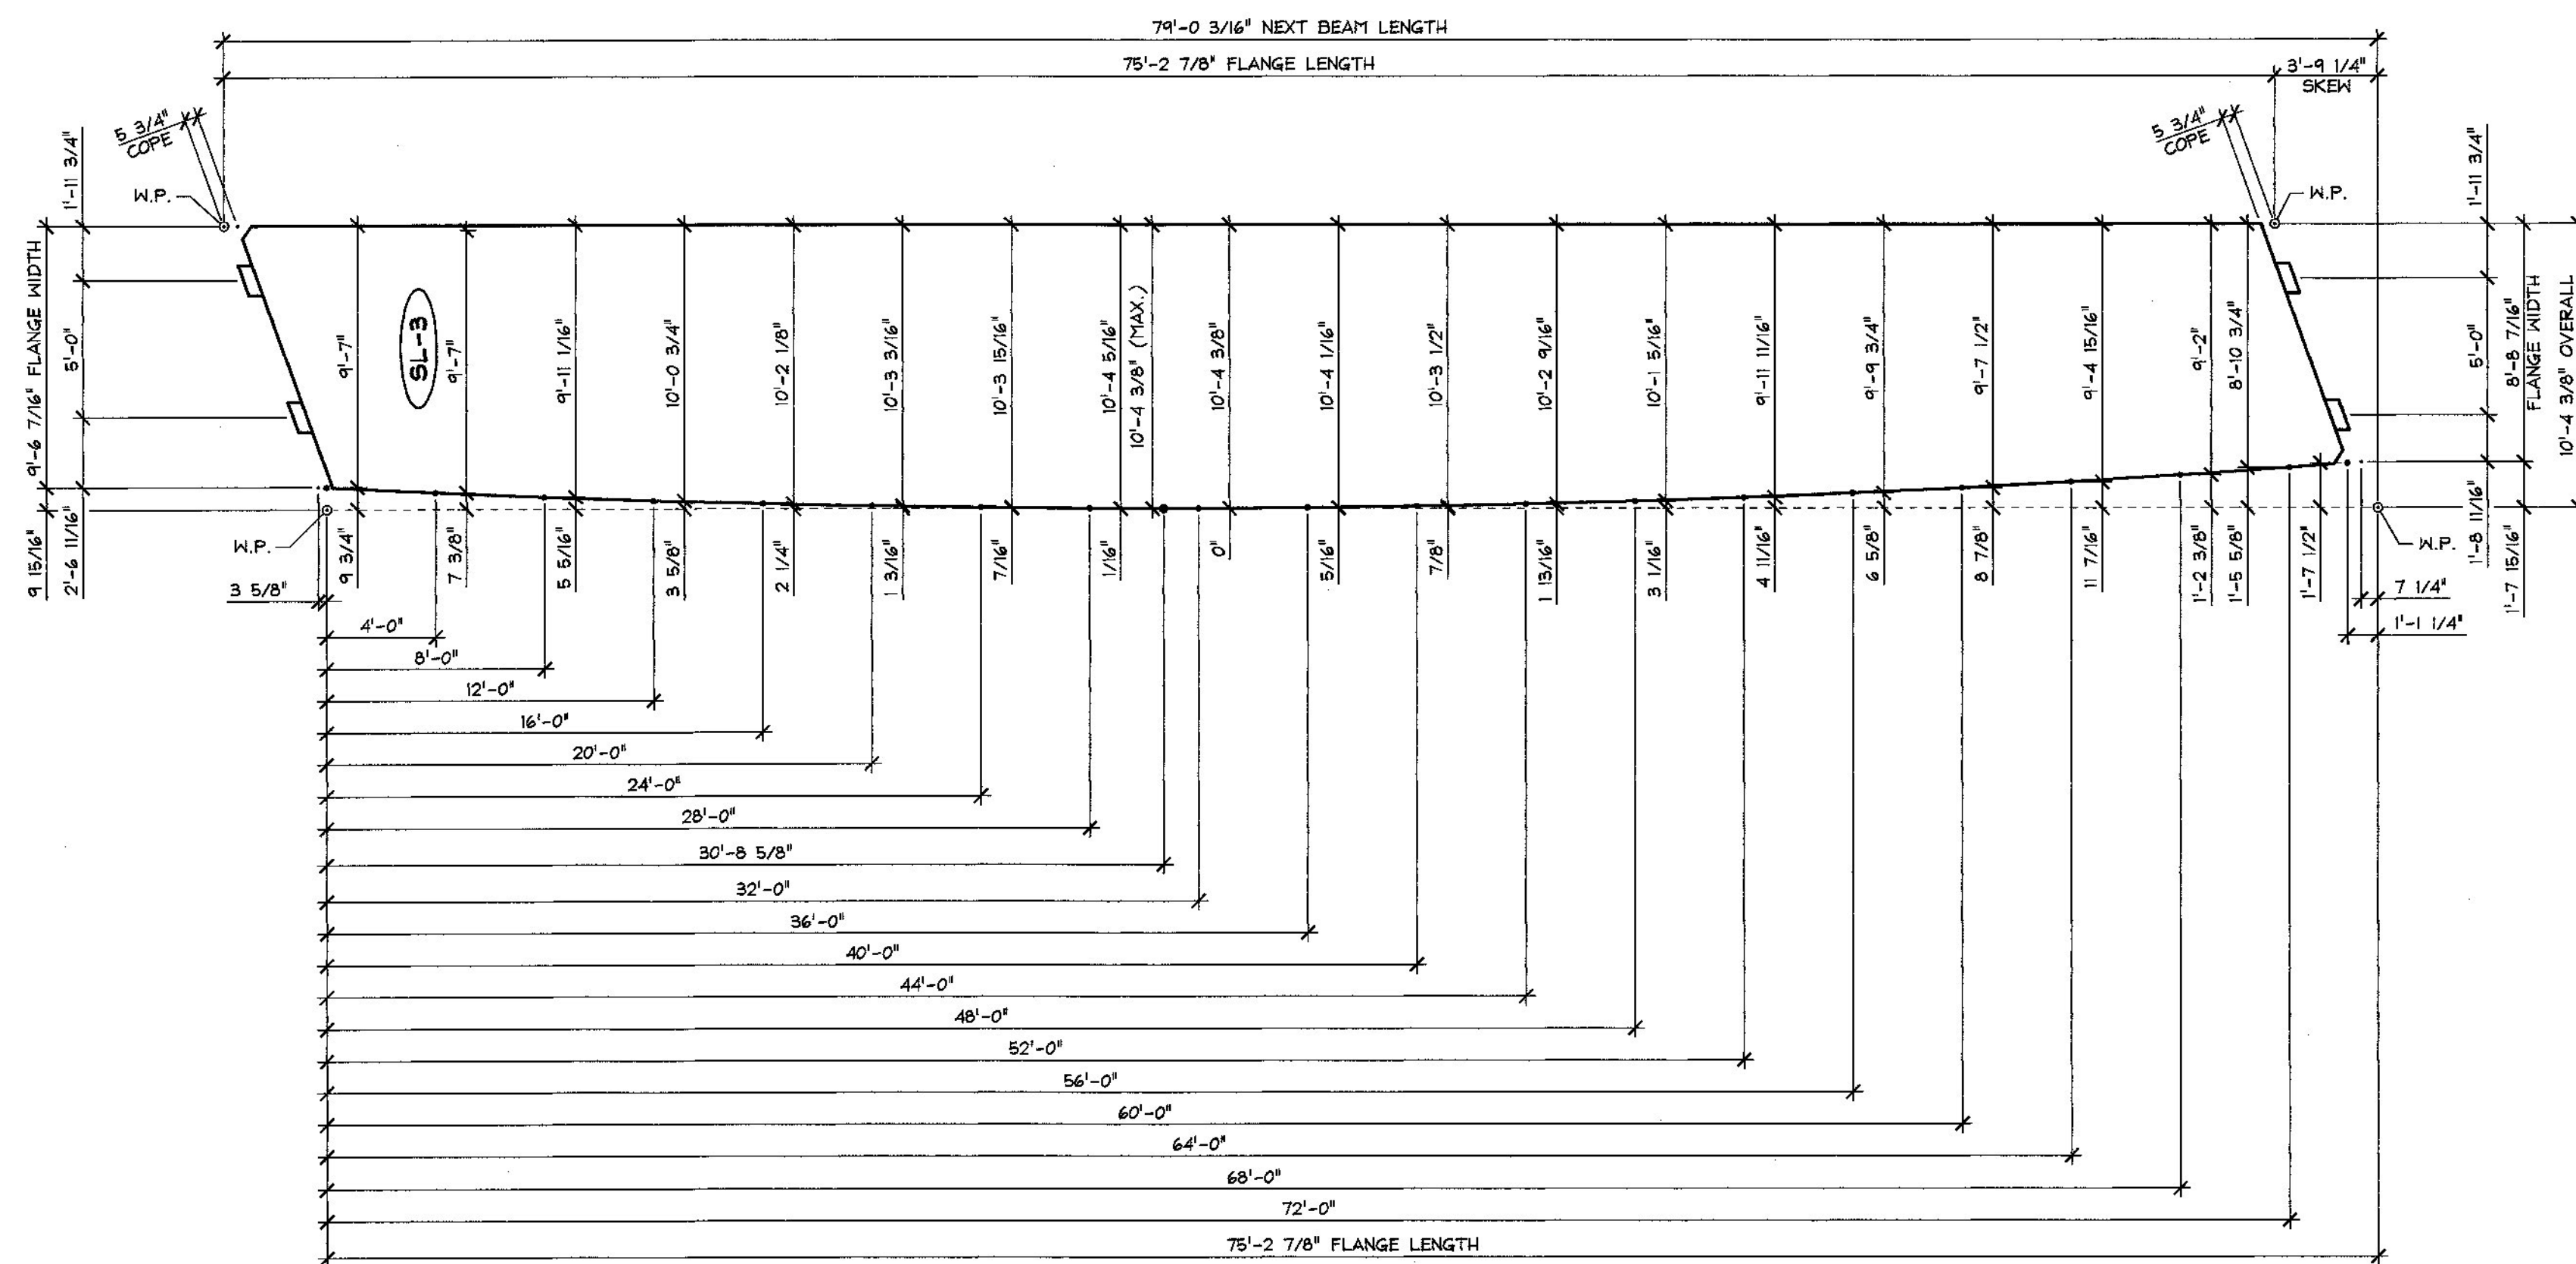

2 CURVED FLANGE LAYOUT
 B4 $3/16" = 1'-0"$

Vermont Agency of Transportation
RECEIVED

CK'D BY HIS _____ OK'D BY CLB _____

September 9, 2013

RESUBMIT _____ Approved _____
 BY C. Carlson DATE 10/02/2013

APPROVAL STAMP:	J.P. CARRARA & SONS INC. Precast & Prestress Manufacturer <small>244 DEX ST., MIDDLEBURY, VERMONT 05753 Phone: (802)388-6361 Fax: (802)388-9010</small>	AUSTIN CONSTRUCTION CONTRACTOR CONCORD, VERMONT
	STATE OF VERMONT AGENCY OF TRANSPORTATION COUNTY OF LAMOILLE	DATE: SEPT. 6, 2013 SCALE: NOTED
	TOWN OF STOWE ROUTE NO. VT 100, MINOR ARTERIAL BRIDGE NO.: 208 PROJECT NO.: BRF 029-1(17)	CHKD: - DFTM: B.L. JOB NO: 23398-013
	TOP FLANGE CURVE DIMENSIONS	DWG. NO: B4