


SEE SHEET 2 FOR INDEX OF SHEETS  
AND LIST OF STANDARDS

# STATE OF VERMONT AGENCY OF TRANSPORTATION



## PROPOSED IMPROVEMENT BRIDGE PROJECT TOWN OF STOCKBRIDGE COUNTY OF WINDSOR VT ROUTE 107, BRIDGE 9 MINOR ARTERIAL HIGHWAY

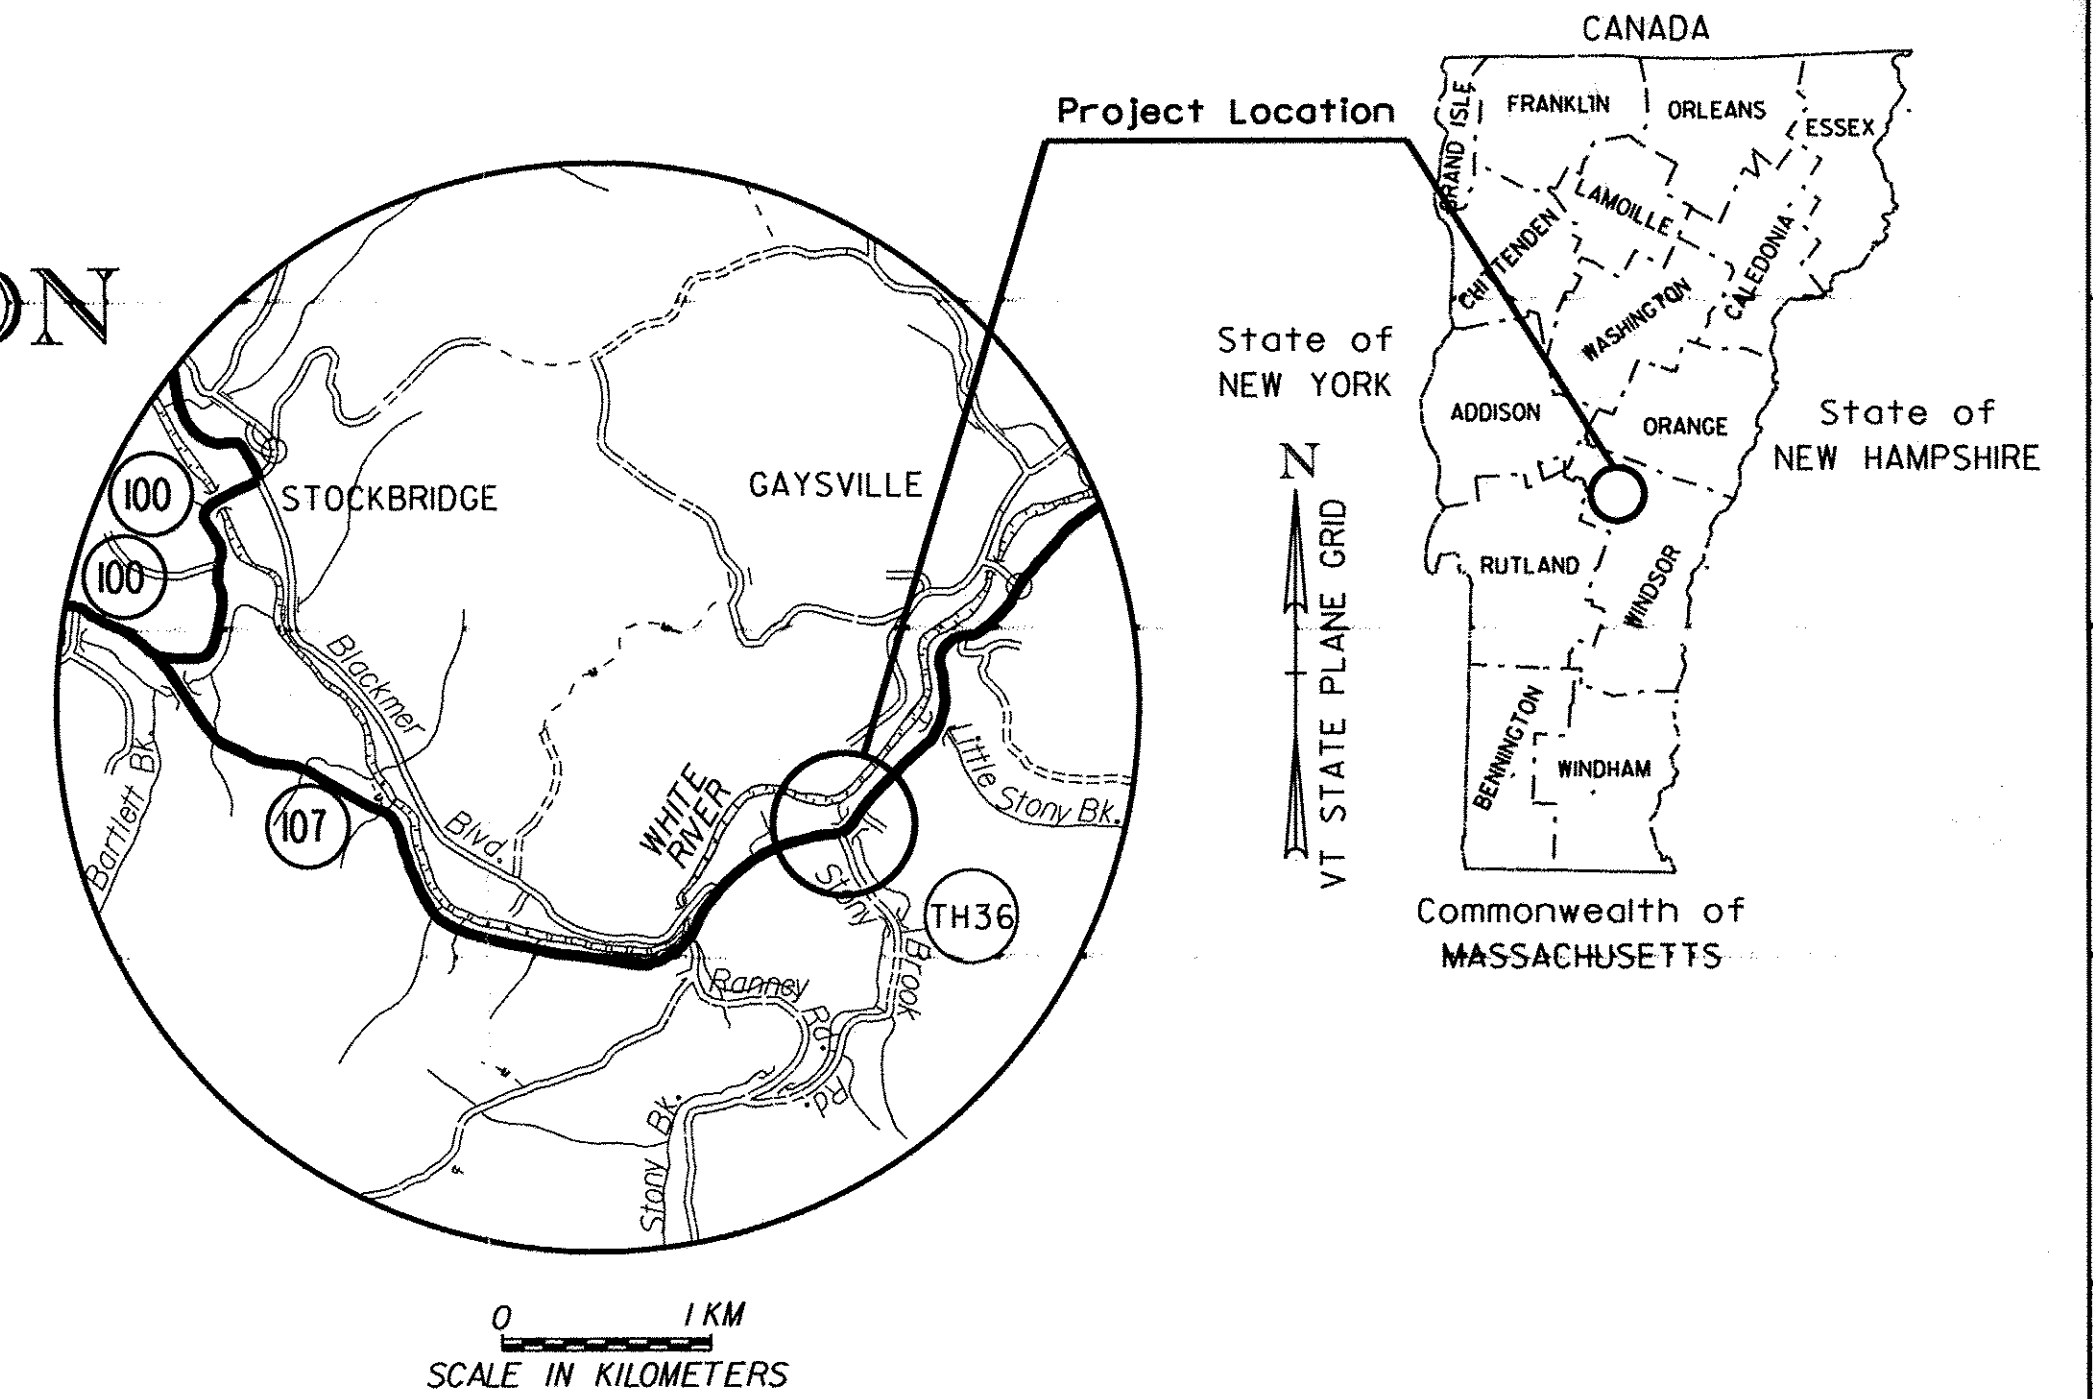

**RECORD PLANS**

CONTRACTOR: AUSTIN CONSTRUCTION, INC.-CONCORD, VT

RESIDENT ENGINEER: TOM CHASE

CONSTRUCTION BEGAN: JULY 26, 2010

CONSTRUCTION COMPLETE: OCTOBER 25, 2012

RECORD PLANS BY: TOM CHASE & KATHERINE KREIS

I HEREBY CERTIFY THAT ALL THE CONSTRUCTION REQUIRED BY THIS SET OF DRAWINGS HAS BEEN ACCOMPLISHED AS INDICATED HEREIN.

BY Thomas A. Chase RESIDENT ENGINEER


DATE 01/10/14

NOTE: Any further information concerning final quantities, amounts or other details relative to this project may be found at Central Files in the electronic archives.

BEGINNING AT A POINT, ON VERMONT ROUTE 107, IN THE TOWN OF STOCKBRIDGE, APPROXIMATELY 5.15 KILOMETERS EAST OF THE VERMONT ROUTE 107/VERMONT ROUTE 100 JUNCTION AND EXTENDING EASTERLY APPROXIMATELY 0.340 KILOMETERS ON VERMONT ROUTE 107.

WORK TO BE PERFORMED UNDER THIS PROJECT INCLUDES THE REMOVAL OF THE EXISTING BRIDGE SUPERSTRUCTURE, ABUTMENTS AND PIERS, RELOCATION OF STONY BROOK ROAD, CONSTRUCTION OF NEW BRIDGE SUPERSTRUCTURE AND ABUTMENTS, ROADWAY APPROACHES AND INCIDENTAL ITEMS.

PROJECT DATA	LENGTH (M)	LENGTH (KM)
TOWN OF STOCKBRIDGE VT RTE 107		
LENGTH OF ROADWAY	293.400	0.29340
LENGTH OF BRIDGE	46.600	0.04660
LENGTH OF PROJECT	340.000	0.34000

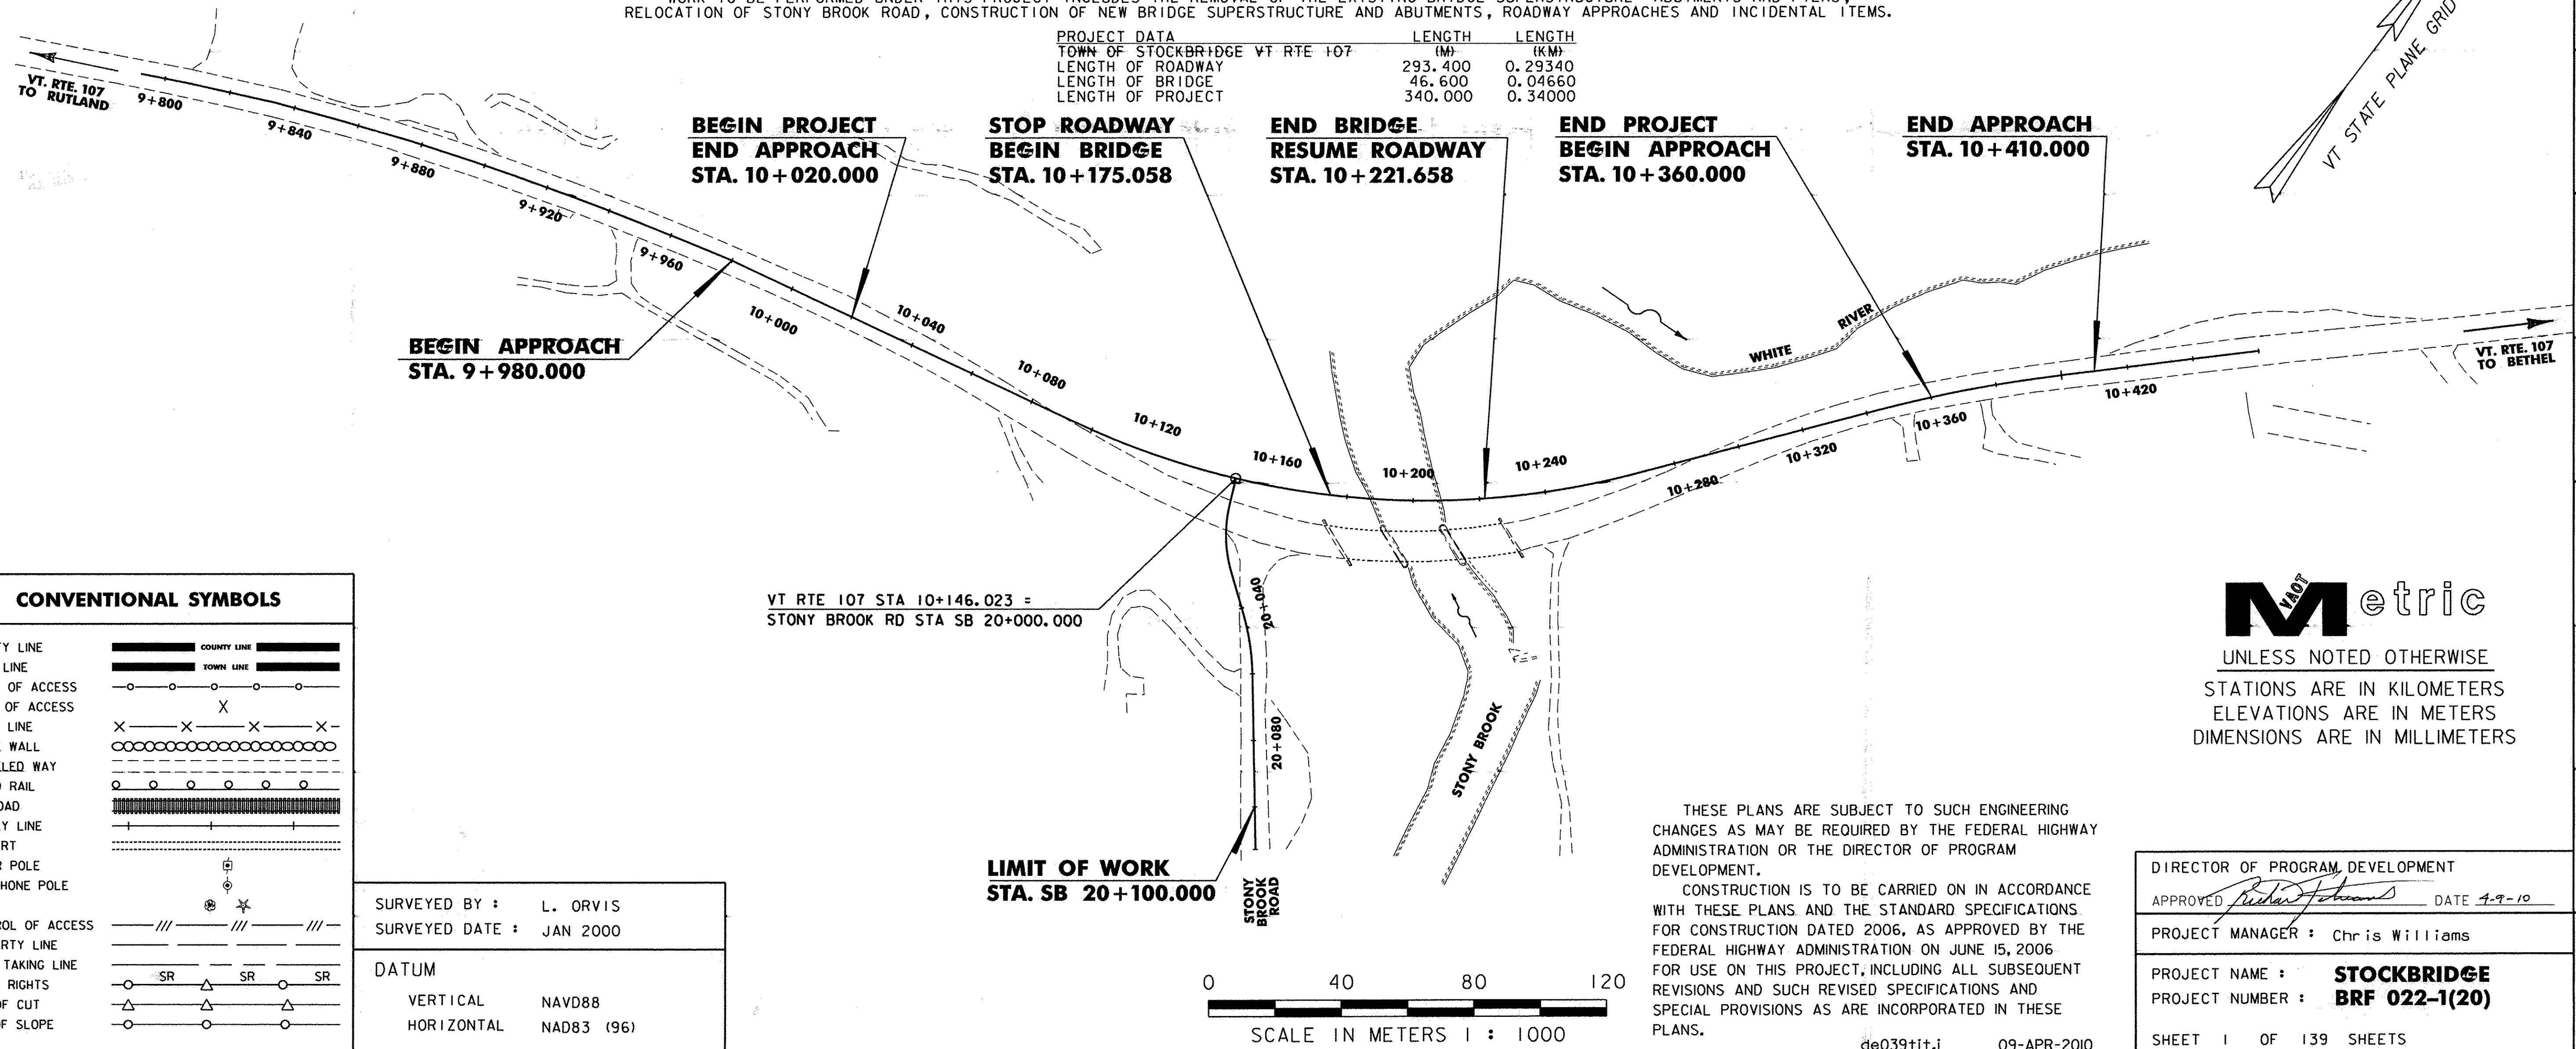

**CONVENTIONAL SYMBOLS**

COUNTY LINE	
TOWN LINE	
LIMITS OF ACCESS	
POINT OF ACCESS	
FENCE LINE	
STONE WALL	
TRAVELED WAY	
GUARD RAIL	
RAILROAD	
SURVEY LINE	
CULVERT	
POWER POLE	
TELEPHONE POLE	
TREES	
CONTROL OF ACCESS	
PROPERTY LINE	
R.O.W. TAKING LINE	
SLOPE RIGHTS	
TOP OF CUT	
TOE OF SLOPE	

SURVEYED BY : L. ORVIS

SURVEYED DATE : JAN 2000

DATUM

VERTICAL NAVD88

HORIZONTAL NAD83 (96)

THESE PLANS ARE SUBJECT TO SUCH ENGINEERING CHANGES AS MAY BE REQUIRED BY THE FEDERAL HIGHWAY ADMINISTRATION OR THE DIRECTOR OF PROGRAM DEVELOPMENT.

CONSTRUCTION IS TO BE CARRIED ON IN ACCORDANCE WITH THESE PLANS AND THE STANDARD SPECIFICATIONS FOR CONSTRUCTION DATED 2006, AS APPROVED BY THE FEDERAL HIGHWAY ADMINISTRATION ON JUNE 15, 2006 FOR USE ON THIS PROJECT, INCLUDING ALL SUBSEQUENT REVISIONS AND SUCH REVISED SPECIFICATIONS AND SPECIAL PROVISIONS AS ARE INCORPORATED IN THESE PLANS.

de039tit.1 09-APR-2010

**Metric**

UNLESS NOTED OTHERWISE  
STATIONS ARE IN KILOMETERS  
ELEVATIONS ARE IN METERS  
DIMENSIONS ARE IN MILLIMETERS

DIRECTOR OF PROGRAM DEVELOPMENT

APPROVED DATE 4-9-10

PROJECT MANAGER : Chris Williams

PROJECT NAME : **STOCKBRIDGE**

PROJECT NUMBER : **BRF 022-1(20)**

SHEET 1 OF 139 SHEETS