


NOTE:
 GRADES SHOWN TO THE NEAREST HUNDREDTHS ARE EXISTING GRADES ALONG ℓ .
 GRADES SHOWN TO THE NEAREST THOUSANDTHS ARE FINISH GRADES ALONG ℓ .

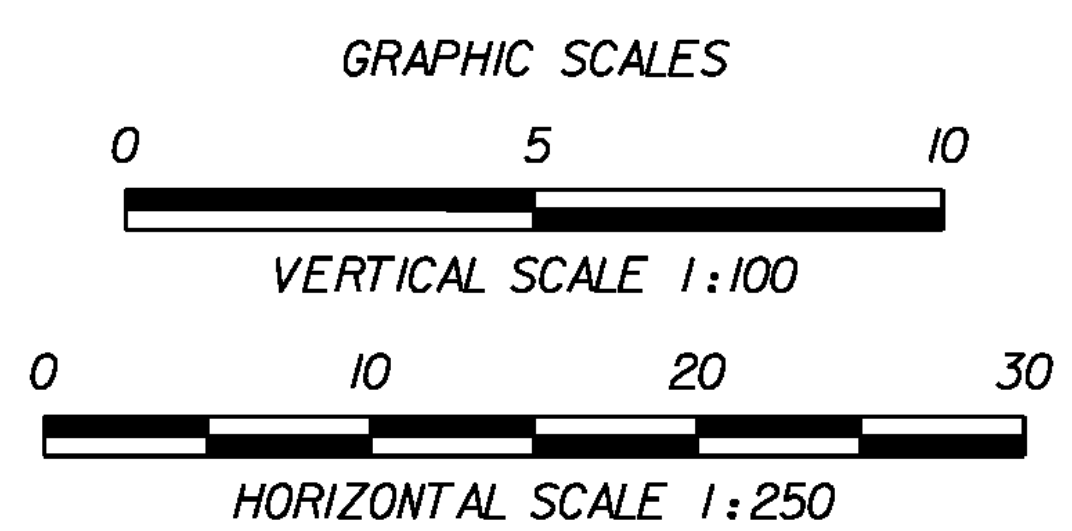

PROFILE 2

PROJECT NAME:	STOCKBRIDGE	PLOT DATE:	08-APR-2010
PROJECT NUMBER:	BRF 022-I(20)	DRAWN BY:	H.J.Salls
FILE NAME:	de039pro.dgn	CHECKED BY:	R. Young
PROJECT LEADER:	C.P. Williams	PROFILE 2	SHEET 21 OF 139