


NOTE:
 GRADES SHOWN TO THE NEAREST HUNDREDTHS
 ARE EXISTING GROUND ALONG ℓ .
 GRADES SHOWN TO THE NEAREST THOUSANDTHS
 ARE FINISH GRADES ALONG ℓ .

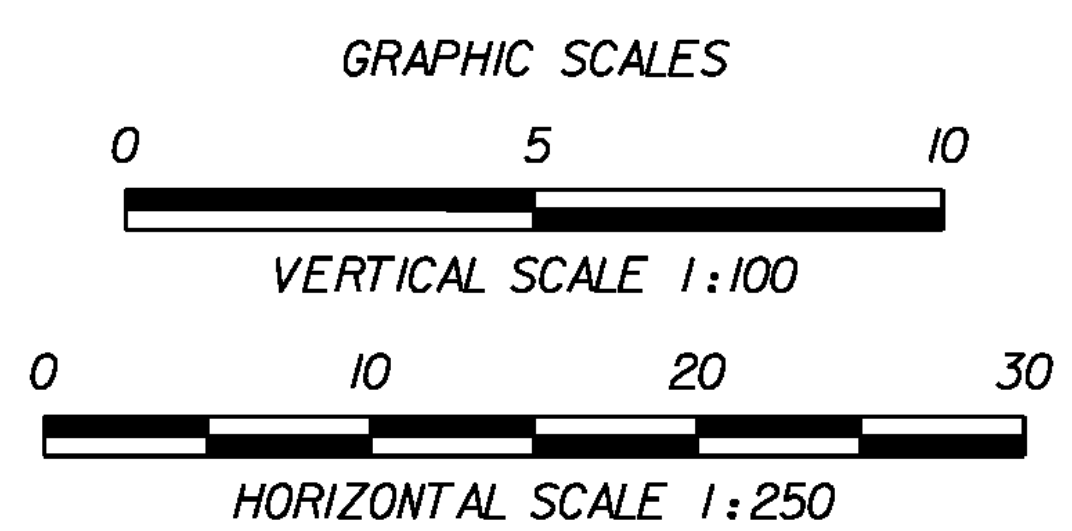

PROFILE 3

PROJECT NAME:	STOCKBRIDGE	PLOT DATE:	08-APR-2010
PROJECT NUMBER:	BRF 022-I(20)	DRAWN BY:	G. Shangraw
FILE NAME:	de039pro.dgn	CHECKED BY:	R.S.YOUNG
PROJECT LEADER:	C.P. Williams	PROFILE 3	SHEET 22 OF 139
DESIGNED BY:	G. Shangraw		