

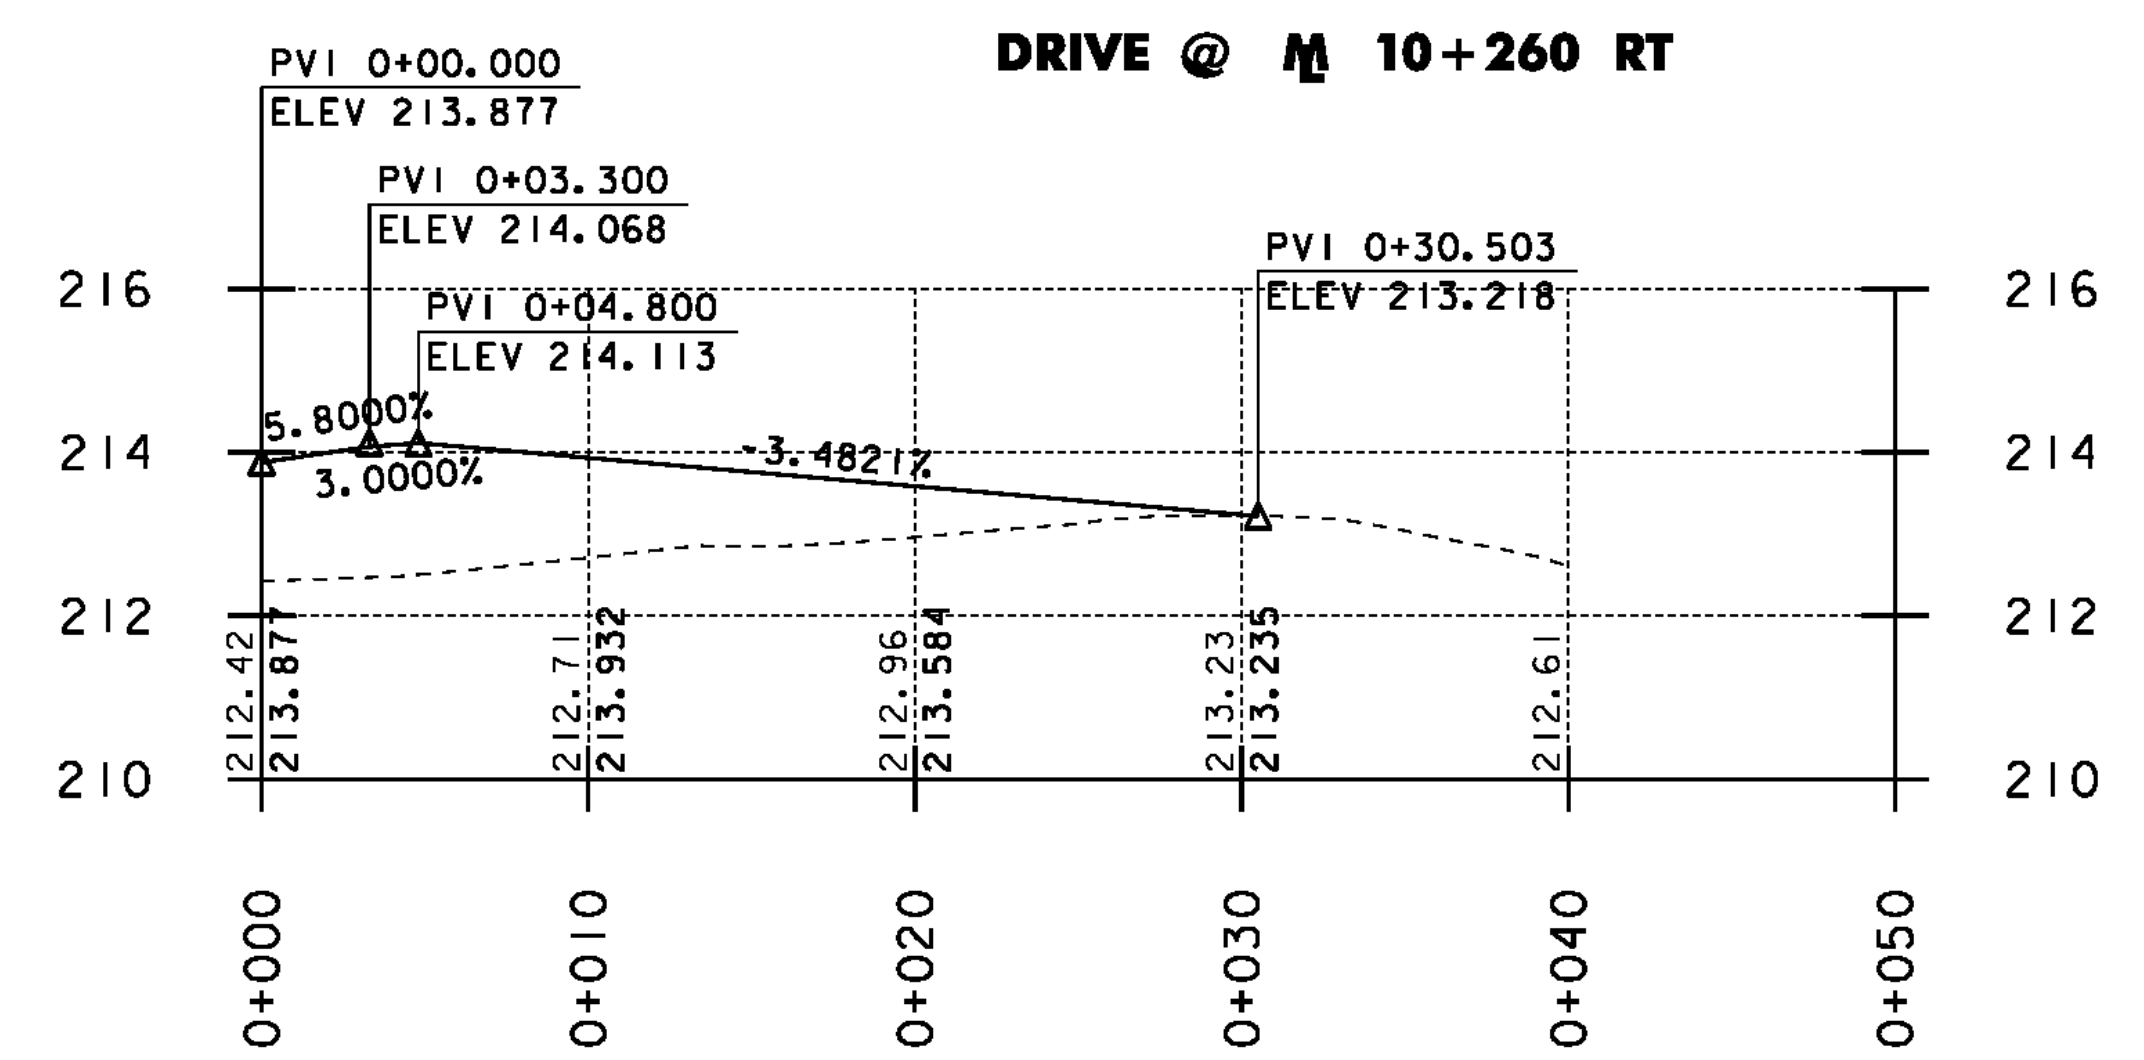


STONY BROOK RD

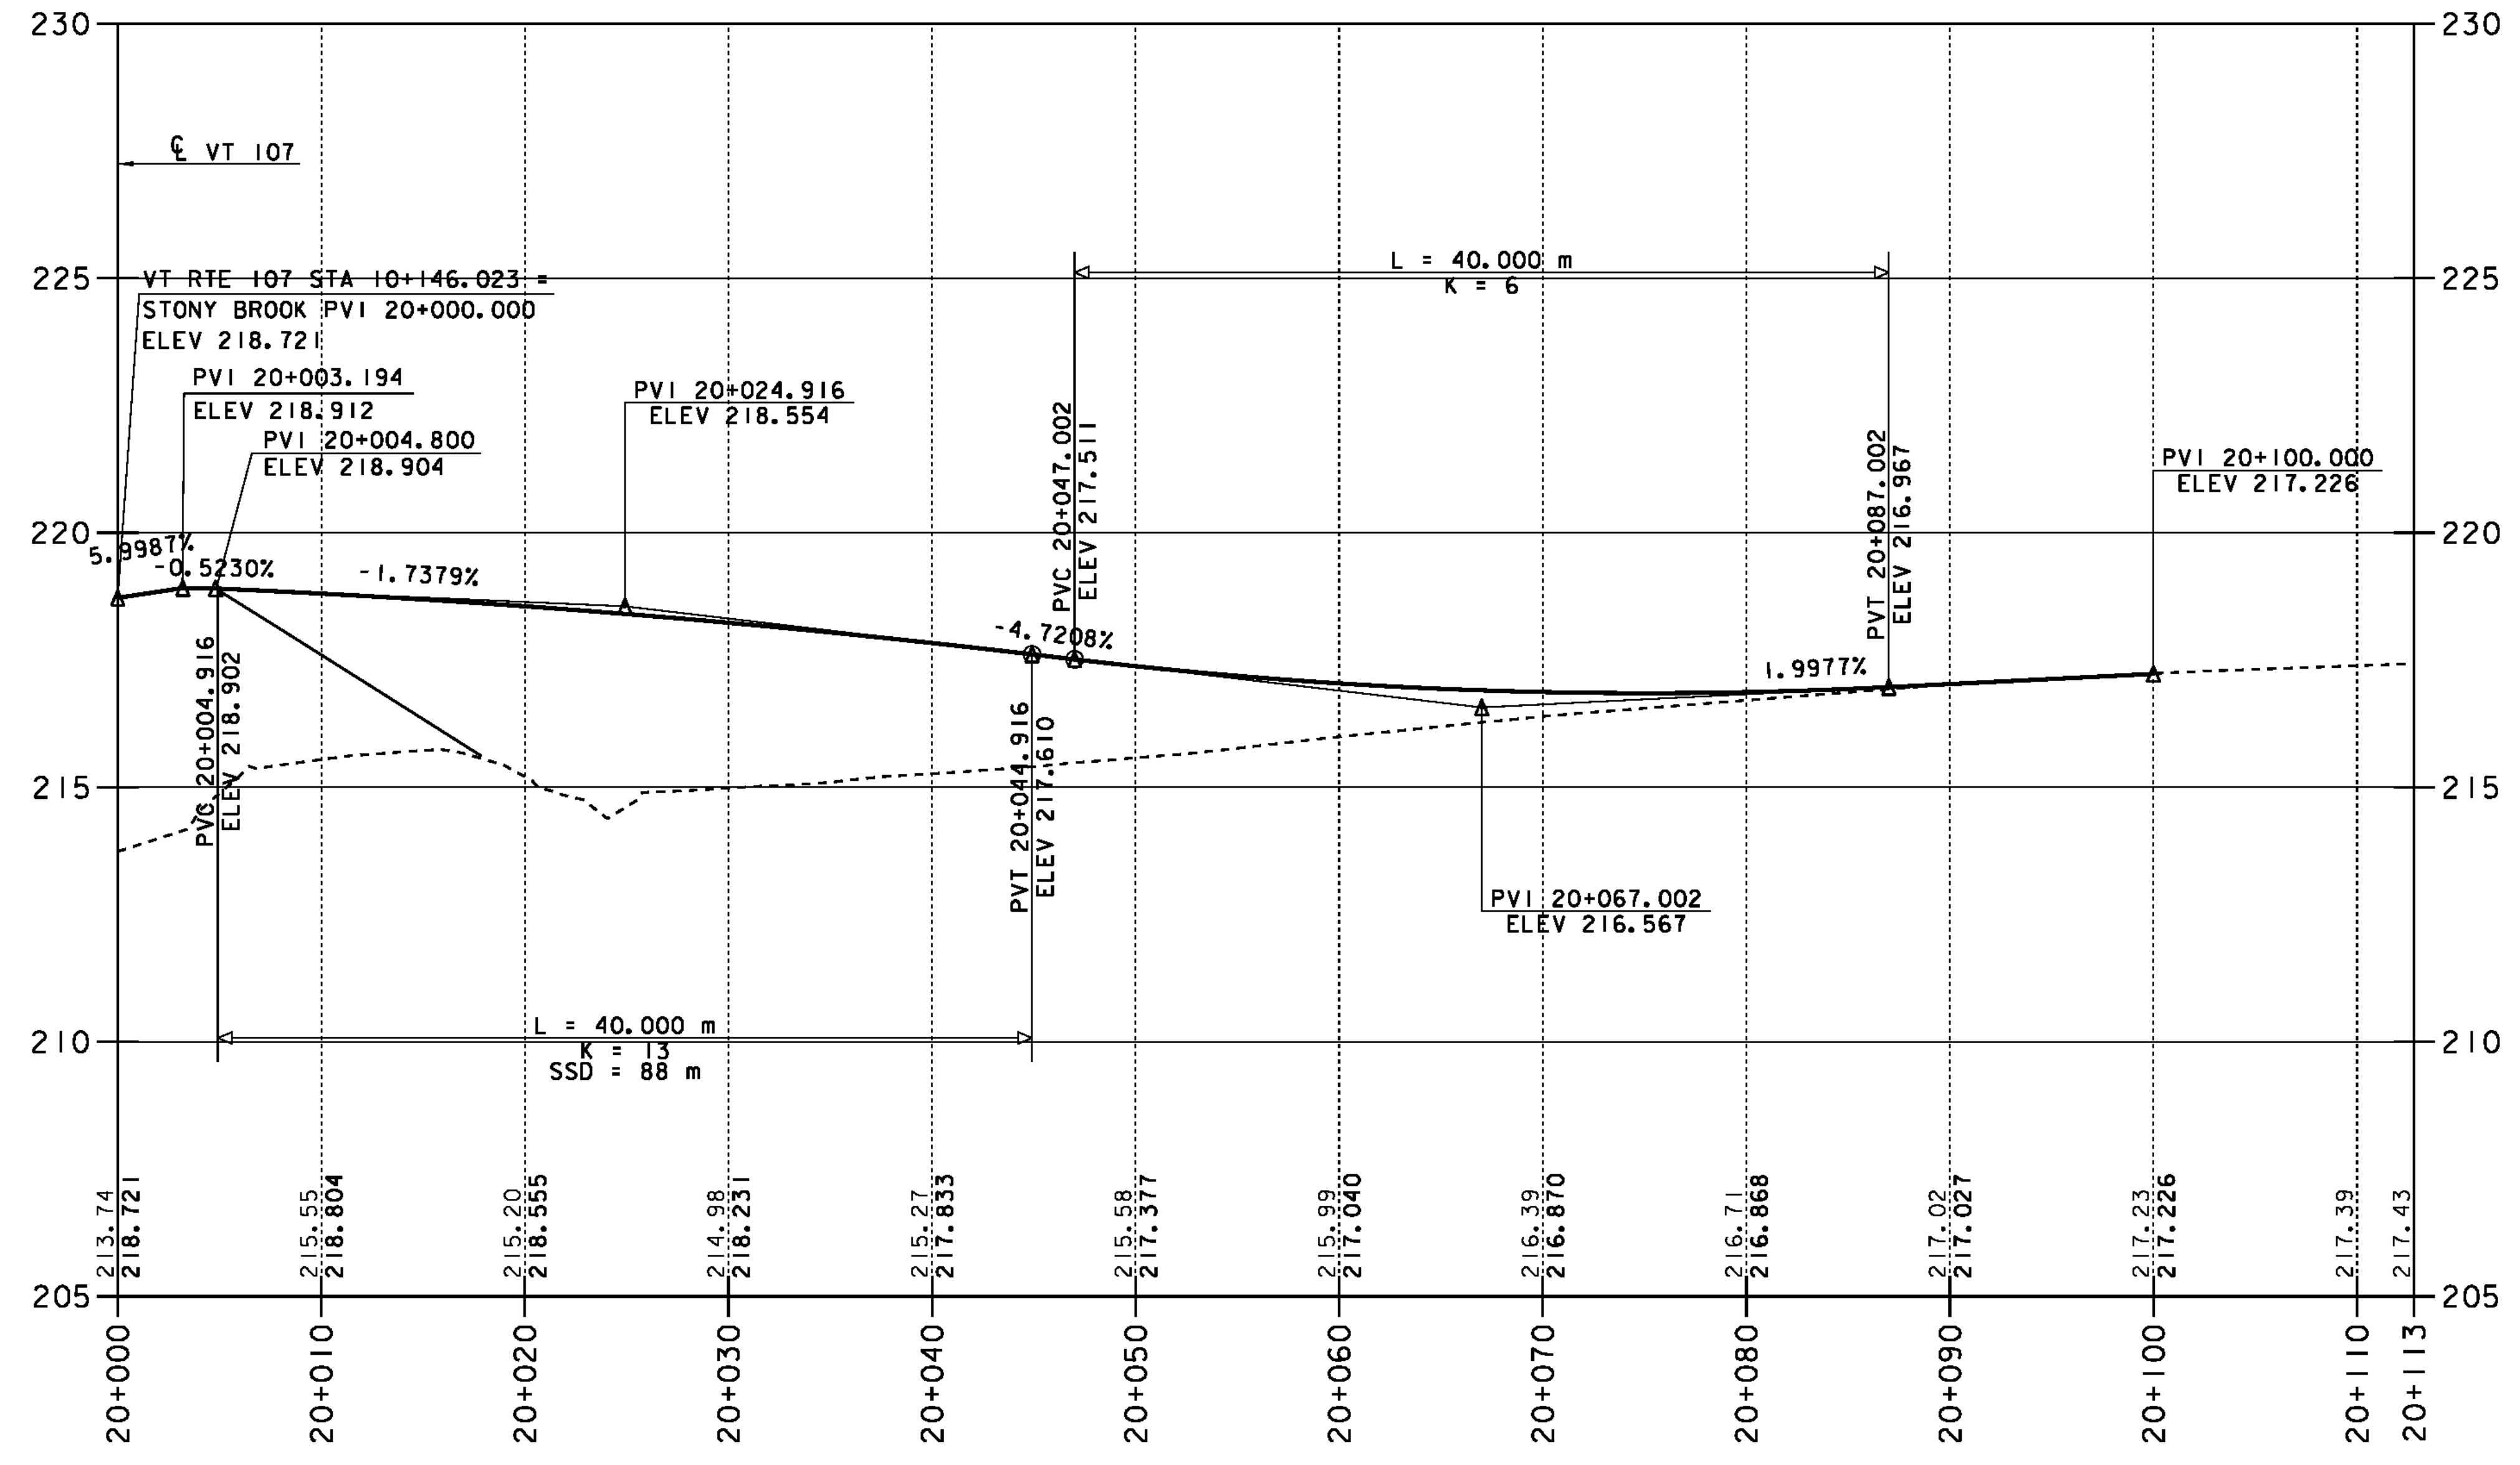

NOTE:
GRADES SHOWN TO THE NEAREST HUNDREDTHS
ARE EXISTING GROUND ALONG CL.

GRADES SHOWN TO THE NEAREST THOUSANDTHS
ARE FINISH GRADES ALONG CL.

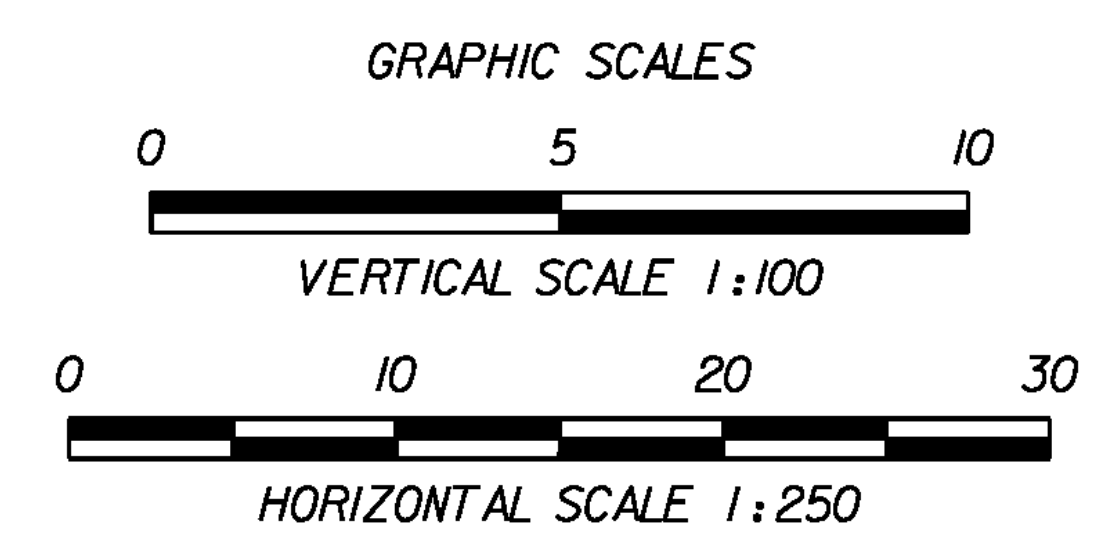

STONY BROOK & DRIVE PROFILE

PROJECT NAME:	STOCKBRIDGE	PLOT DATE:	08-APR-2010
PROJECT NUMBER:	BRF 022-I(20)	DRAWN BY:	G. Shangraw
FILE NAME:	de039pro.dgn	CHECKED BY:	R.S.YOUNG
PROJECT LEADER:	C.P. Williams	PROFILE 4	SHEET 23 OF 139
DESIGNED BY:	G. Shangraw		