


PLAN & ELEVATION SHEET

ELEVATION LOOKING DOWNSTREAM

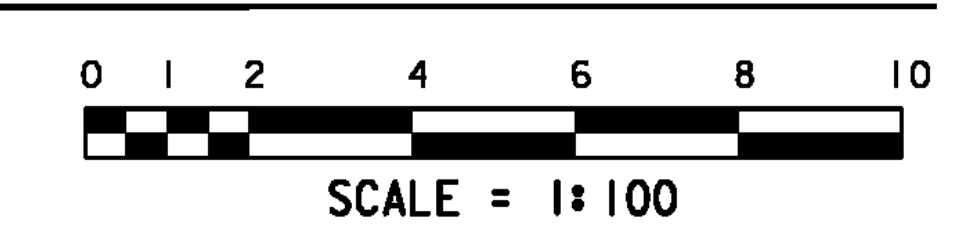

PROJECT: STOCKBRIDGE	PROJECT NO.: BRF 022-1 (20)
DESIGN FILE NAME: 85e039\Structures\de039pe.dgn	PLOT DATE: 09-APR-2010
IPARM FILE NAME: de039pe.i	DRAWN BY: H. I. SALLS
DESIGNED BY: H. I. SALLS	CHECKED BY: R. S. YOUNG
SQUAD LEADER: C. P. WILLIAMS	SHEET: 52 OF 139
PLAN AND ELEVATION	