
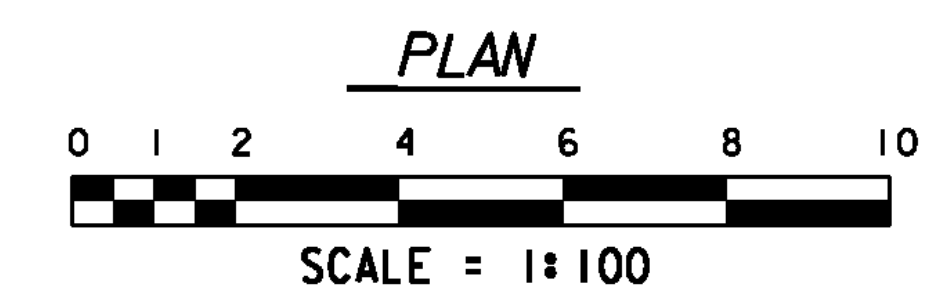


Guardrail Approach Section, Galvanized NETC 4 Rail
 10+165.10 ~ 10+175.04 Lt.
 (SB 20+004.72) ML 10+165.52 ~ 10+175.07 Rt.
 10+221.67 ~ 10+231.62 Lt.
 10+221.64 ~ 10+231.21 Rt.

Bridge Railing, Galvanized NETC 4 Rail
 10+175.04 ~ 10+221.67 Lt.
 10+175.07 ~ 10+221.64 Rt.

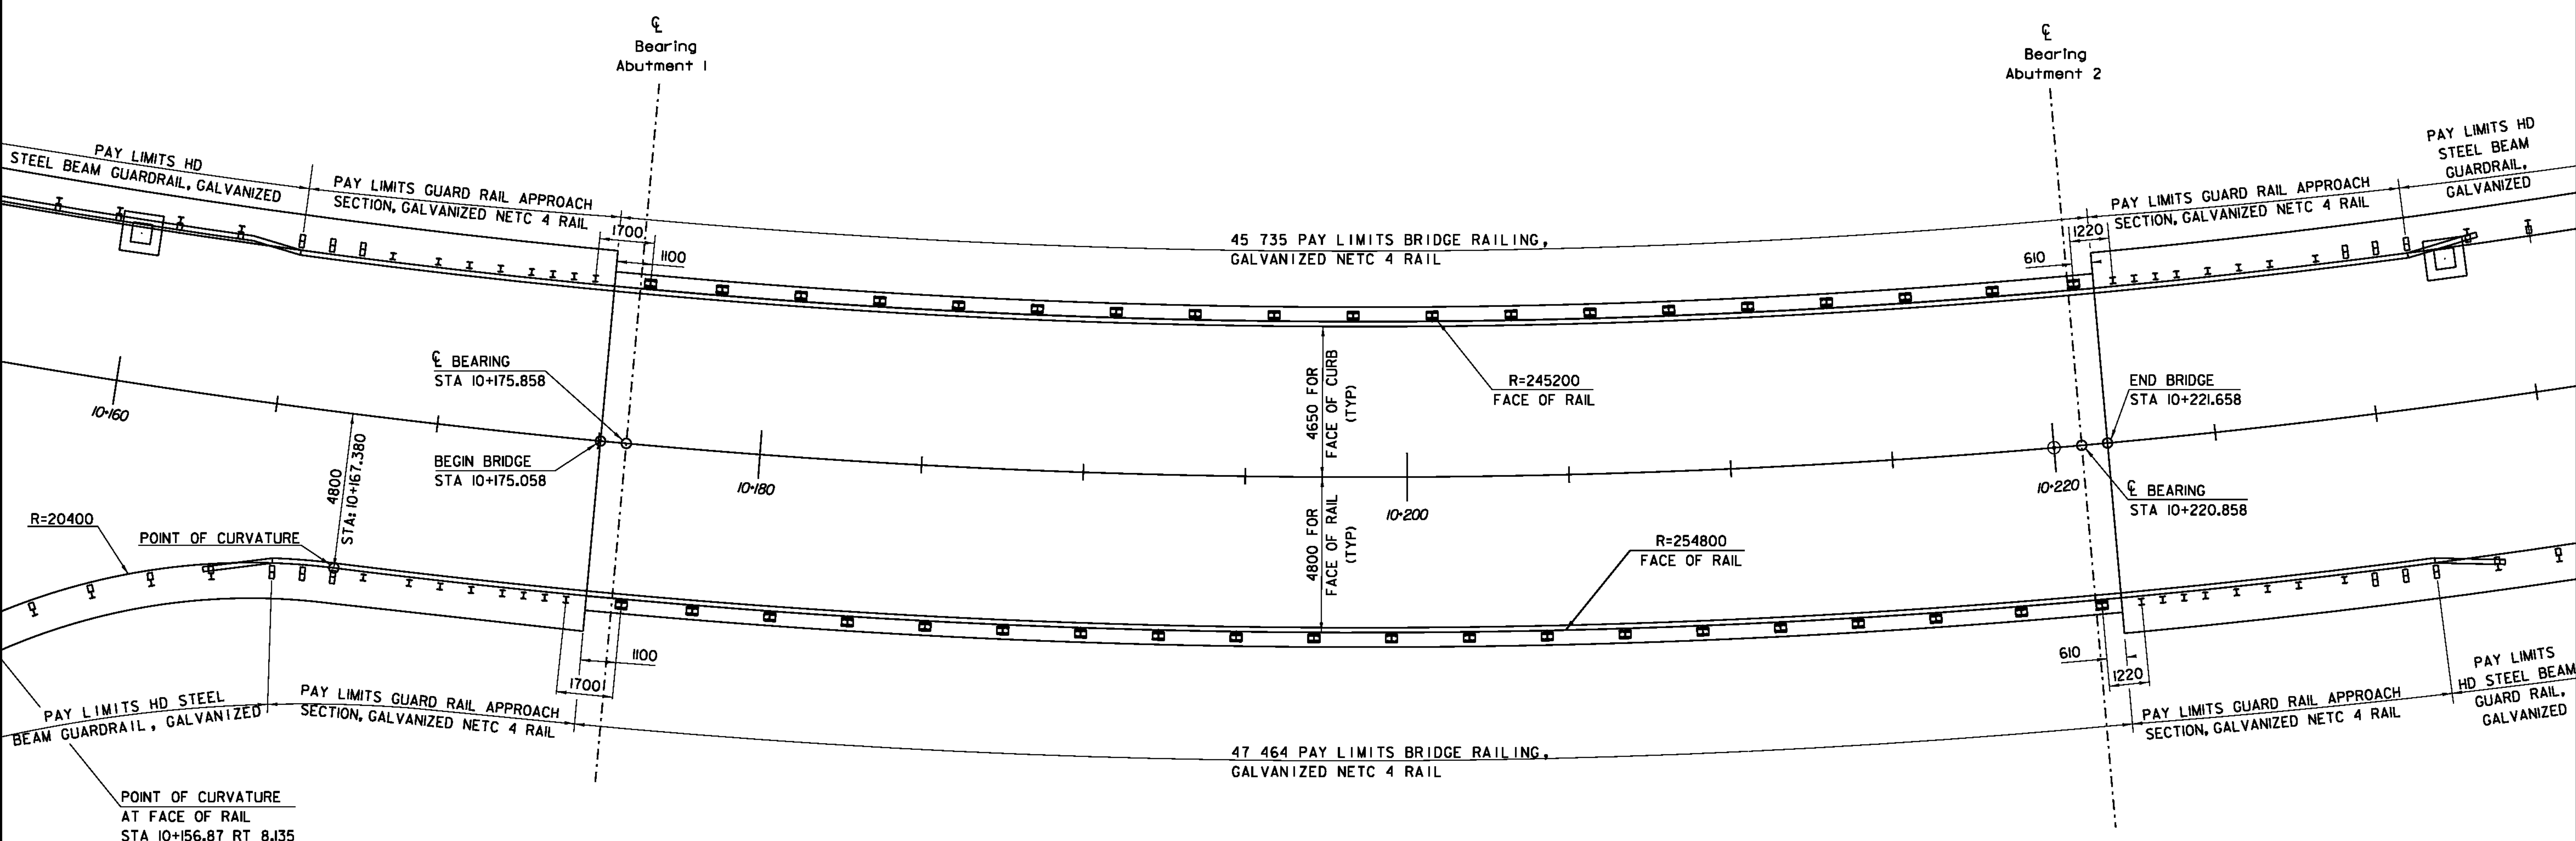

RAILING LAYOUT

PROJECT: STOCKBRIDGE	PROJECT NO.: BRF 022-1 (20)
DESIGN FILE NAME: 85e039\Structures\de039rail.dgn	
IPARM FILE NAME: de039rail.layout.i PLOT DATE: 08-APR-2010	
DESIGNED BY: H. I. SALLS	DRAWN BY: H. I. SALLS
SQUAD LEADER: C. P. WILLIAMS	CHECKED BY: R. S. YOUNG
RAILING LAYOUT	SHEET: 77 OF 139