


Benchmark #2
Goddard Az Mark
Elev. 225.690

BEGIN R.O.W. PROJECT
BRF 022-1(20)
9+872.87

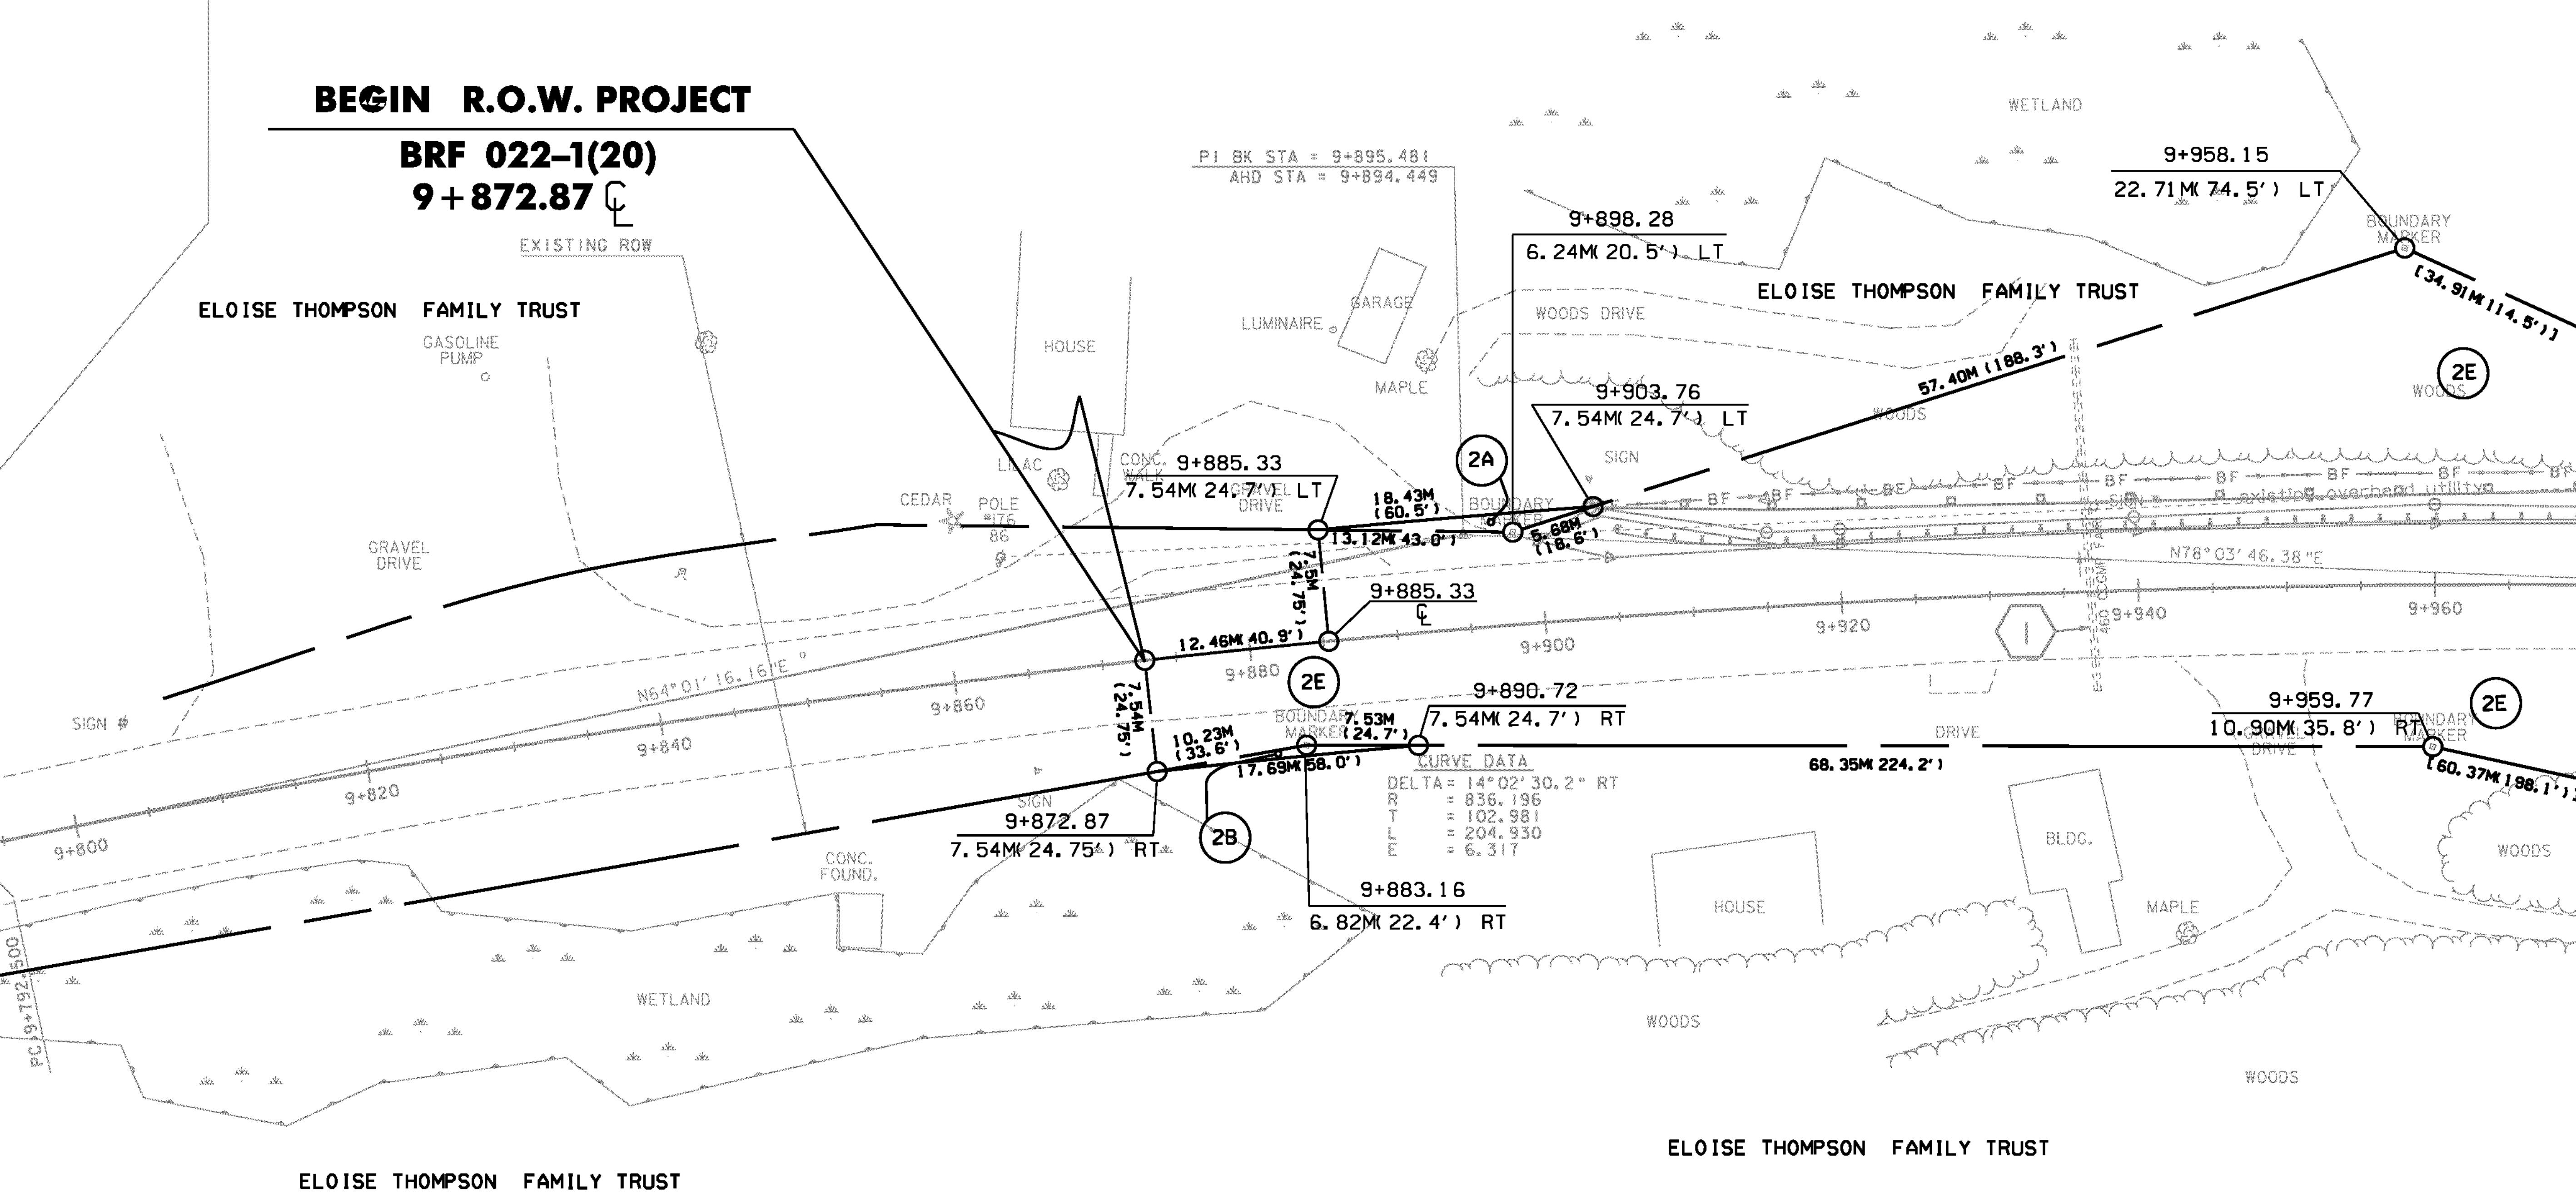

LEGEND

	SEED AND MULCH
	EROSION CONTROL MATTING
	SILT FENCE
	FILTER CURTAIN
	PDF FENCE
	BARRIER FENCE
	DI PROTECTION
	TEMPORARY STONE CHECK DAM

LINES SHOWN ON THIS PLAN AS EXISTING PROPERTY LINES P/L ARE BELIEVED TO BE ACCURATE BUT SHOULD NOT BE RELIED UPON FOR PURPOSES UNRELATED TO THE STATE OF VERMONT'S ACQUISITION OF LAND AND RIGHTS FOR THIS PROJECT.

FOR EROSION CONTROL
SEE SHEET 14-22 OF 33

**FOR R.O.W.
USE ONLY**

R.O.W. LAYOUT 1

SEE DRAINAGE DETAIL SHEET
FOR DRAINAGE FLAG DESCRIPTIONS



PROJECT NAME: STOCKBRIDGE	PLOT DATE: 08-APR-2010
PROJECT NUMBER: BRF 022-1(20)	DRAWN BY: H. I. SALLS
FILE NAME: 85e039/de039bdr.dgn	CHECKED BY: R. S. YOUNG
PROJECT LEADER: C. P. WILLIAMS	SHEET 90 OF 139
DESIGNED BY: R. S. YOUNG	
ROW SHEET 29 OF 33	