



LEGEND	
	SEED AND MULCH
	EROSION CONTROL MATTING
	SILT FENCE
	FILTER CURTAIN
	PDF FENCE
	BARRIER FENCE
	RIPARIAN BUFFER ZONE
	DI PROTECTION
	TEMPORARY STONE CHECK DAM
	STONE FILL TYPE II
	STONE FILL TYPE IV

- NOTES:
1. THESE PLANS SHOW A CONCEPTUAL EROSION PREVENTION AND SEDIMENT CONTROL PLAN, THE CONTRACTOR MUST SUBMIT A TEMPORARY EROSION PREVENTION AND SEDIMENT CONTROL PLAN FOR APPROVAL.
 2. TEMPORARY EROSION PREVENTION AND SEDIMENT CONTROL MEASURES ARE CONCEPTUALLY SHOWN. THE CONTRACTOR MAY RELOCATE TEMPORARY MEASURES TO IMPROVE EROSION PREVENTION AND SEDIMENT CONTROL WITH APPROVAL OF THE RESIDENT ENGINEER AND ON SITE COORDINATOR. SILT FENCE SHALL NOT BE INSTALLED ACROSS CONTOURS.
 3. THE CONTRACTOR SHALL USE OTHER TEMPORARY EROSION PREVENTION AND SEDIMENT CONTROL MEASURES AS NECESSITATED BY THE SEQUENCE OF CONSTRUCTION OR AS DIRECTED BY THE RESIDENT ENGINEER AND ON SITE COORDINATOR.
 4. REFER TO TEMPORARY EROSION PREVENTION AND SEDIMENT CONTROL DETAIL SHEETS FOR ADDITIONAL DETAILS.

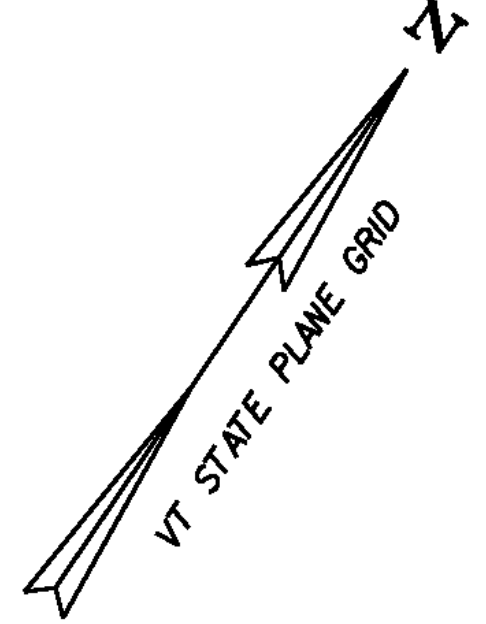

CURVE DATA
 DELTA = 39° 45' 18.8" LT
 R = 250.000
 T = 90.388
 L = 173.465
 E = 15.838
 BANK = 6.0%

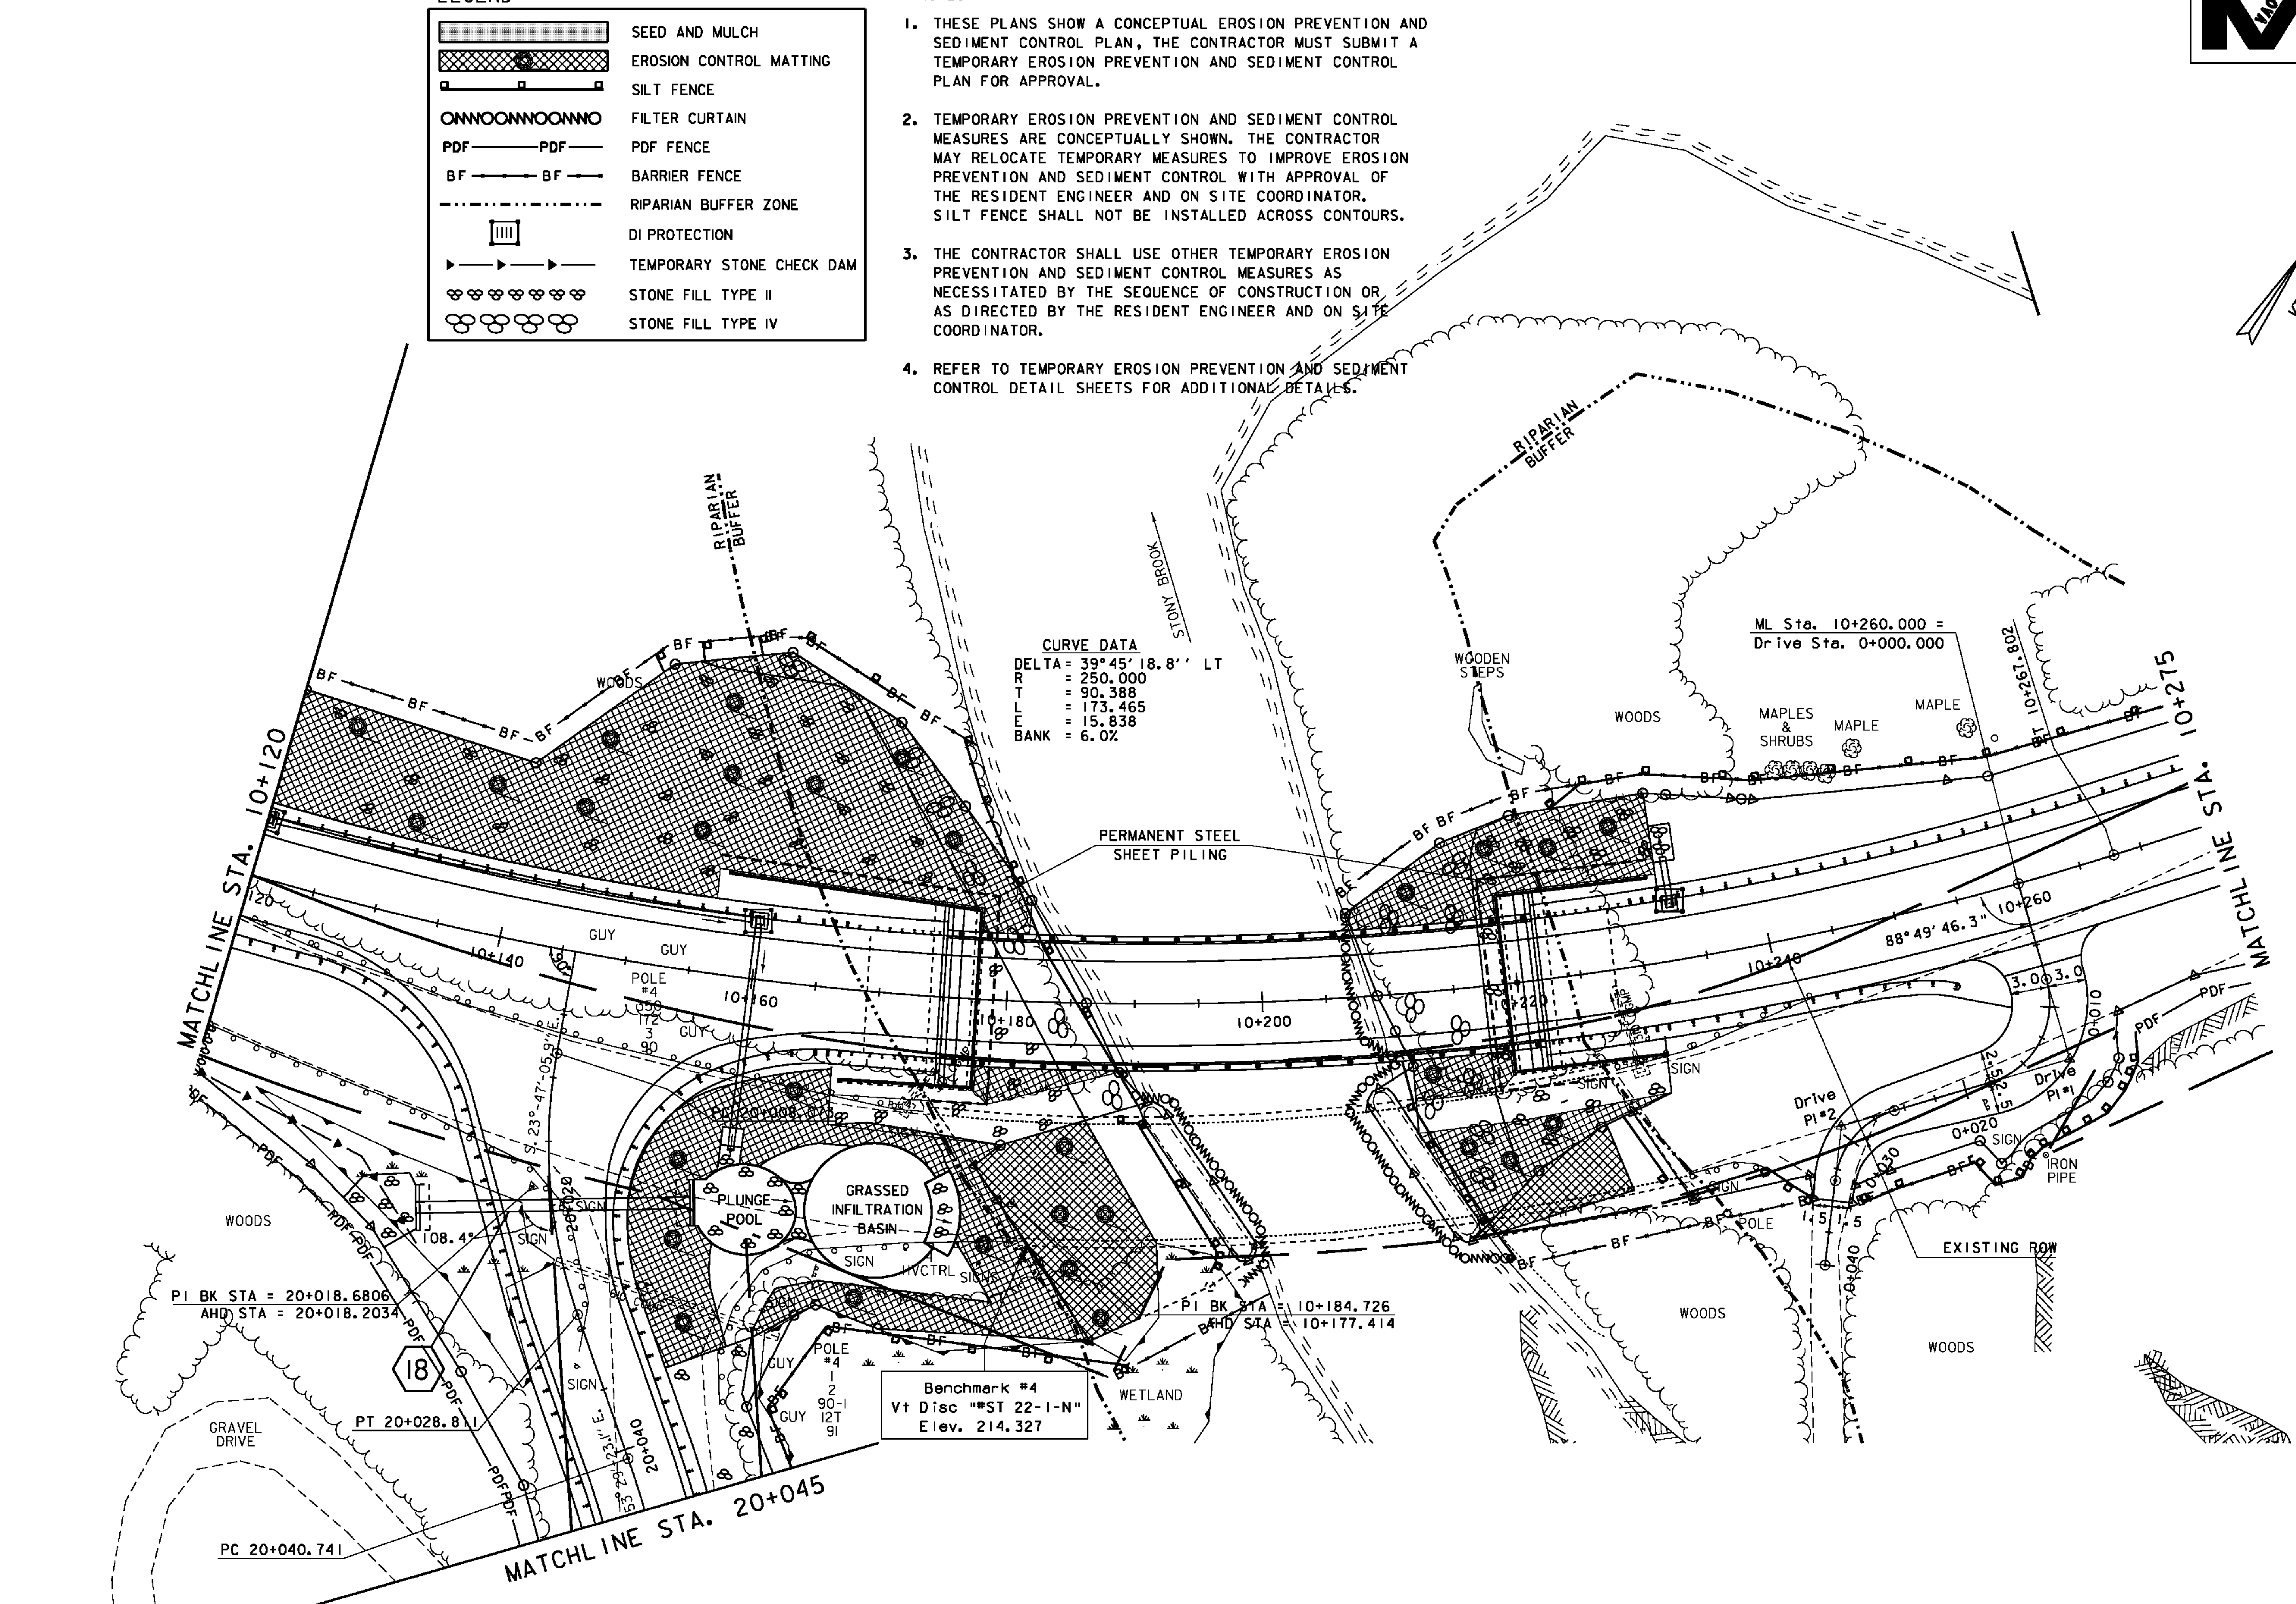

EROSION PREVENTION & SEDIMENT CONTROL PLAN - 3



PROJECT NAME:	STOCKBRIDGE
PROJECT NUMBER:	BRF 022-1 (20)
FILE NAME: /s/tr5/85e039/de039bdr.dgn	PLOT DATE: 08-APR-2010
PROJECT LEADER: C.P. Williams	DRAWN BY: M.FESSEL
DESIGNED BY: R.S.YOUNG	CHECKED BY: R.S. Young
EROSION CONTROL PLAN - LAYOUT 3	SHEET 104 OF 139