


MATCHLINE STA. 20+045

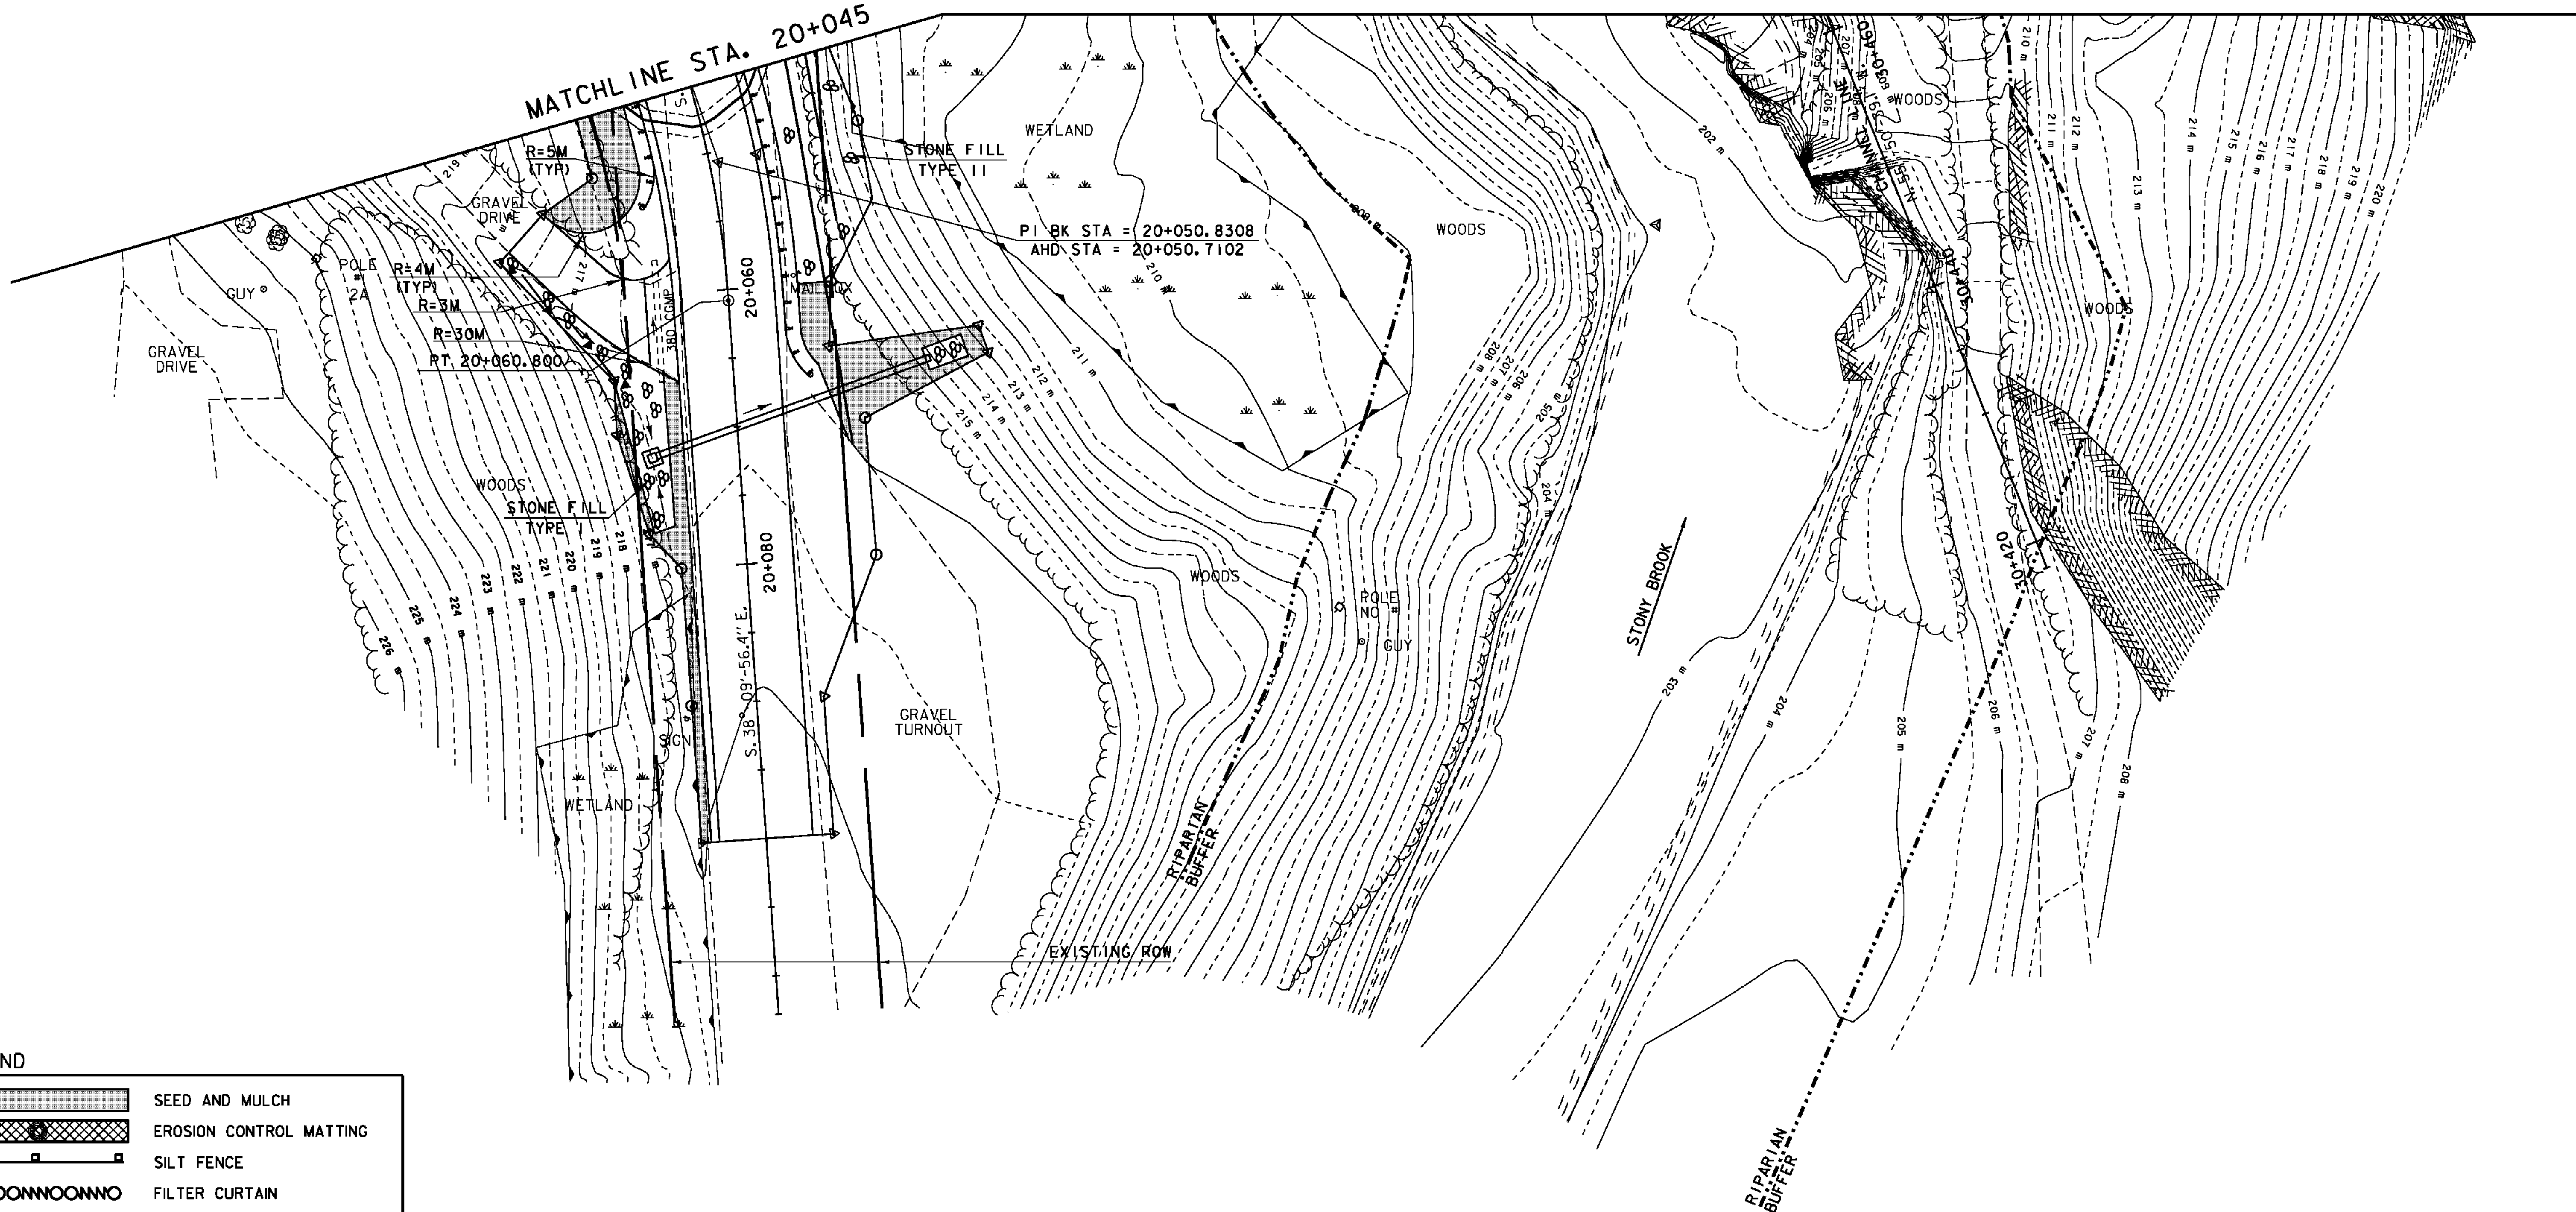

LEGEND

	SEED AND MULCH
	EROSION CONTROL MATTING
	SILT FENCE
	FILTER CURTAIN
	PDF FENCE
	BARRIER FENCE
	RIPARIAN BUFFER ZONE
	DI PROTECTION
	TEMPORARY STONE CHECK DAM
	STONE FILL TYPE II
	STONE FILL TYPE IV

FINAL CONDITIONS - LAYOUT 5



PROJECT NAME:	STOCKBRIDGE
PROJECT NUMBER:	BRF 022-1 (20)
FILE NAME: s:\str5\85e039\de039bdr.dgn	PLOT DATE: 08-APR-2010
PROJECT LEADER: C.P. Williams	DRAWN BY: M. FESSEL
DESIGNED BY: R.S. YOUNG	CHECKED BY: R.S. Young
FINAL CONDITIONS - LAYOUT 5	SHEET III OF 139