


STA 10+085 LT.  
BEGIN BITUMINOUS CONCRETE CURB  
BEGIN STONE FILL TYPE II  
BEGIN GRUBBING MATERIAL  
BEGIN GEOTEXTILE UNDER STONE FILL

SEE SHEET 12 FOR DRAINAGE FLAG DESCRIPTIONS

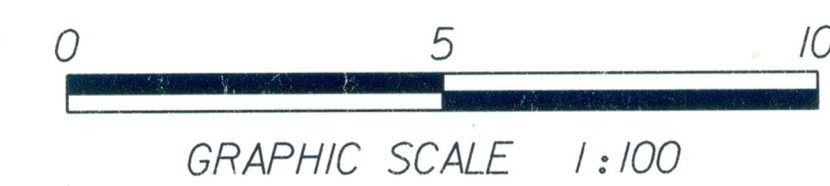

STA 10+100 TO 10+040

PROJECT NAME:	STOCKBRIDGE	FILE NAME:	/srtf5/85e039/de039xsl.dgn	PLOT DATE:	08-APR-2010
PROJECT NUMBER:	BRF 022-(120)	PROJECT LEADER:	C.P. Williams	DRAWN BY:	G. Shangraw
		DESIGNED BY:	G. Shangraw	CHECKED BY:	R.S. Young
		MAINLINE CROSS SECTIONS 3		SHEET	119 OF 139