


STA 10+152.3 LT.
BEGIN STONE FILL TYPE IV

STA 10+160.100
C OF DROP INLET AND PIPE

STA 10+166.500 RT.
BEGIN STONE FILL TYPE II
BEGIN GEOTEXTILE UNDER STONE FILL

SEE MSE WALL #1 FOR STA 10+157.154
URS 7-14-11

DWB
8/09/12

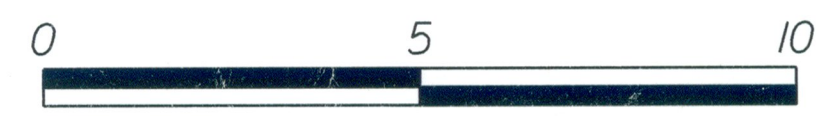

GRAPHIC SCALE 1:100

STA 10+160

SEE SHEET 12 FOR DRAINAGE FLAG DESCRIPTIONS

PROJECT NAME: STOCKBRIDGE	PLOT DATE: 08-APR-2010
PROJECT NUMBER: BRF 022-I(20)	DRAWN BY: G. Shangraw
FILE NAME: /sr/t5/85e039/de039xsl.dgn	CHECKED BY: R.S. Young
PROJECT LEADER: C.P. Williams	SHEET 120 OF 139
DESIGNED BY: G. Shangraw	
MAINLINE CROSS SECTIONS 4	