

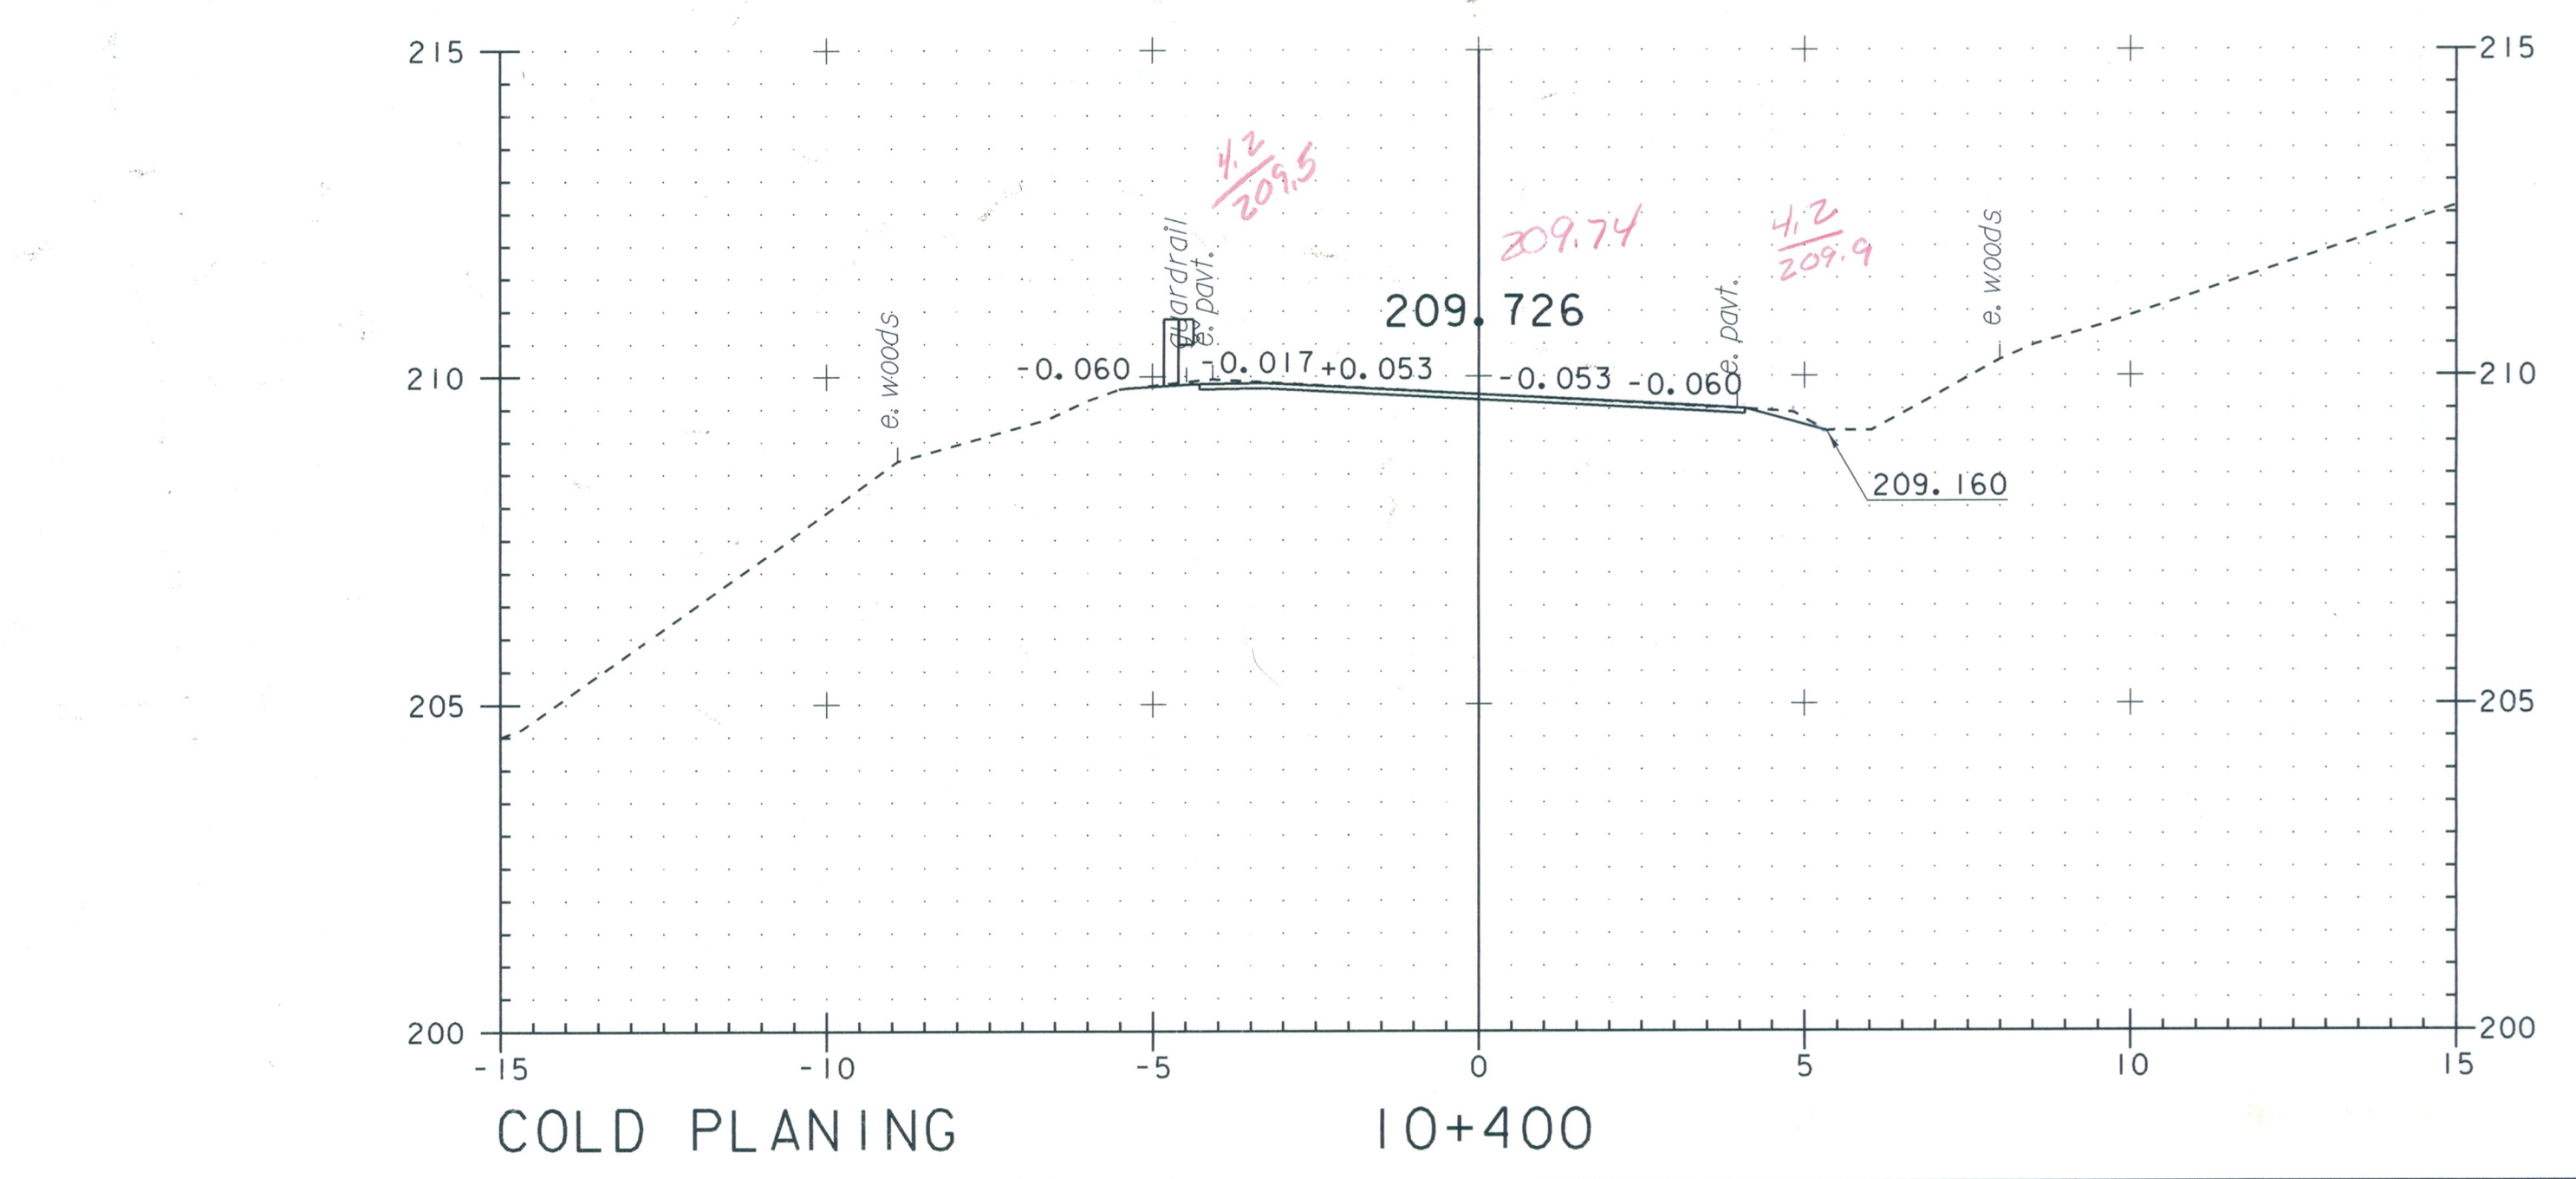
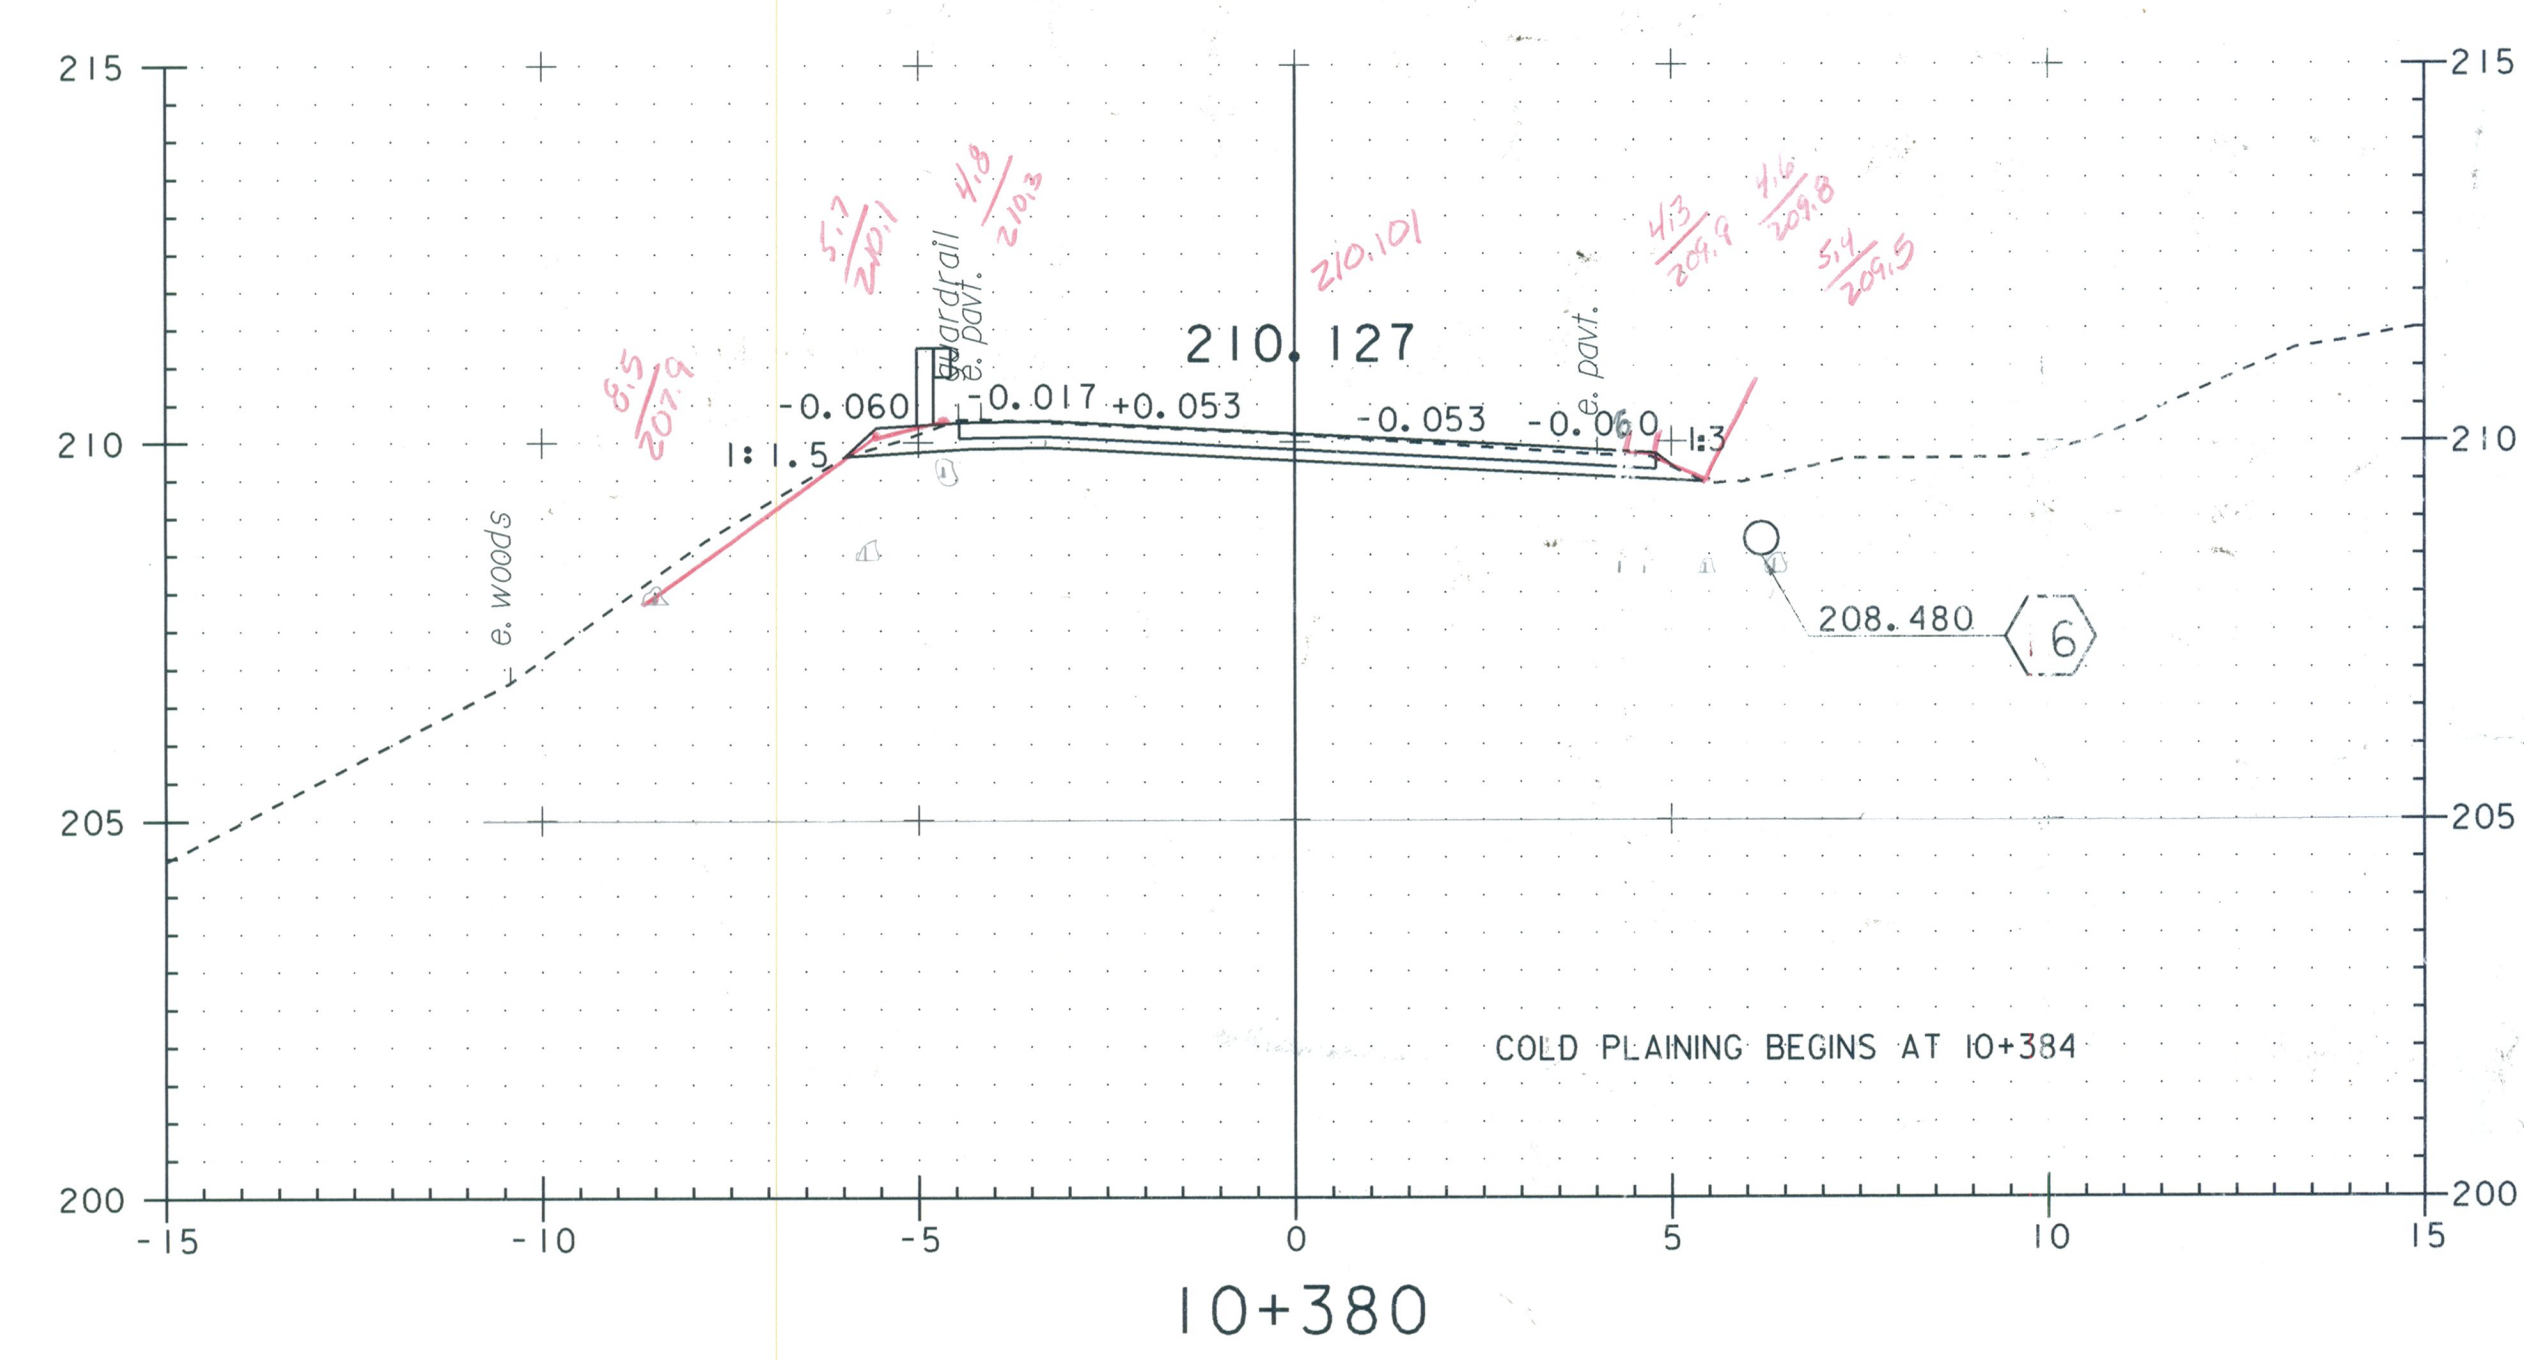
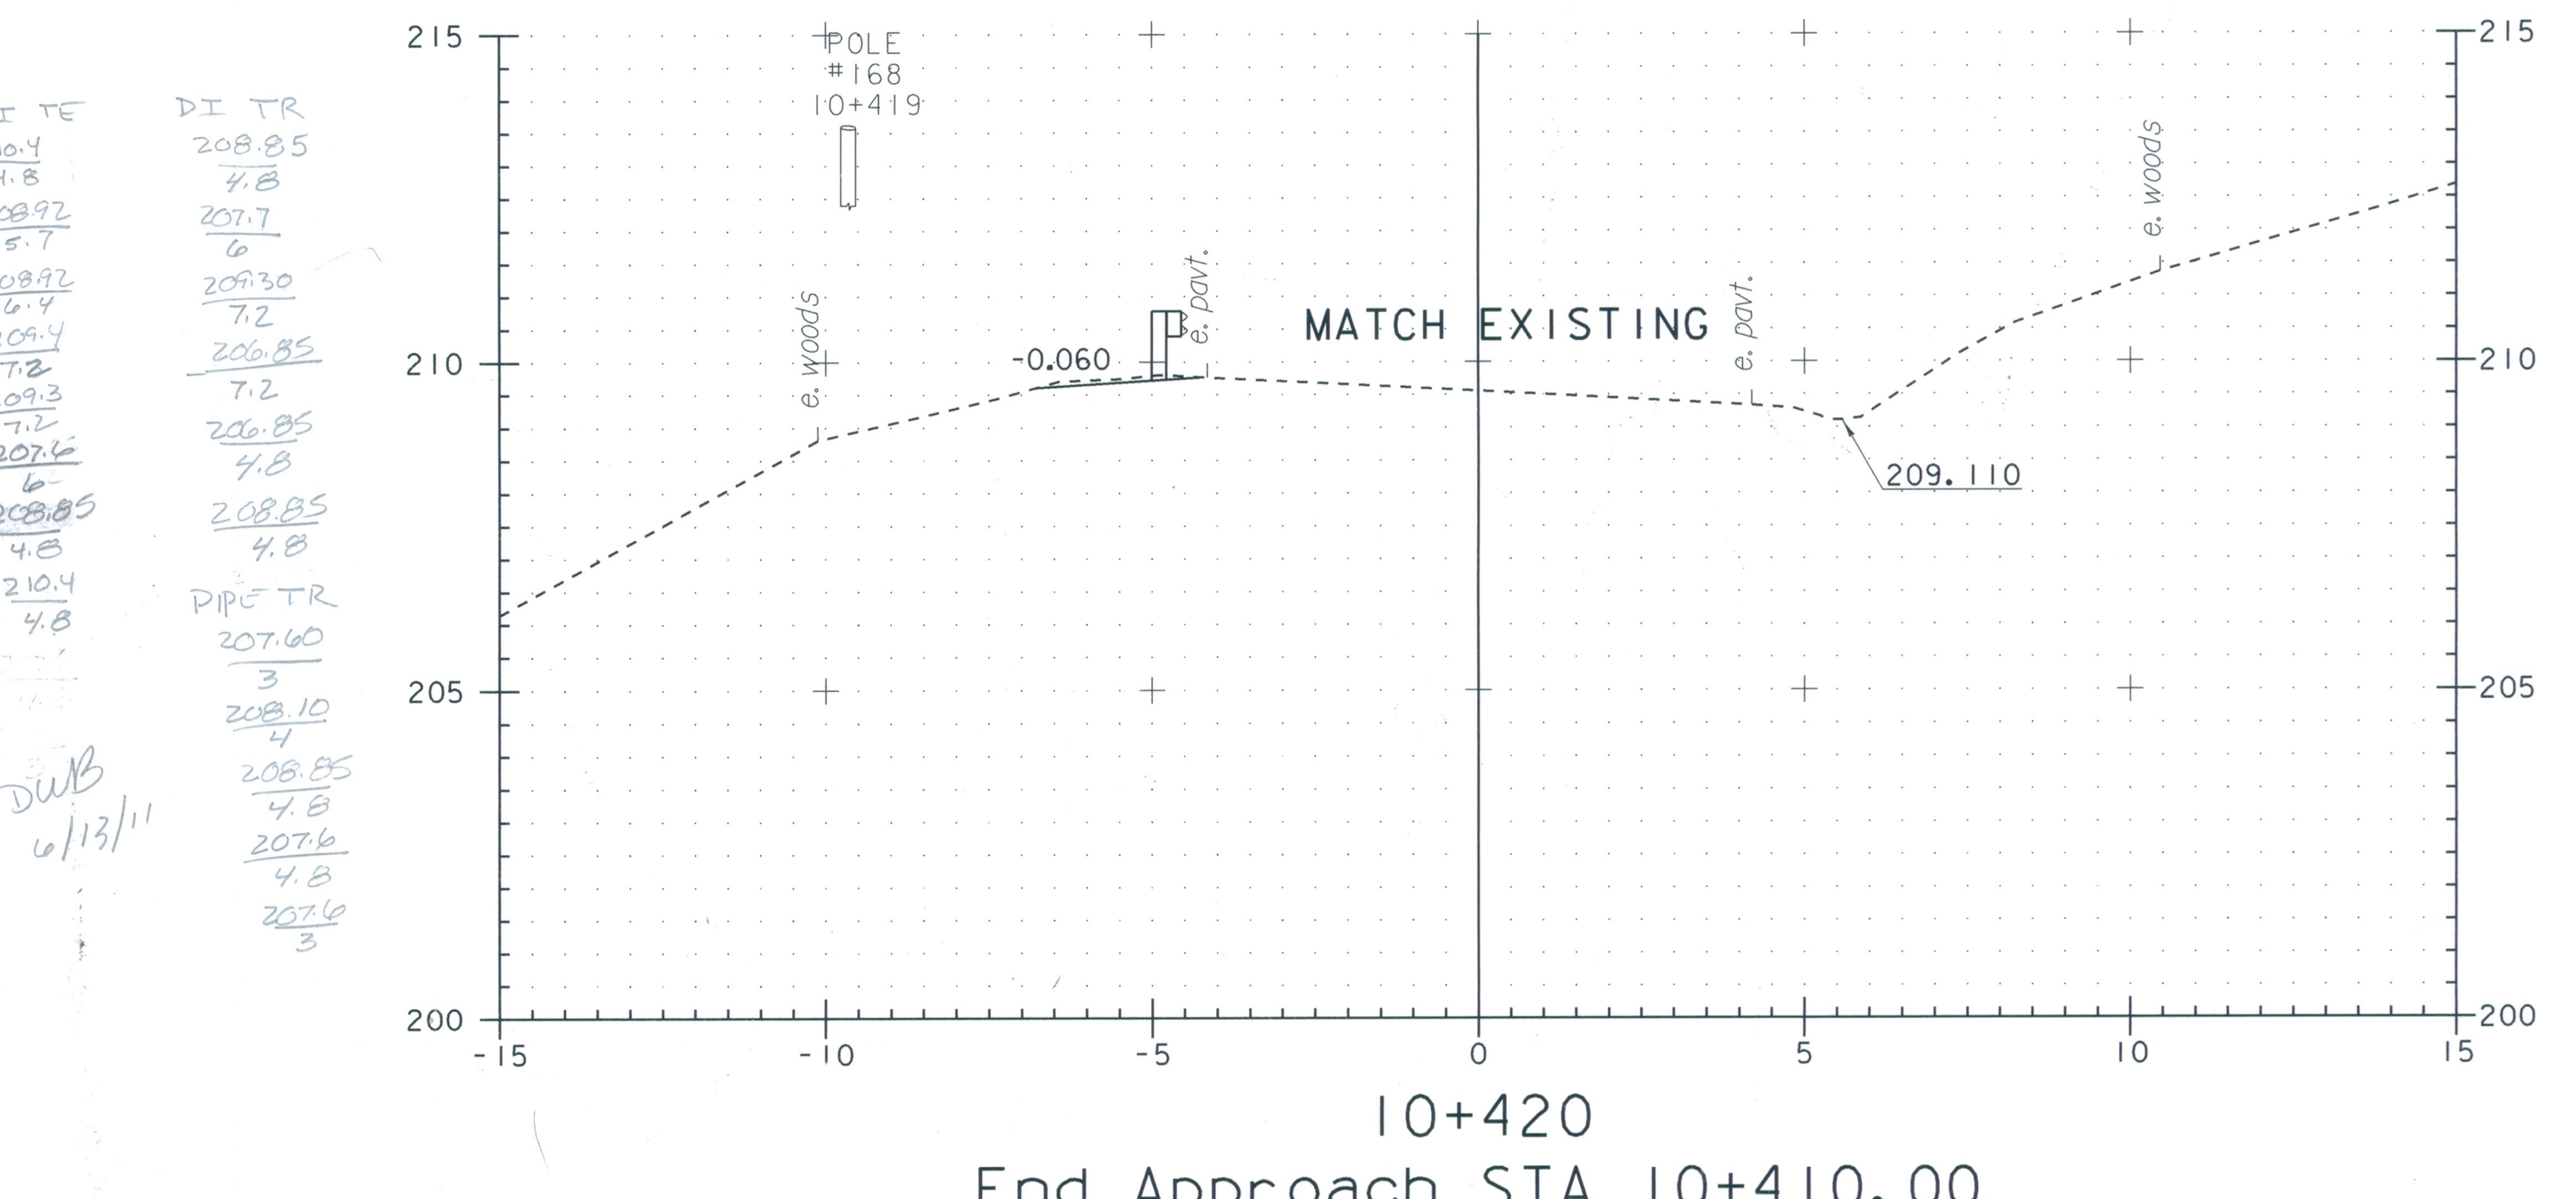
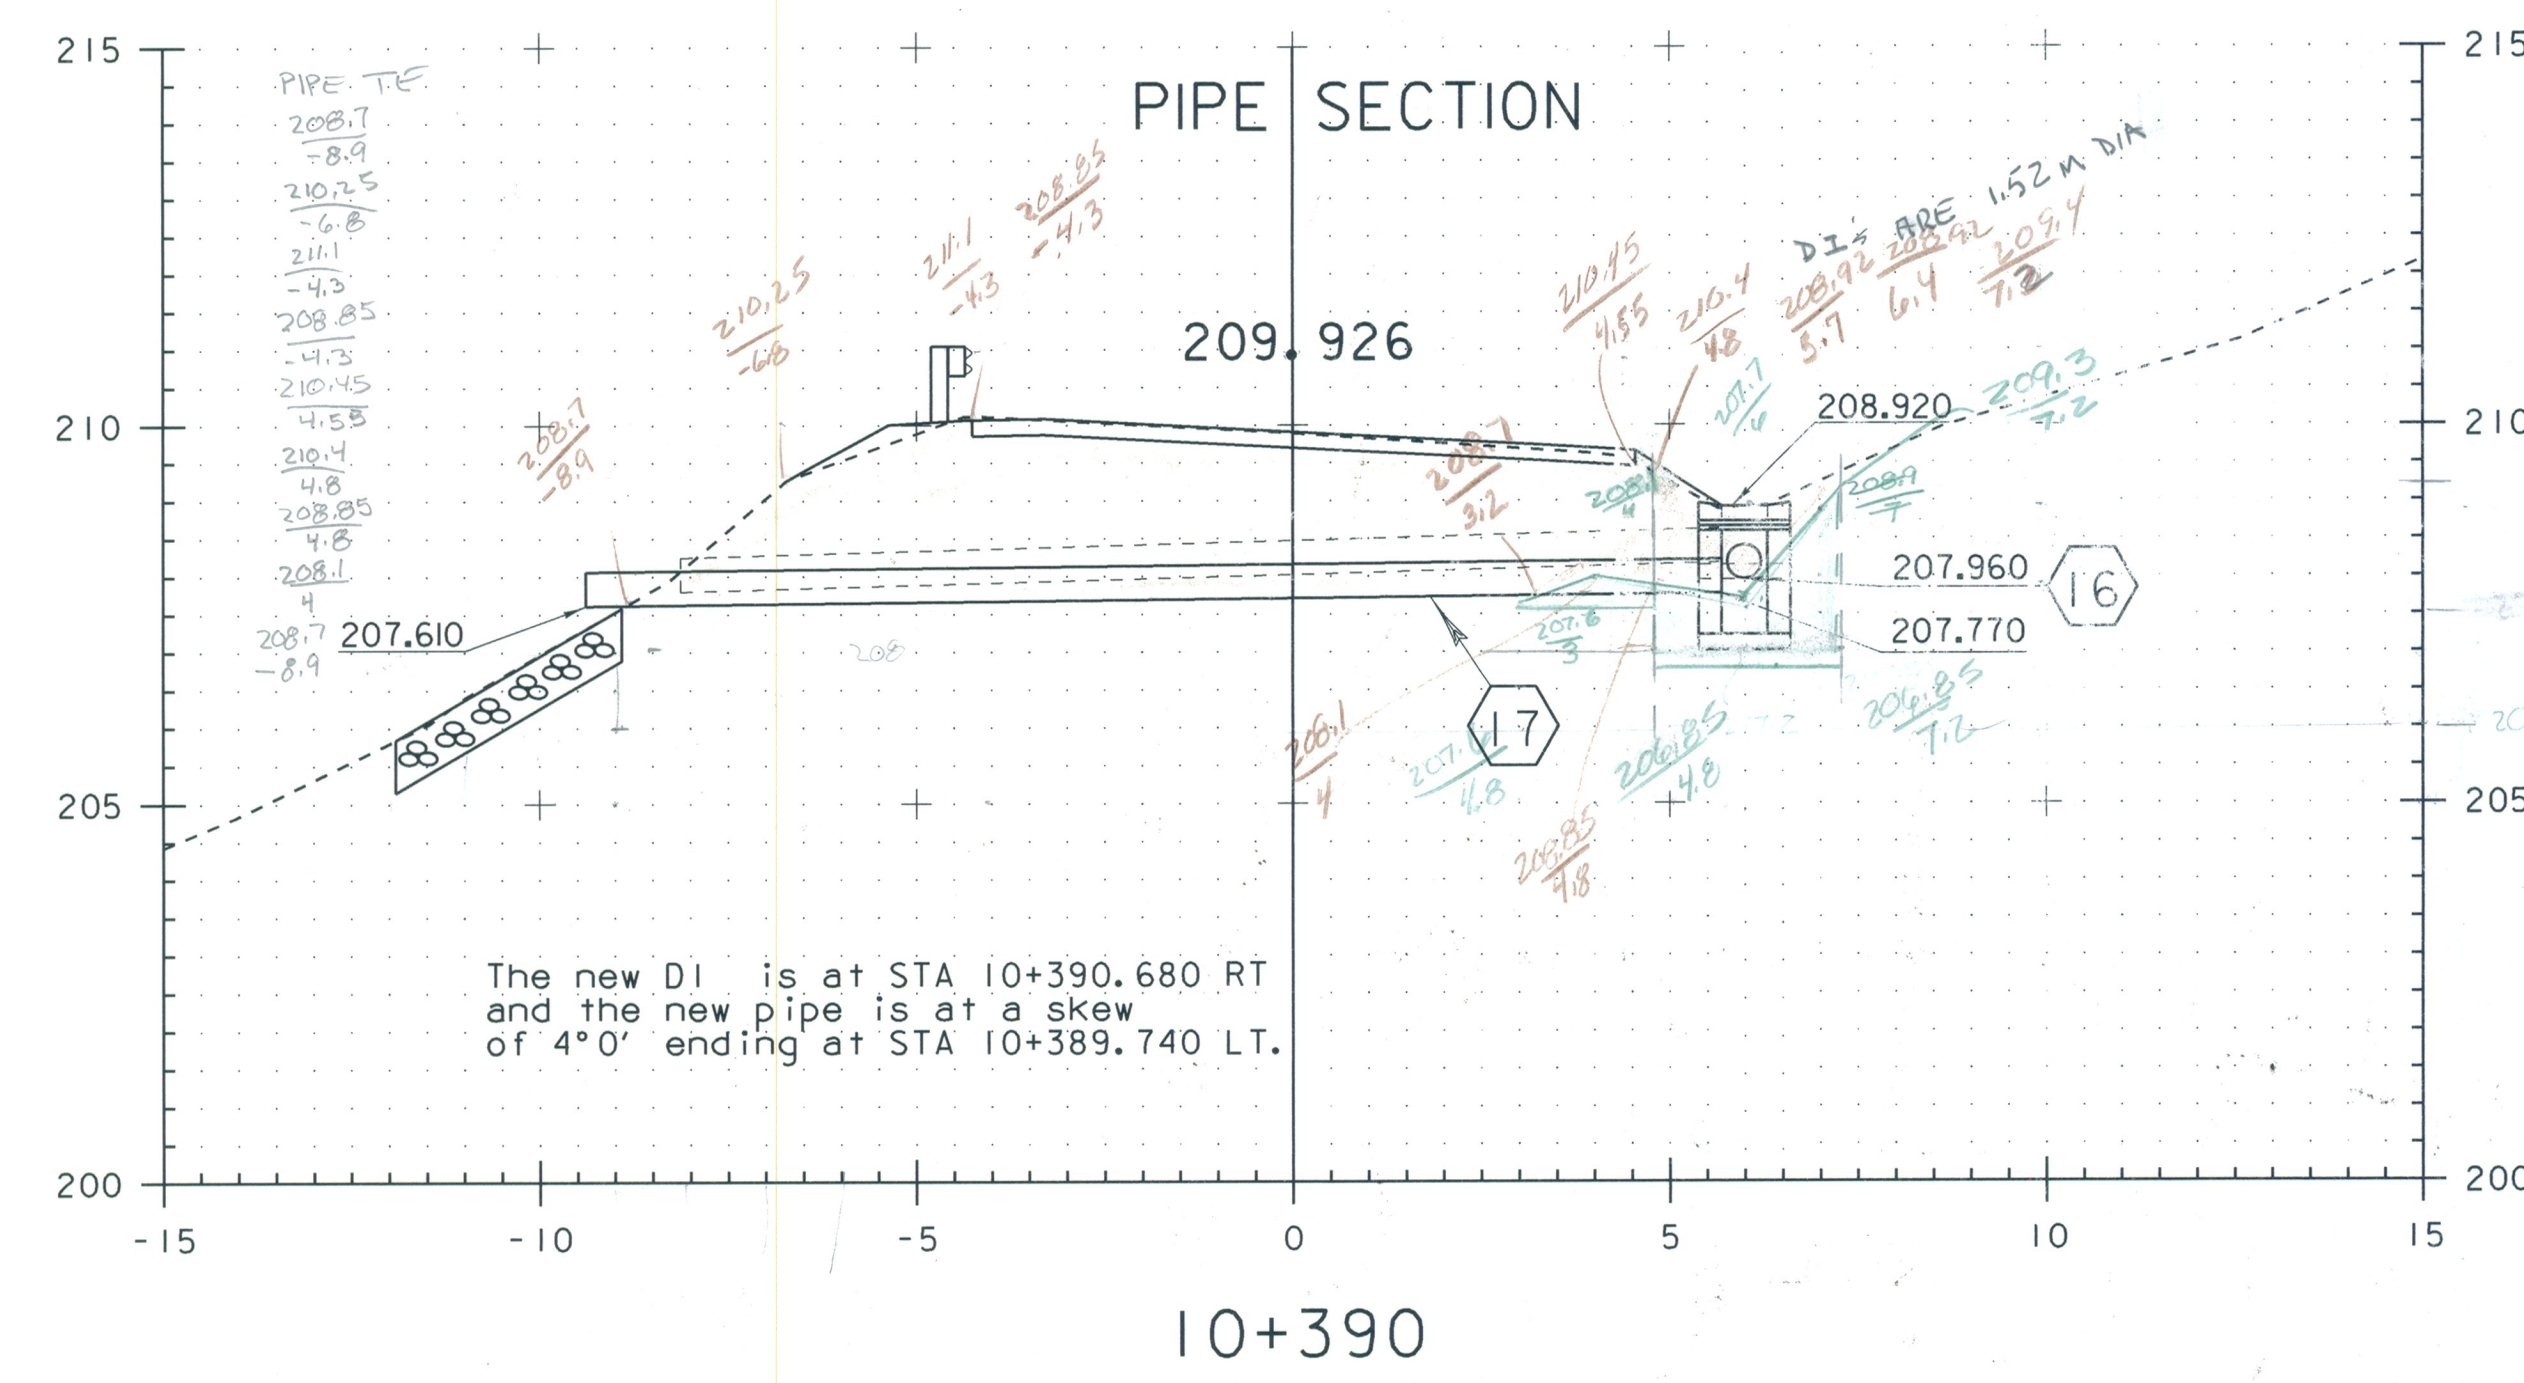


### Ditch Profile

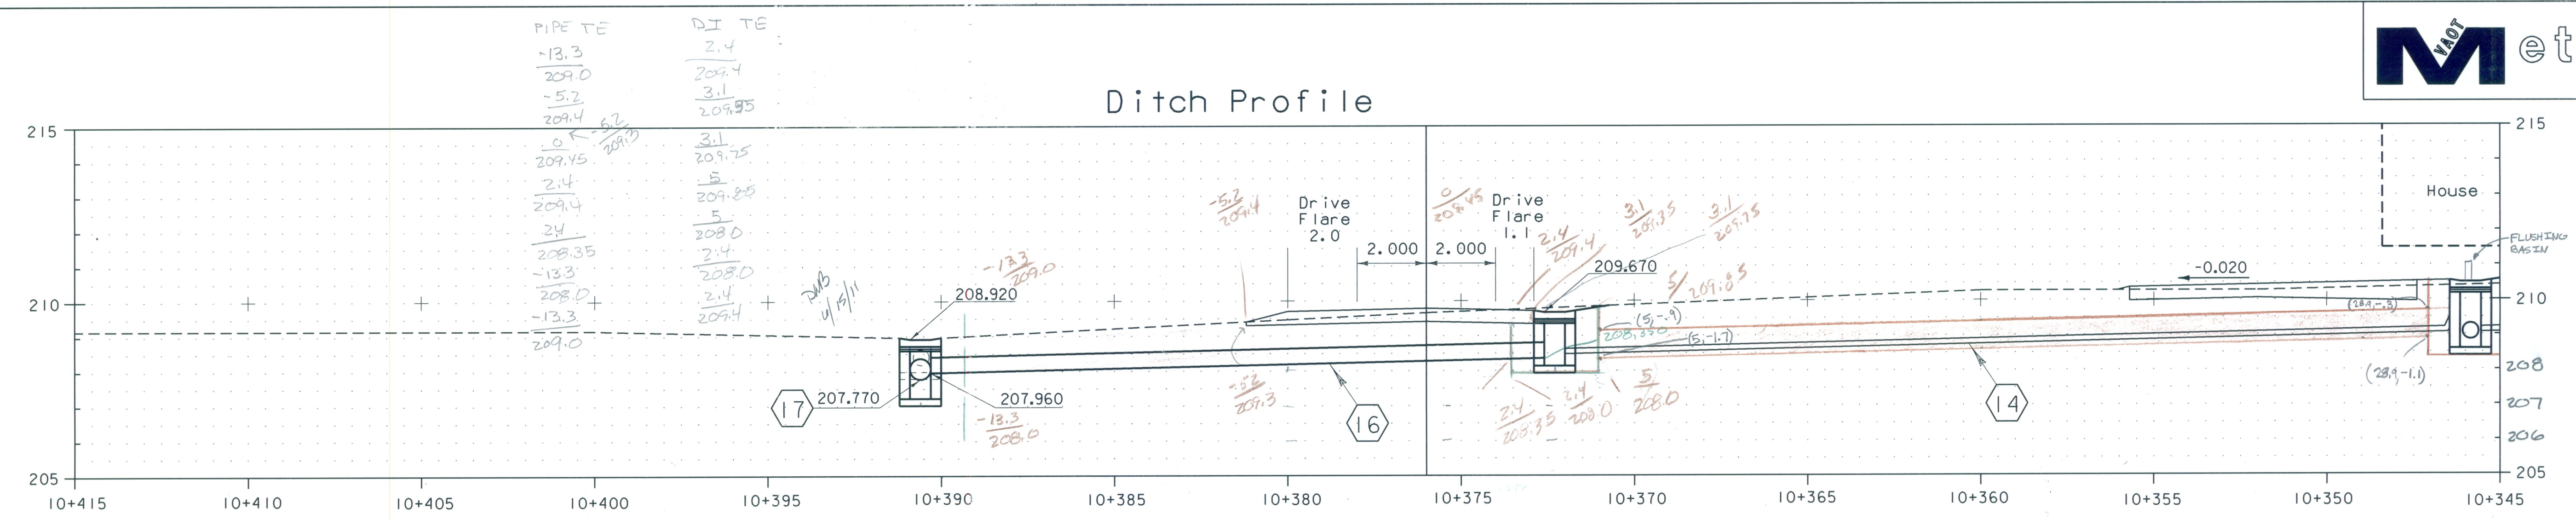

SEE SHEET 12 FOR DRAINAGE FLAG DESCRIPTIONS

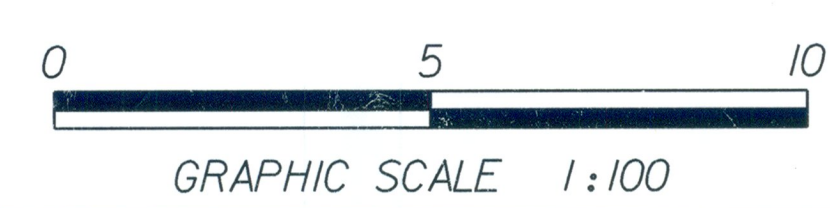

STA 10+380 TO 10+420

PROJECT NAME:	STOCKBRIDGE	PLOT DATE:	08-APR-2010
PROJECT NUMBER:	BRF 022-1(20)	DRAWN BY:	G. Shangraw
FILE NAME:	/srt5/85e039/de039xsl.dgn	CHECKED BY:	R.S. Young
PROJECT LEADER:	C.P. Williams	SHEET	125 OF 139
DESIGNED BY:	G. Shangraw	MAINLINE CROSS SECTIONS	9