


SEE SHEET 12 FOR DRAINAGE FLAG DESCRIPTIONS

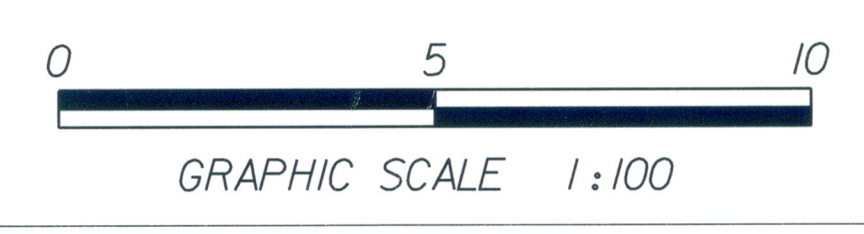

STA 20+000 TO 20+005

PROJECT NAME: STOCKBRIDGE	PLOT DATE: 08-APR-2010
PROJECT NUMBER: BRF 022-1(20)	DRAWN BY: G. Shangraw
FILE NAME: /sr+5/85e039/de039xsl.dgn	CHECKED BY: R.S. Young
PROJECT LEADER: C.P. Williams	SHEET 126 OF 139
DESIGNED BY: G. Shangraw	