



STA 20+060 LT.  
 END STONE FILL TYPE II  
 END GEOTEXTILE FOR STONE FILL  
 END GRUBBING MATERIAL

STA 20+055 RT.  
 BEGIN STONE FILL TYPE I  
 BEGIN GEOTEXTILE FOR STONE FILL  
 BEGIN GRUBBING MATERIAL

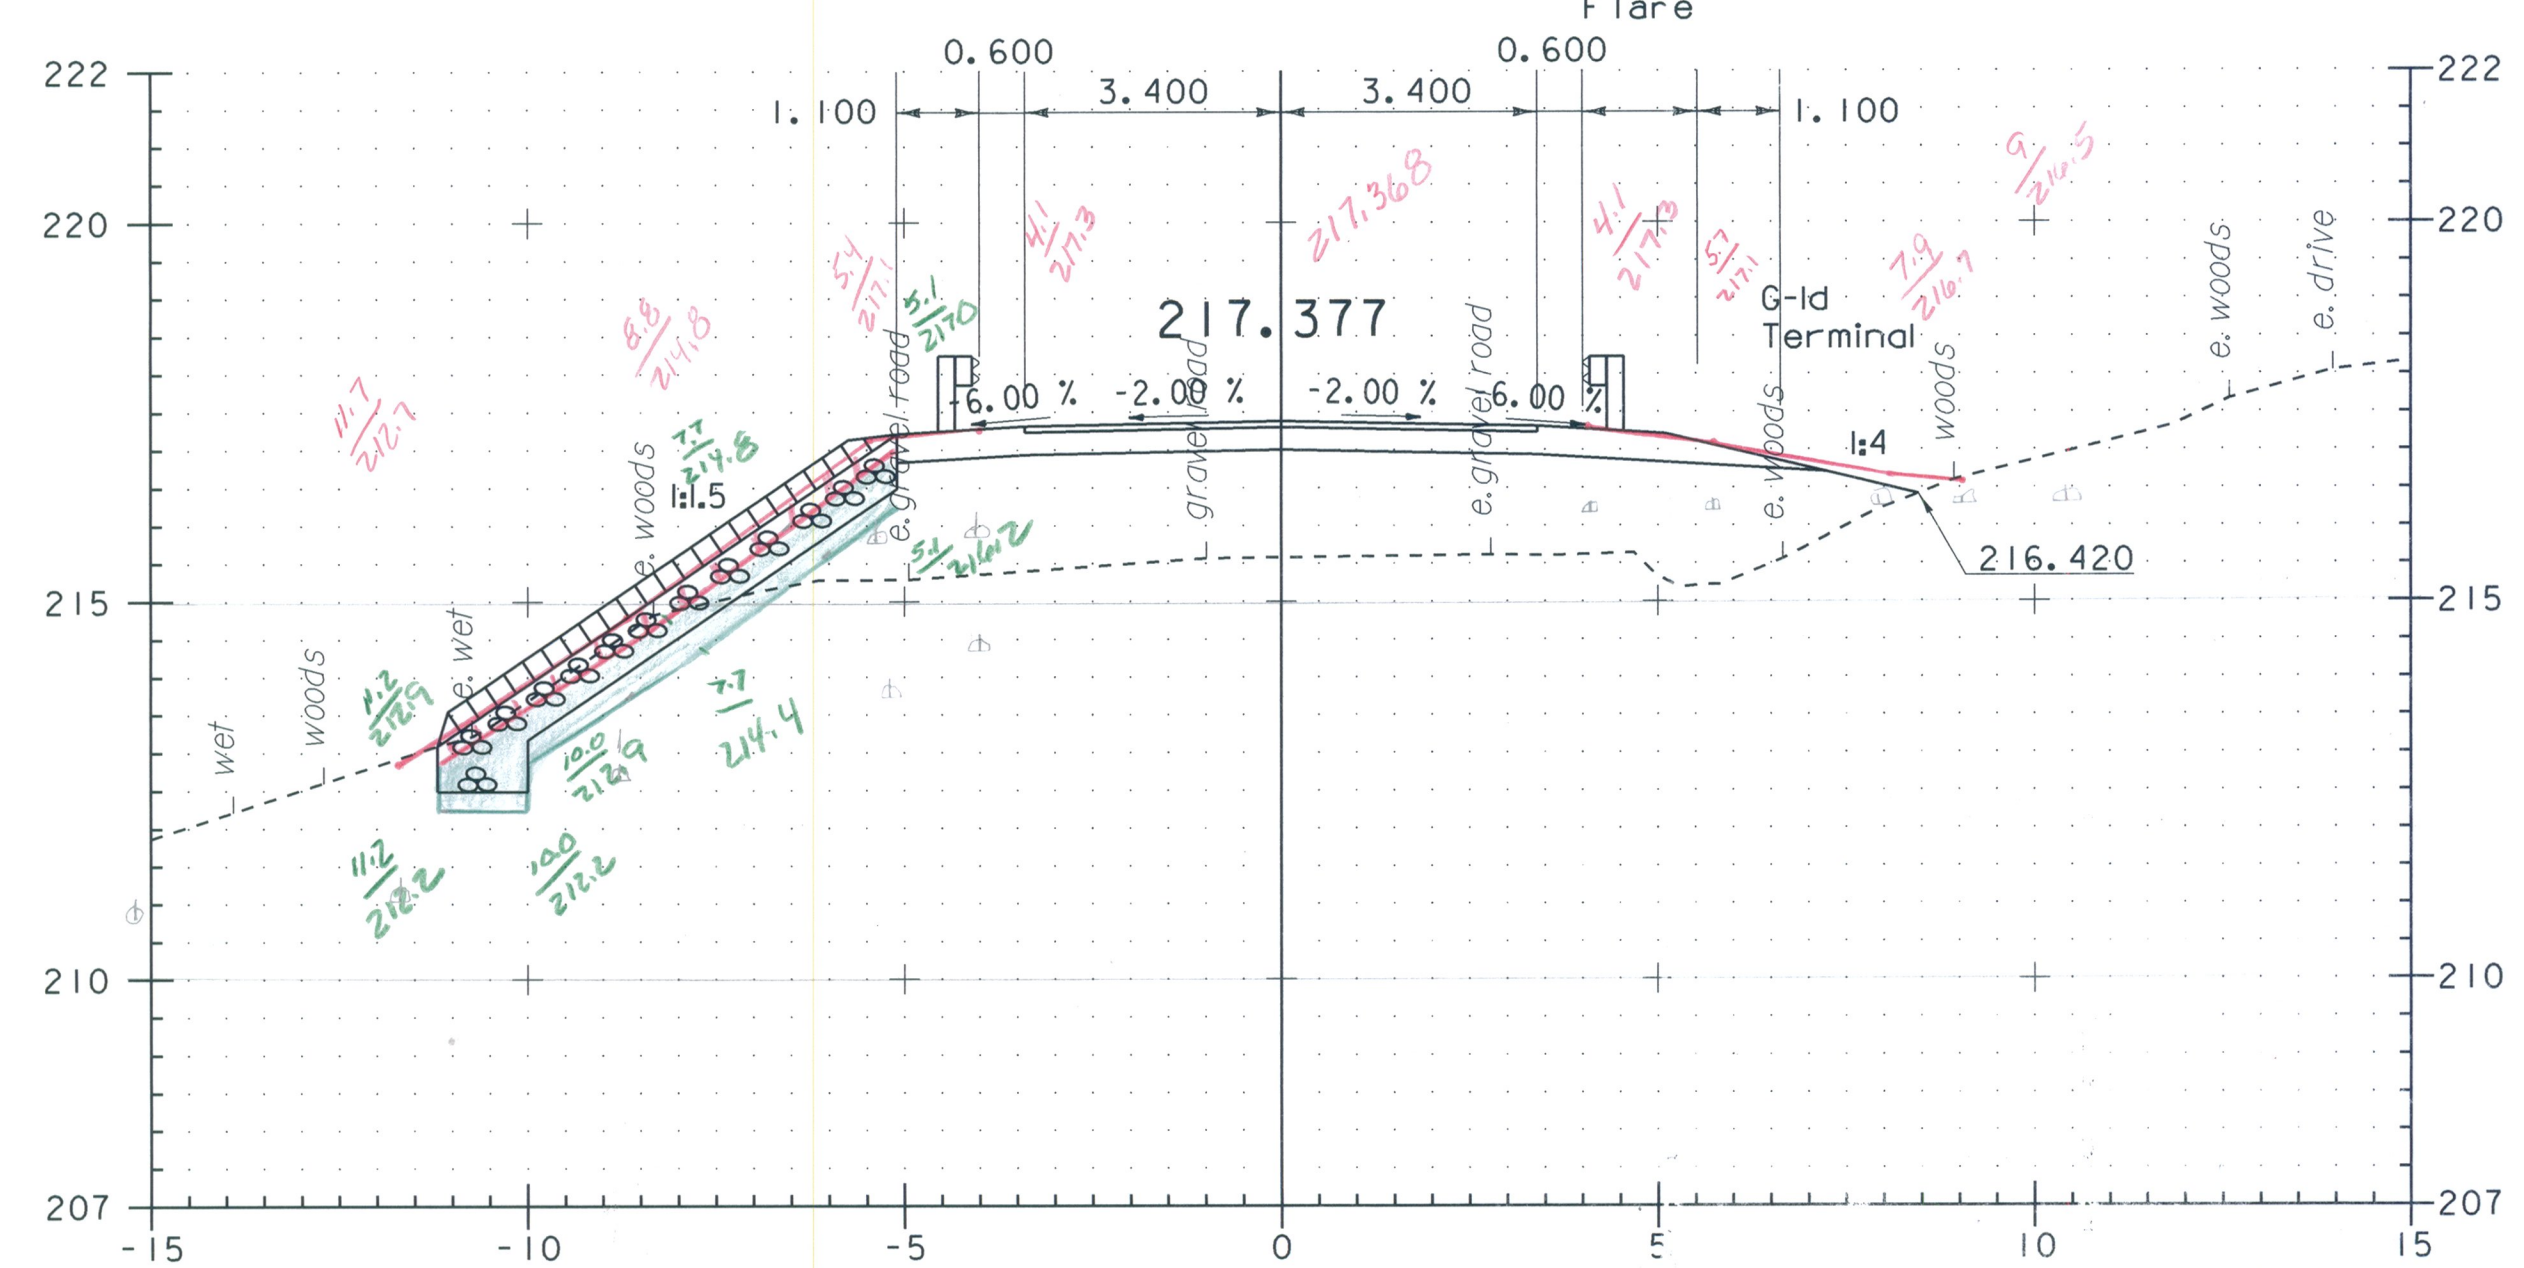


20+050

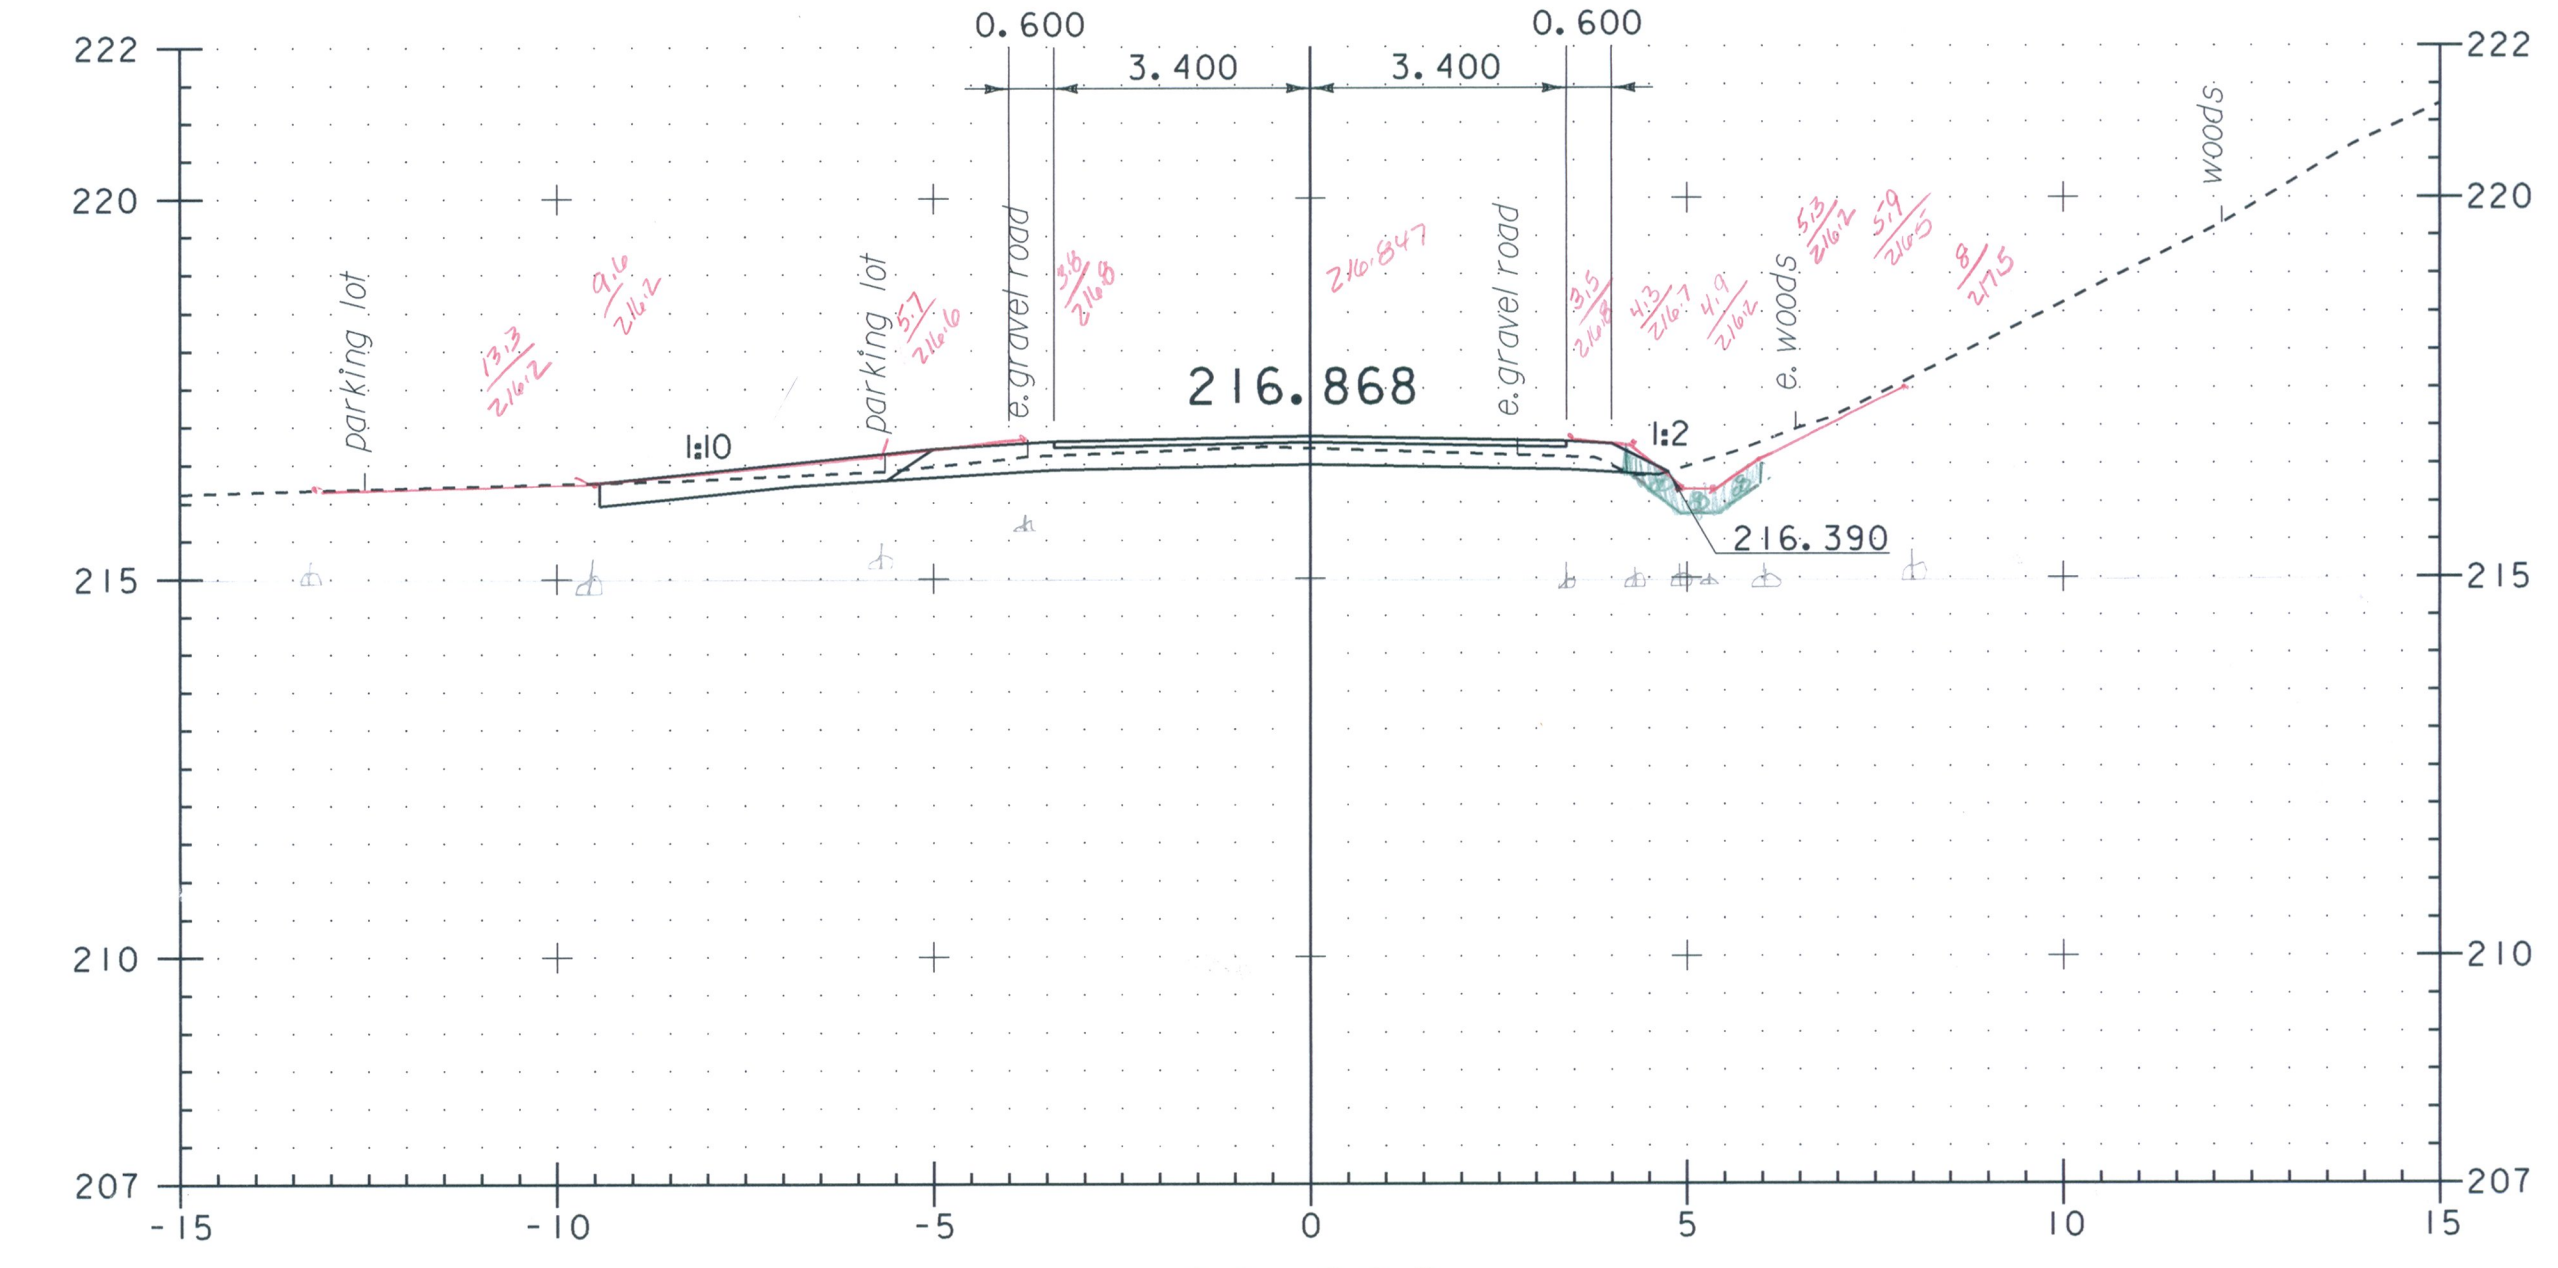


20+080

STA 20+077 RT.  
 END STONE FILL TYPE I  
 END GEOTEXTILE FOR STONE FILL  
 END GRUBBING MATERIAL

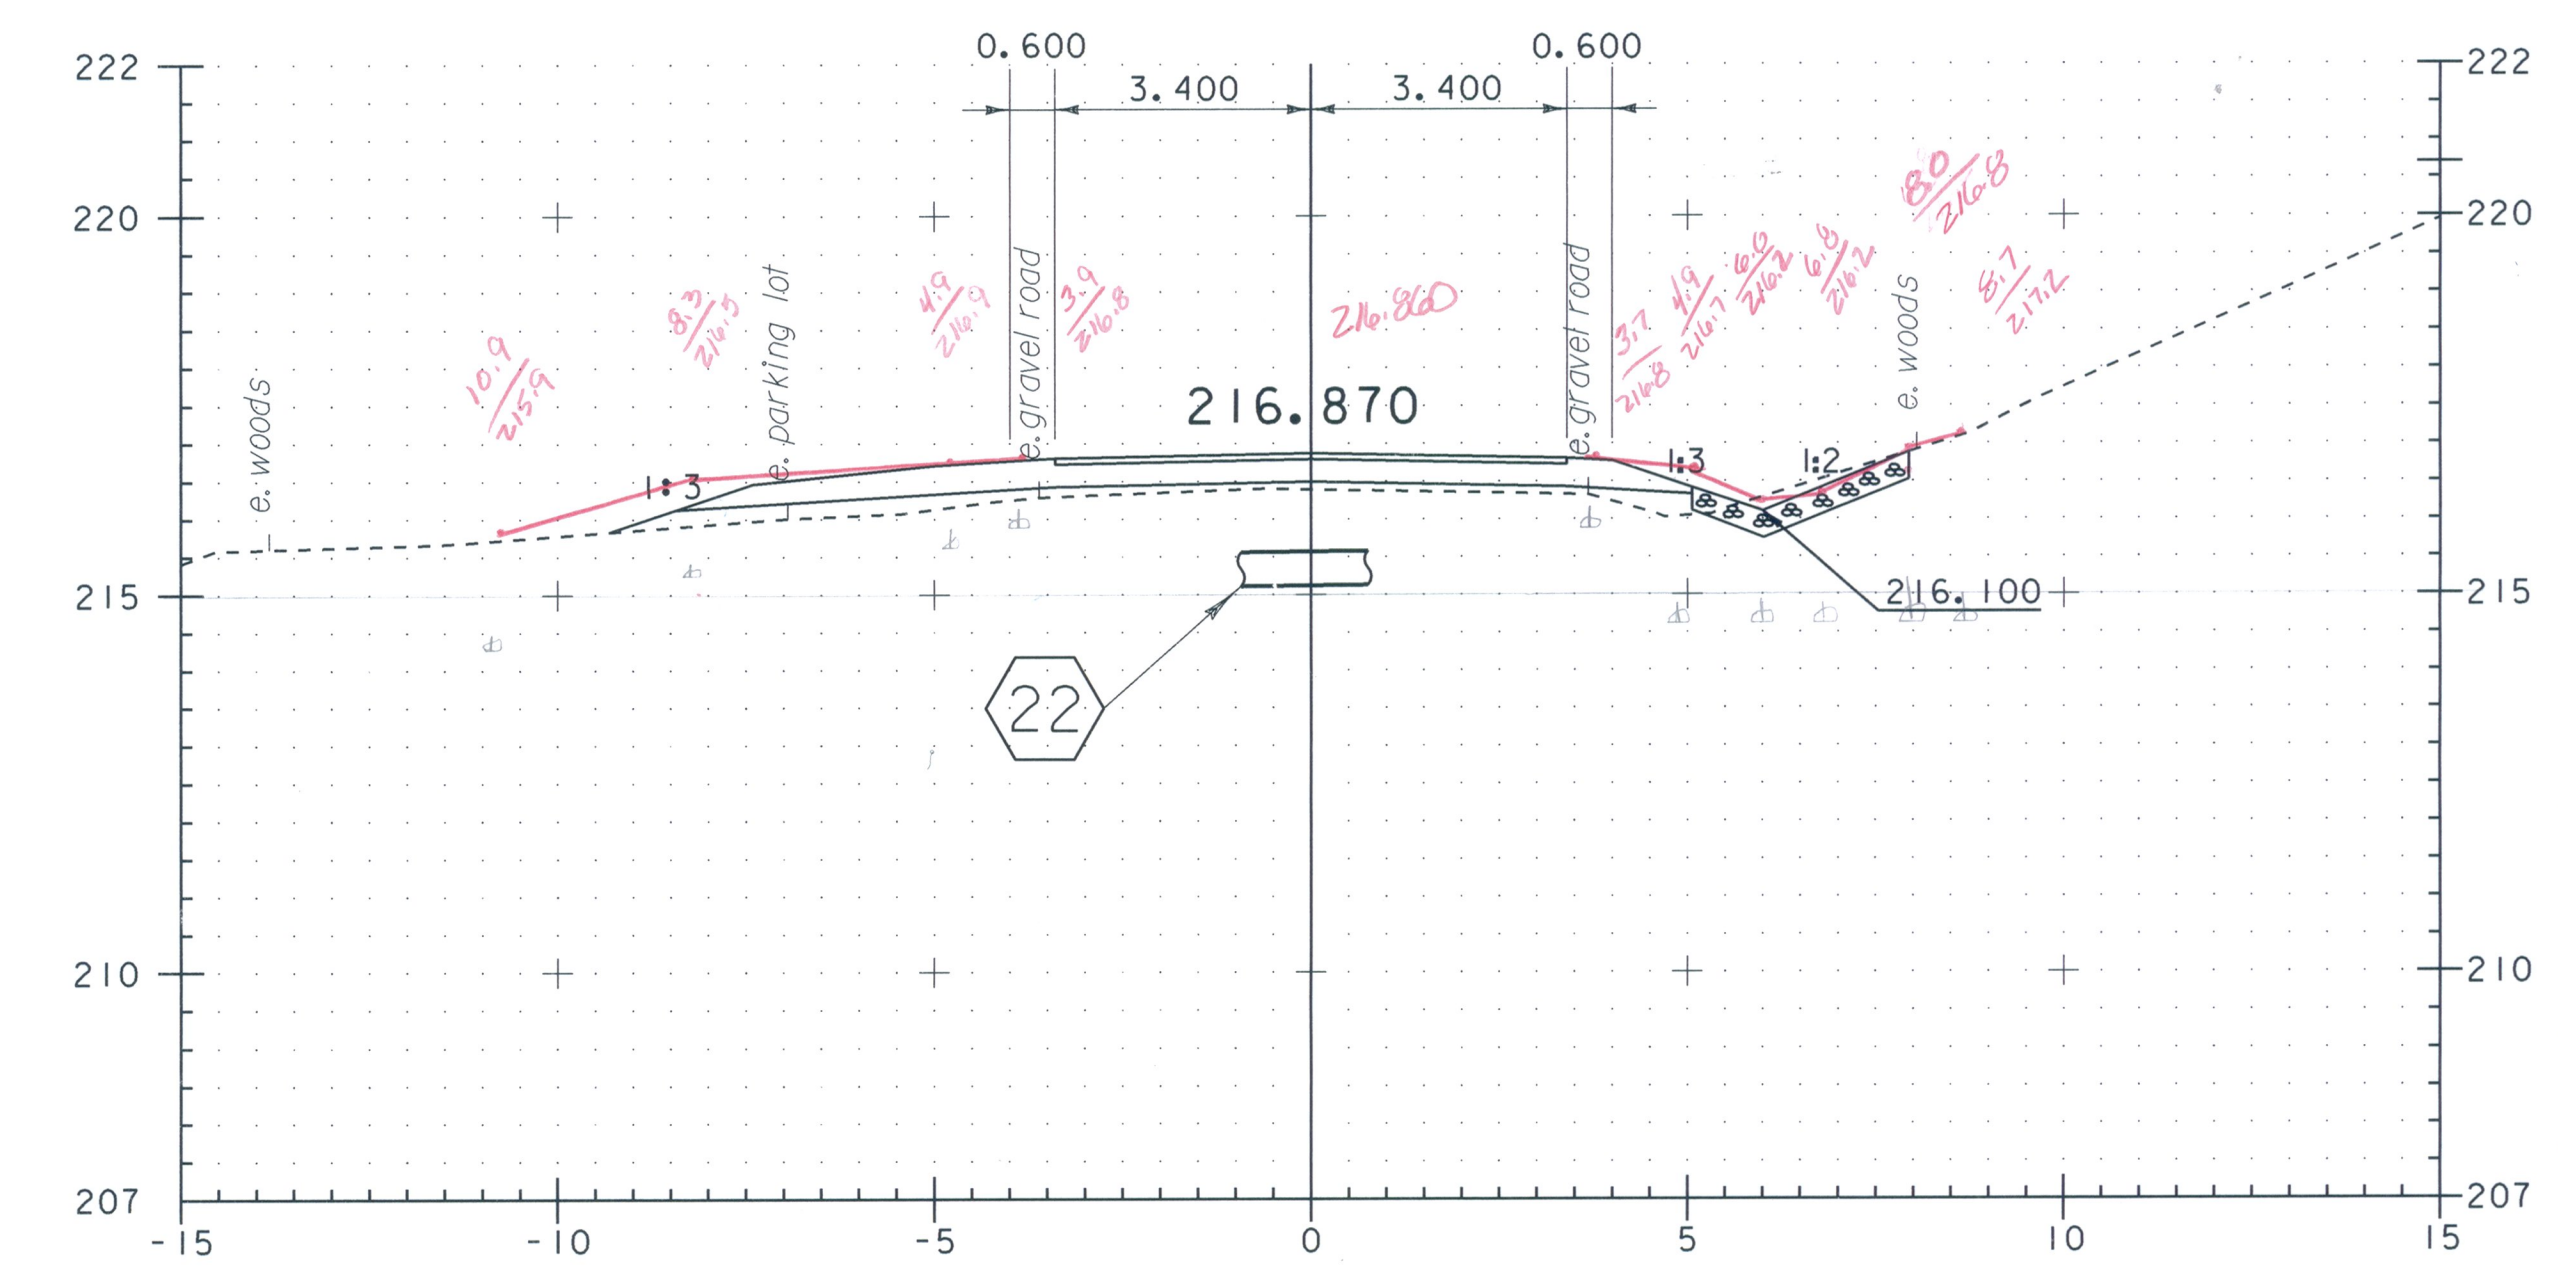

20+070

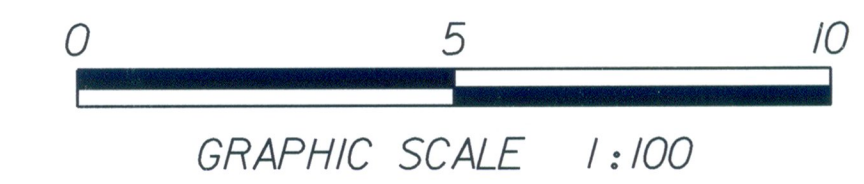

STA 20+050 TO 20+080

SEE SHEET 12 FOR DRAINAGE FLAG DESCRIPTIONS

PROJECT NAME:	STOCKBRIDGE	PLOT DATE:	08-APR-2010
PROJECT NUMBER:	BRF 022-1(20)	DRAWN BY:	G. Shangraw
FILE NAME:	/sr15/85e039/de039xsl.dgn	DESIGNED BY:	G. Shangraw
PROJECT LEADER:	C.P. Williams	CHECKED BY:	R.S. Young
STONY BROOK ROAD CROSS SECTIONS 3			SHEET 128 OF 139