


TE PIPE	TE DI
-14.1	5.4
215.0	216.2
-1.3	7.8
215.5	216.8
-3.8	7.8
216.2	214.7
-0.8	5.4
216.4	214.7
3.8	5.4
216.3	216.2
5	
216.1	
5.4	
216.2	
5.4	
215.1	
-14.1	
215.0	

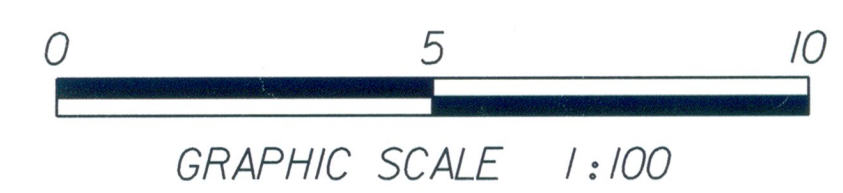

PROJECT NAME: STOCKBRIDGE  
PROJECT NUMBER: BRF 022-1(20)

FILE NAME: /sr+5/85e039/de039xsl.dgn PLOT DATE: 08-APR-2010  
PROJECT LEADER: C.P. Williams DRAWN BY: G. Shangraw  
DESIGNED BY: G. Shangraw CHECKED BY: R.S. Young  
STONY BROOK ROAD CROSS SECTIONS 4 SHEET 129 OF 139

SEE SHEET 12 FOR DRAINAGE FLAG DESCRIPTIONS

STA 20+070 TO 20+100