


30+502.0 LT
 BEGIN UNCLASSIFIED CHANNEL EXCAVATION
 BEGIN GEOTEXTILE UNDER STONE FILL
 BEGIN STONE FILL TYPE II
 BEGIN GRUBBING MATERIAL

30+502.5 LT
 BEGIN STONE FILL TYPE IV

30+510

30+512.4 RT
 END UNCLASSIFIED CHANNEL EXCAVATION
 END GEOTEXTILE UNDER STONE FILL
 END STONE FILL TYPE II
 END STONE FILL TYPE IV
 END GRUBBING MATERIAL

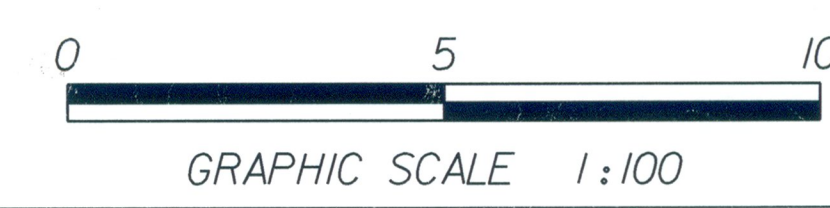

PROJECT NAME:	STOCKBRIDGE	FILE NAME:	/sr+f5/85e039/de039xsl.dgn	PLOT DATE:	08-APR-2010
PROJECT NUMBER:	BRF 022-1(20)	PROJECT LEADER:	C.P. Williams	DRAWN BY:	G. Shangraw
		DESIGNED BY:	G. Shangraw	CHECKED BY:	R.S. Young
		CHANNEL CROSS SECTIONS:	6	SHEET:	136 OF 139