


PLAN VIEW
 ABUTMENT Nos. 1 & 2
 (TEMPORARY SURCHARGE)
 SCALE: 1:100

CURVE DATA
 A=3042.18' LT
 R=250.00m
 T=90.388
 L=173.465
 L1=10.358
 PI AND STA=10+177.414
 PI BK STA=10+184.728

RECEIVED
 CK'D BY: [Signature] DATE: 8/16/10
 RESUBMIT APPROVED [Signature] DATE: 8/26/10

- NOTES:
 1. STATIONS & OFFSETS GIVEN AT FRONT FACE OF MSE WALL FACING.
 2. MSE WALL LAYOUT INFORMATION WERE BASED ON CONTRACT SHEET Nos. 70 & 71 OF 139.
 3. CONTRACTOR TO VERIFY ALL WORKING POINTS.

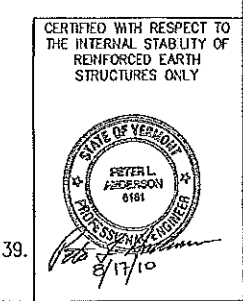

ALL DIMENSIONS ARE IN METERS
 UNLESS NOTED OTHERWISE

<p>This drawing contains information proprietary to The Reinforced Earth Company, and is being furnished for the use of VERMONT AGENCY OF TRANSPORTATION only in connection with this project, and the information contained is not to be transmitted to any other organization unless specifically authorized in writing by The Reinforced Earth Company. The Reinforced Earth Company is a registered trademark of The Reinforced Earth Company.</p>		<p>DESIGNER: MS PROJECT ENGINEER: LY CHECKED BY: LY DATE: 8/16/10</p>		<p>PROJECT NAME: VT ROUTE 107, BRIDGE 9 LOCATION: STOCKBRIDGE, VERMONT OWNER: VERMONT AGENCY OF TRANSPORTATION</p>		<p>DATE: 07/16/2010 CONTRACT NO.: RE-14897 DRAWING NO.: 3 OF 16 SCALE: AS SHOWN</p>	
<p>REINFORCED EARTH™ is the registered trademark of The Reinforced Earth Company.</p>		<p>REINFORCED EARTH™</p>		<p>DESCRIPTION: BEND TEMPORARY WALL ADJUST WALL LENGTH</p>		<p>TEMPORARY SURCHARGE</p>	