


ELEVATION - TEMPORARY SURCHARGE WALL @ ABUTMENT 2

SCALE = 1 : 100

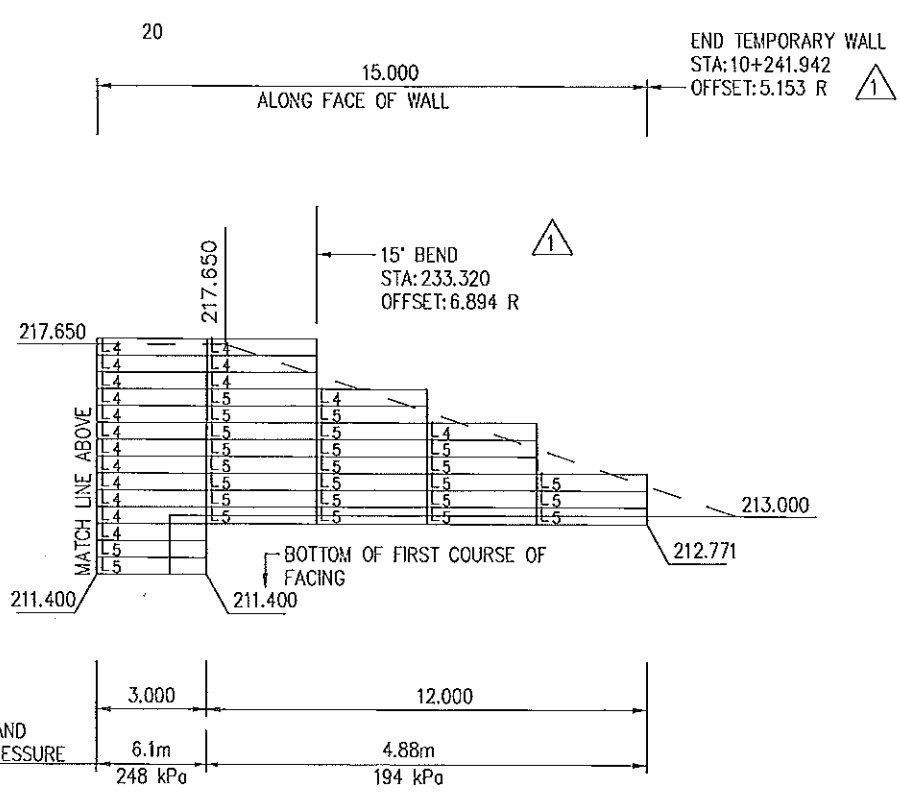

- NOTES:
- FOR TYPICAL WALL SECTION SEE SHEET 13.
 - FOR PLAN VIEW, SEE SH. 2 OF THIS PACKAGE AND CONTRACT PLANS.
 - STATIONS AND OFFSETS ARE TO FRONT FACE OF WIRE FACING.
 - SEE REINFORCING STRIP PLACEMENT DIAGRAMS ON SHEET 9.
 - ALL STATIONS AND OFFSETS ARE FROM BASELINE VT ROUTE 107.

KEY - MSE WIRE FACING UNIT

PANEL TYPE $\left[\begin{array}{|c|} \hline \text{15} \\ \hline \end{array} \right]$ No. OF GEOTRAP

INDICATES FIELD MODIFICATION OF PANEL REQUIRED BY CONTRACTOR


RECEIVED

CHK'D BY: *[Signature]* DATE: *8/26/10*

RESUBMIT APPROVED

BY: *CPW* DATE: *8/26/10*

ALL DIMENSIONS ARE IN METERS UNLESS NOTED OTHERWISE

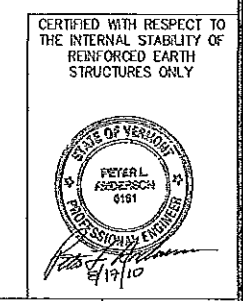

REINFORCED EARTH COMPANY, INC. - ALL RIGHTS RESERVED

<p>This drawing contains information proprietary to the Reinforced Earth Company, and is being furnished for the use of VERMONT AGENCY OF TRANSPORTATION only in connection with this project, and the information contained is not to be transmitted to any other organization unless specifically authorized in writing by the Reinforced Earth Company. The Reinforced Earth Company has designed, and is responsible for the internal stability of the structure only. External stability (including foundation bearing capacity and settlement) and slope stability (sliding and rotation), is the responsibility of the owner.</p>		<p>DESIGNED BY: MS</p> <p>PROJECT ENGINEER: LY</p> <p>CHECKED BY: LY</p> <p>DATE: 8/16/10</p>		<p>PROJECT NAME: VT ROUTE 107, BRIDGE 9</p> <p>LOCATION: STOCKBRIDGE, VERMONT</p> <p>OTHER: VERMONT AGENCY OF TRANSPORTATION</p> <p>DRAWING NO.: 8 OF 16</p> <p>SCALE: AS SHOWN</p>		<p>DATE: 07/16/2010</p> <p>CONTRACT NO.: RC-14697</p> <p>DRAWING NO.: 8 OF 16</p> <p>SCALE: AS SHOWN</p>	
<p>REINFORCED EARTH</p> <p>1844 Vantage Court, Blacksburg, VA 24060</p>		<p>REINFORCED EARTH is the registered trademark of The Reinforced Earth Company.</p>		<p>REINFORCED WALL LENGTHS AND STATIONS</p>		<p>ELEVATION VIEW - TEMPORARY SURCHARGE WALL AT ABUTMENT No. 2</p>	