


PLACEMENT DIAGRAMS OF STRUTS AND GEOSTRIPS - PLAN VIEW

NOT TO SCALE

RECEIVED
 CK'D BY: *DLA* DATE: *8/26/10*
 AUG 18 2010
 RESUBMIT _____ APPROVED
 BY: *OPW* DATE: *8/26/10*

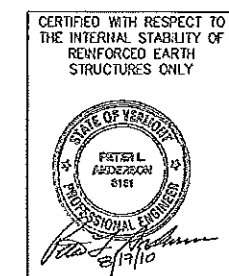

14. VERMONT STATE BOARD OF PROFESSIONAL ENGINEERS (VSBPE) - ALL RIGHTS RESERVED

This drawing contains information proprietary to The Reinforced Earth Company, and is being furnished for the use of VERMONT AGENCY OF TRANSPORTATION only in connection with this project, and the information contained is not to be transmitted to any other organization unless specifically authorized in writing by The Reinforced Earth Company. The Reinforced Earth Company is exclusive licensee in the United States under patents issued to Henri Vidal, and the furnishing of this drawing does not constitute an expressed or implied license under the Vidal patents.

The design contained on these drawings is based on information provided by the owner. On the basis of this information, The Reinforced Earth Company has designed, and is responsible for the internal stability of the structure only. External stability (including foundation (bearing capacity and settlement) and slope stability (sliding and rotation), is the responsibility of the owner.



DESIGNED BY:	PROJECT ENGINEER:	CHECKED BY:	REV.	DATE	DESCRIPTION
MS	LY	LY			

PROJECT NAME	LOCATION	OWNER	DRAWING CODE	DATE
VT ROUTE 107, BRIDGE 9	STOCKBRIDGE, VERMONT	VERMONT AGENCY OF TRANSPORTATION	WIRE WALL PLACEMENT DETAILS	07/16/2010

CONTRACT NO.	DRAWING NO.	SCALE
RE-14697	9 OF 16	AS SHOWN