


RECEIVED
 CK'D BY RD OK'D BY RSY
 AUG 18 2010
 RESUBMIT _____ APPROVED _____
 BY CPW DATE 8/28/10

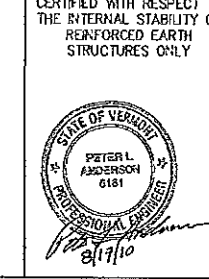

<small>This drawing contains information proprietary to the Reinforced Earth Company, and is being furnished for the use of VERMONT AGENCY OF TRANSPORTATION only in connection with this project, and the information contained is not to be transmitted to any other organization unless specifically authorized in writing by The Reinforced Earth Company. The Reinforced Earth Company is exclusive licensee in the United States under patents issued to Henri Vidal, and the furnishing of this drawing does not constitute an expressed or implied license under the Vidal patents.</small>		<small>The design contained on these drawings is based on information provided by the owner. On the basis of this information, The Reinforced Earth Company has designed, and is responsible for the internal stability of the structure only. External stability, including foundation (bearing capacity and settlement) and slope stability (sliding and rotation), is the responsibility of the owner.</small>		REINFORCED EARTH <small>1814 Westover Circle, York, VA 22442 (800) 818-1125</small>		DESIGNED BY: MS PROJECT ENGINEER: LY CHECKED BY: LY	PROJECT NAME: VT ROUTE 107, BRIDGE 9 LOCATION: STOCKBRIDGE, VERMONT OWNER: VERMONT AGENCY OF TRANSPORTATION DRAWING CODES: TYPICAL WIRE FACE DETAILS	DATE: 07/16/2010 CONTRACT NO.: RE-14657 DRAWING NO.: 14 OF 16 SCALE: AS SHOWN
<small>REINFORCED EARTH® is the registered trademark of The Reinforced Earth Company.</small>		REV. DATE DESCRIPTION 00000						