


THE PANEL DRAWINGS ON THIS SHEET ARE NOT PROJECT SPECIFIC. THESE DRAWINGS ARE INCLUDED TO DETAIL REBAR SIZES AND PLACEMENT FOR STANDARD PANELS. SEE INDIVIDUAL PANEL DRAWINGS FOR PROJECT SPECIFIC PANEL DIMENSIONS AND THE STRIP LOCATIONS.

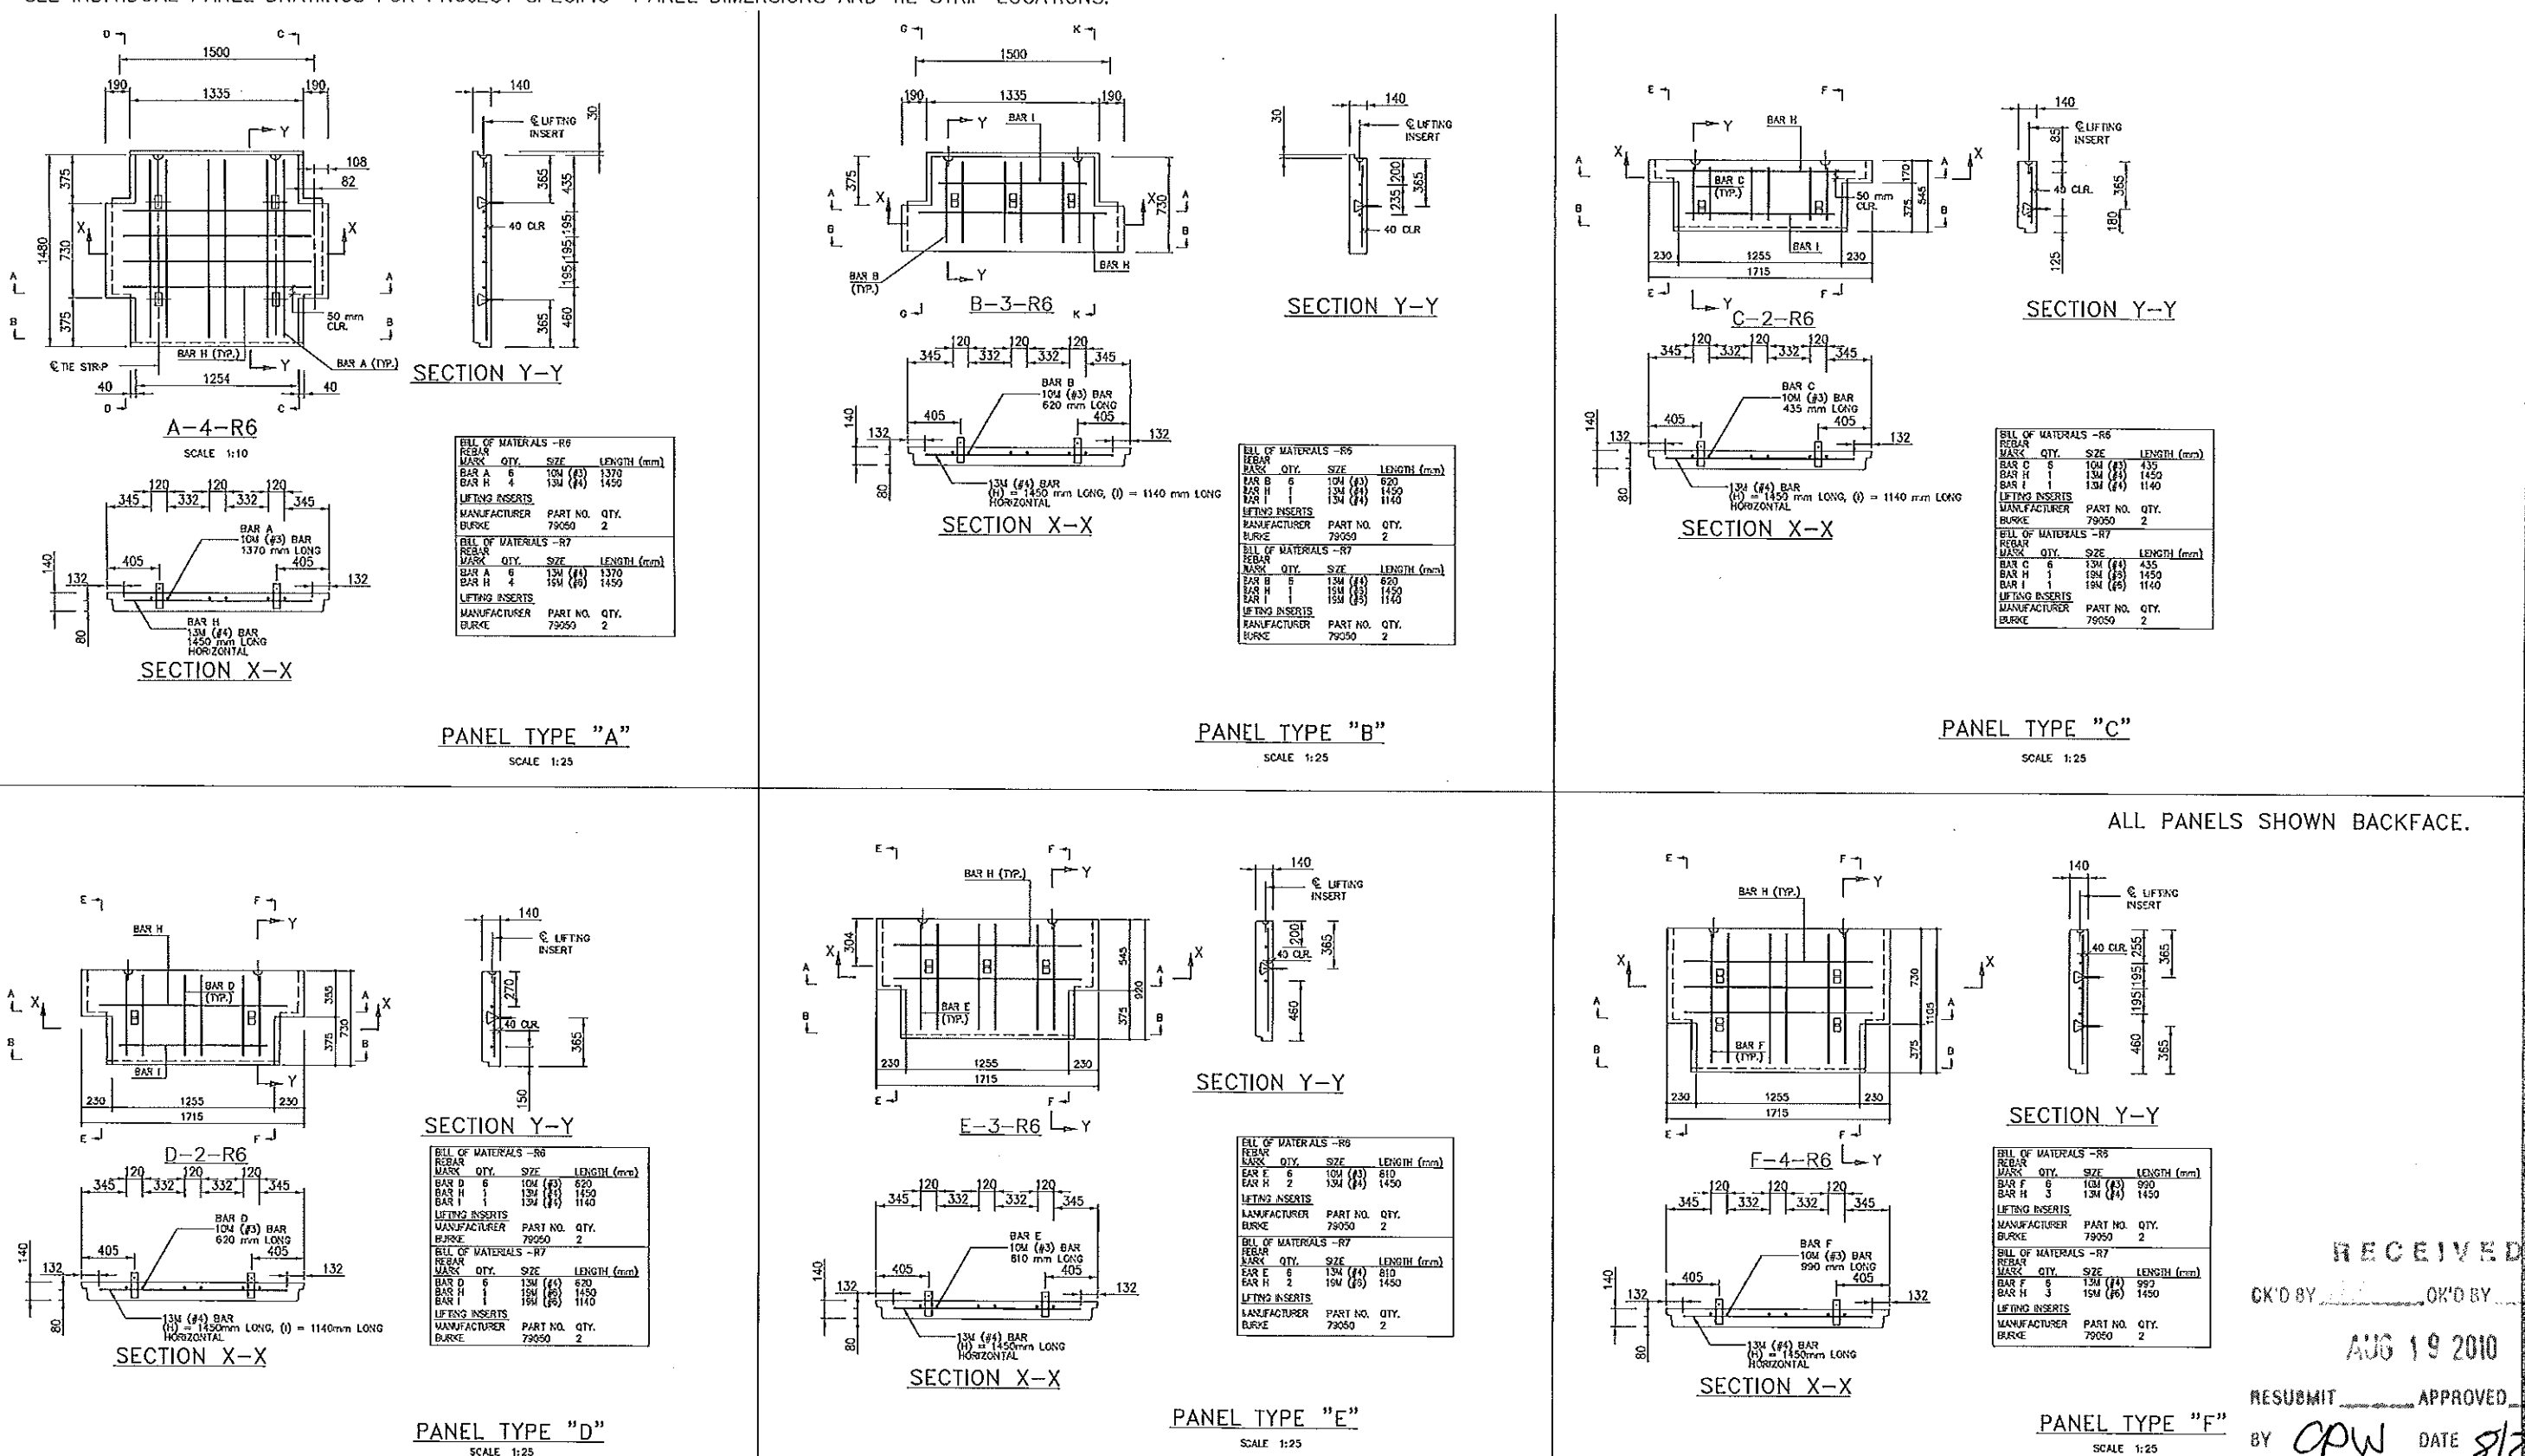

This drawing contains information proprietary to The Reinforced Earth Company, and is being furnished for the use of VERMONT AGENCY OF TRANSPORTATION only in connection with this project, and the information contained is not to be transmitted to any other organization unless specifically authorized in writing by The Reinforced Earth Company. The Reinforced Earth Company is an exclusive licensee in the United States under patents issued to Henri Vidal, and the furnishing of this drawing does not constitute an expressed or implied license under the Vidal patents.

The design contained on these drawings is based on information provided by the owner. On the basis of this information, The Reinforced Earth Company has designed, and is responsible for the inherent stability of the structure only. External stability, including foundation (bearing capacity and settlement) and slope stability (sliding and rotation), is the responsibility of the owner.

**REINFORCED EARTH**  
184 Woodland Drive, Verona, VT 05498 (802) 245-1175

DESIGNED BY: LY  
PROJECT ENGINEER: LY  
CHECKED BY: PLA  
DATE: 07/16/2010

PROJECT NAME: VT ROUTE 107, BRIDGE 9  
LOCATION: STOCKBRIDGE, VERMONT  
OWNER: VERMONT AGENCY OF TRANSPORTATION  
DRAWING NO.: S4 OF S10  
SCALE: AS SHOWN

REVISIONS:  
REV. DATE DESCRIPTION  
1 07/16/2010

RECEIVED  
CHK'D BY: [Signature] DTD BY: [Signature]  
AUG 19 2010  
RESUBMIT: [ ] APPROVED: [Signature]  
BY: CPW DATE: 8/26/10