


THE PANEL DRAWINGS ON THIS SHEET ARE NOT PROJECT SPECIFIC. THESE DRAWINGS ARE INCLUDED TO DETAIL REBAR SIZES AND PLACEMENT FOR STANDARD PANELS. SEE INDIVIDUAL PANEL DRAWINGS FOR PROJECT SPECIFIC PANEL DIMENSIONS AND THE STRIP LOCATIONS.

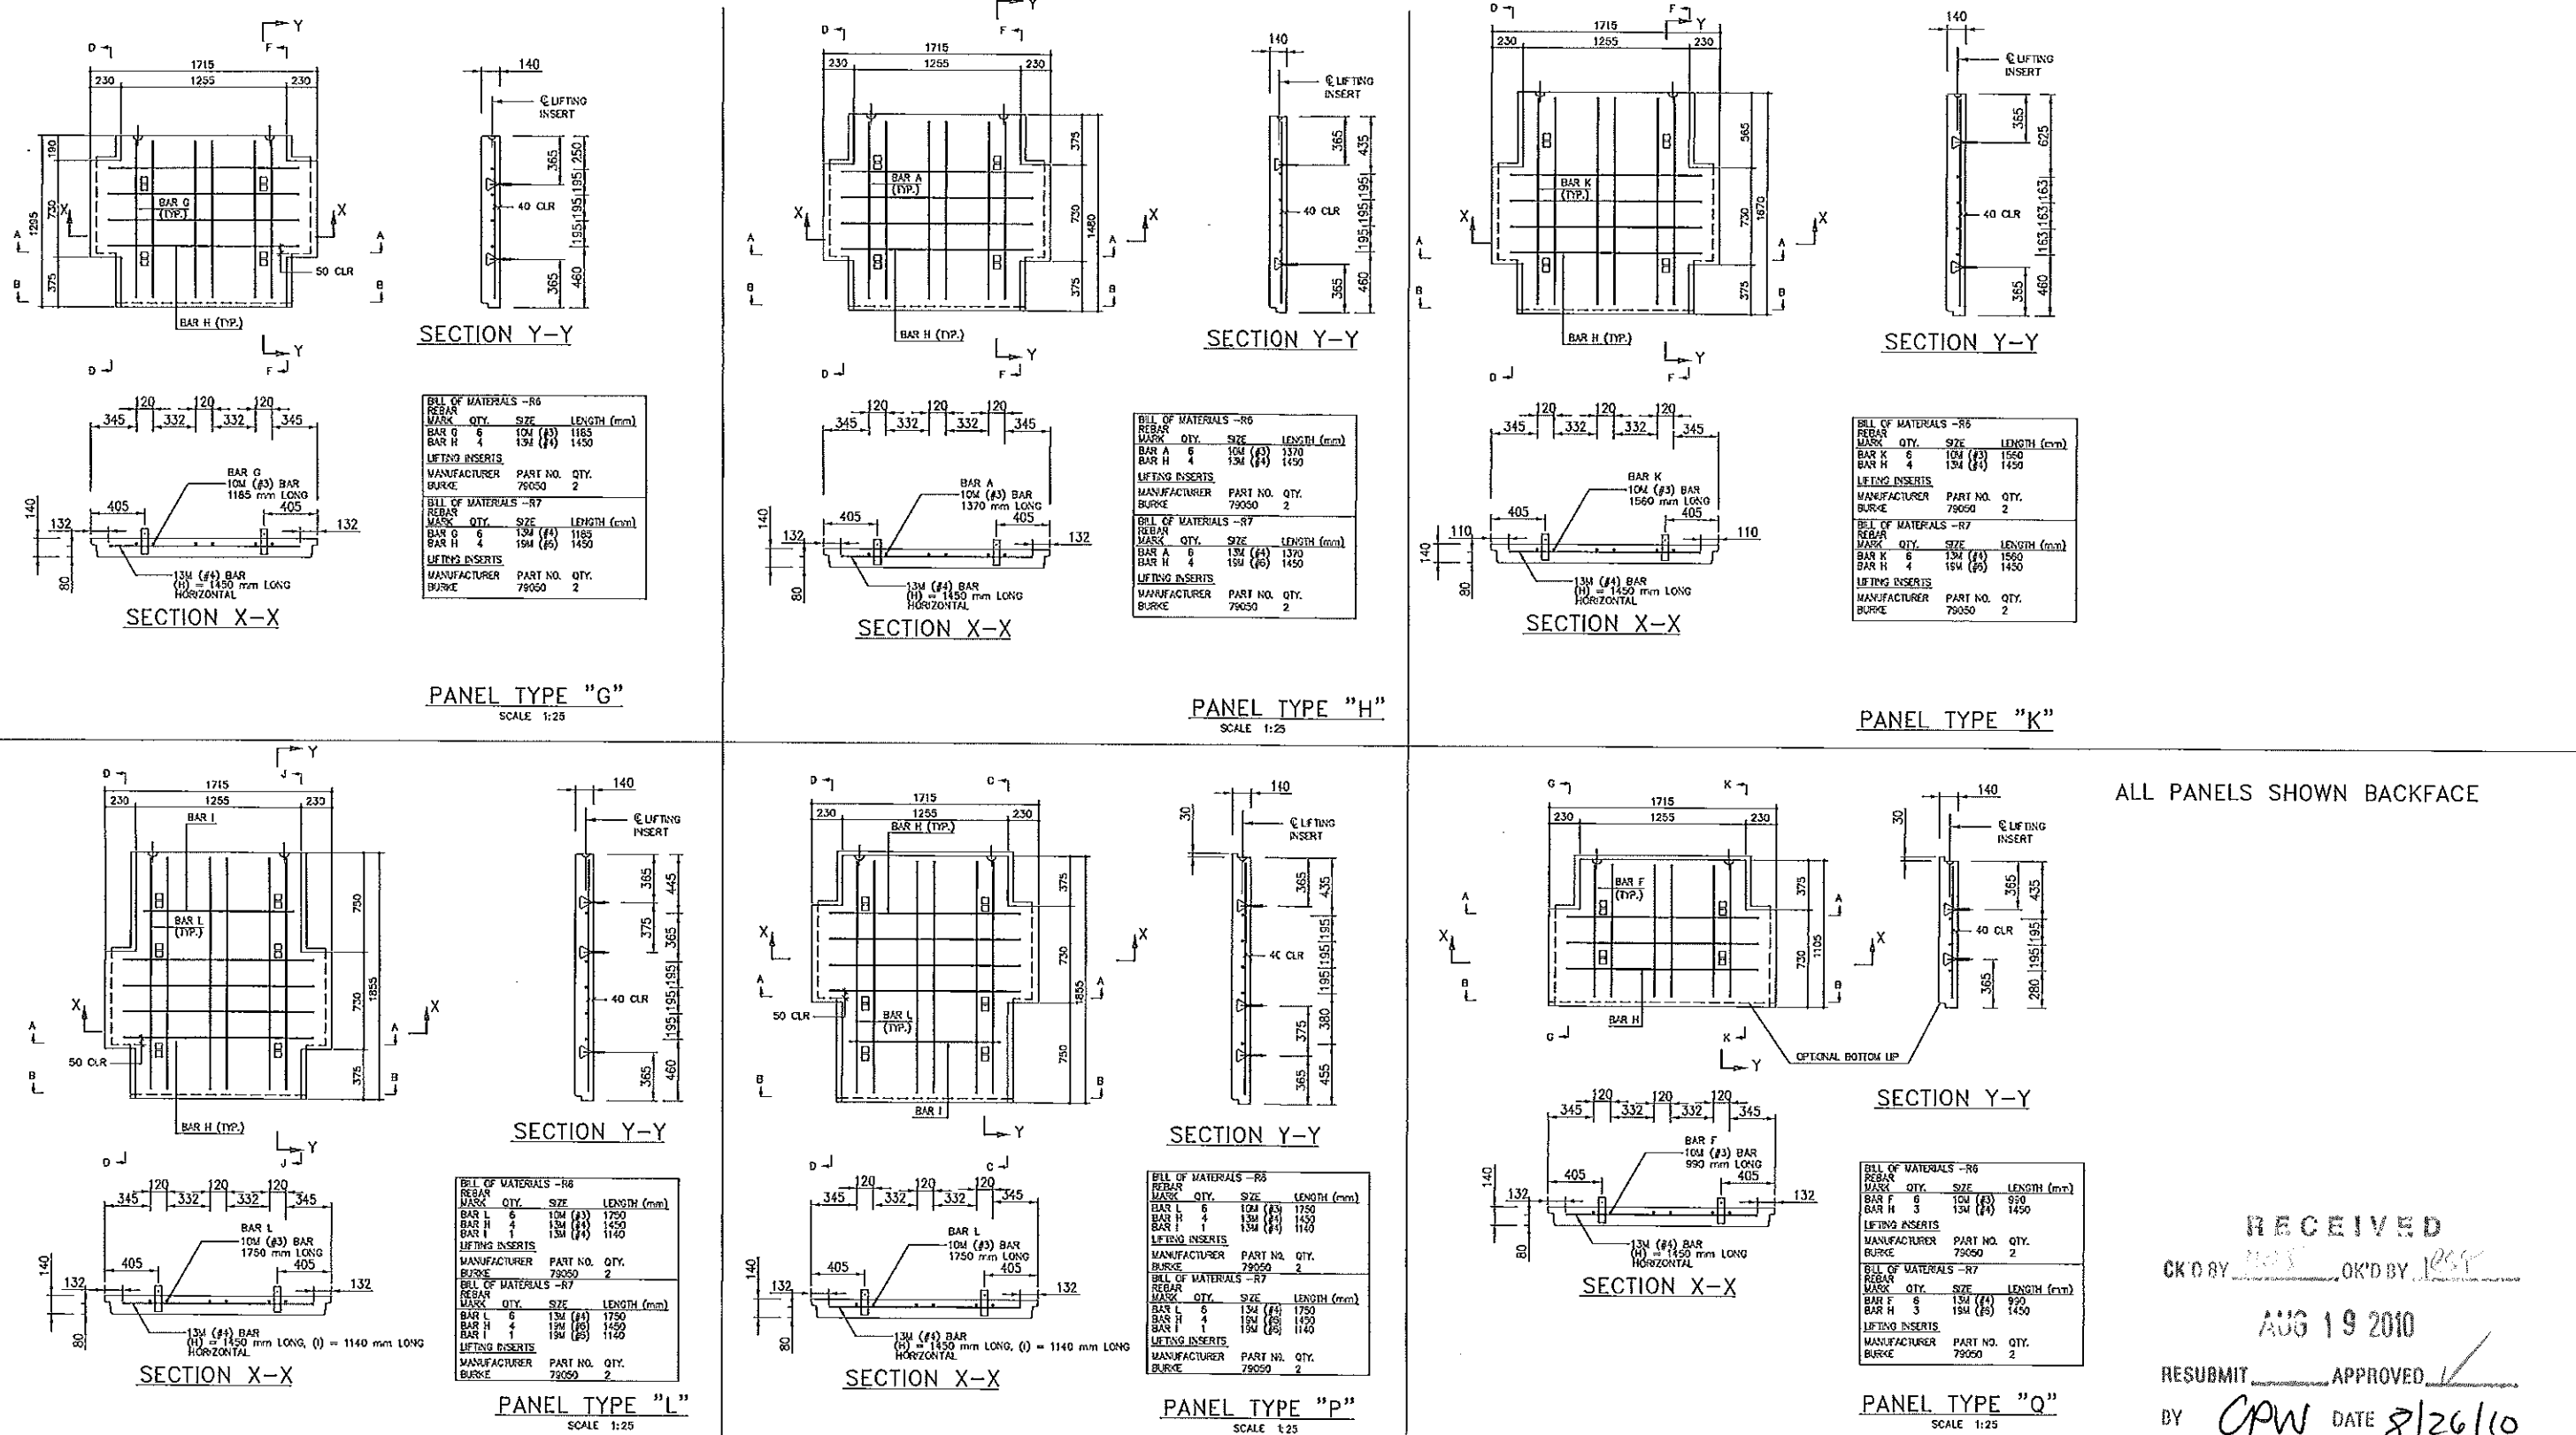


ALL PANELS SHOWN BACKFACE

RECEIVED  
 CK'D BY [Signature] OK'D BY [Signature]  
 AUG 19 2010  
 RESUBMIT [ ] APPROVED [ ]  
 BY CPW DATE 8/26/10

REINFORCED EARTH COMPANY

This drawing contains information proprietary to the Reinforced Earth Company, and is being furnished for the use of VERMONT AGENCY OF TRANSPORTATION only in connection with this project, and the information contained is not to be transmitted to any other organization unless specifically authorized in writing by The Reinforced Earth Company. The Reinforced Earth Company is an exclusive licensee in the United States under patents issued to Henri Vidal, and the furnishing of this drawing does not constitute an expressed or implied license under the Vidal patents.

The design contained on these drawings is based on information provided by the owner. On the basis of this information, The Reinforced Earth Company has designed, and is responsible for the internal stability of the structure only. External stability, including foundation (bearing capacity and settlement) and slope stability (sliding and rotation), is the responsibility of the owner.

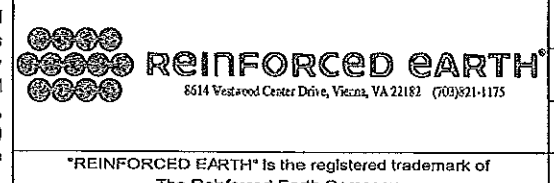

DESIGNED BY	LY	PROJECT NAME	VT ROUTE 107, BRIDGE 9	DATE	07/16/2010
CHECKED BY	LY	LOCATION	STOCKBRIDGE, VERMONT	CONTRACT NO.	RC-14657
DATE	PLA	OWNER	VERMONT AGENCY OF TRANSPORTATION	DRAWING NO.	SS OF S10
REV.	DATE	DESCRIPTION	REW PANEL CROSS SECTIONS	SCALE	AS SHOWN