


SEE SHEET 2 FOR INDEX OF SHEETS
AND LIST OF STANDARDS.

WINTERSAT, INC.
Contractor
Norm A. Jovic
Signature
SR. VICE PRESIDENT
Title

STATE OF VERMONT
AGENCY OF TRANSPORTATION



PROPOSED IMPROVEMENT
BRIDGE PROJECT
TOWN OF LYNDON
COUNTY OF CALEDONIA

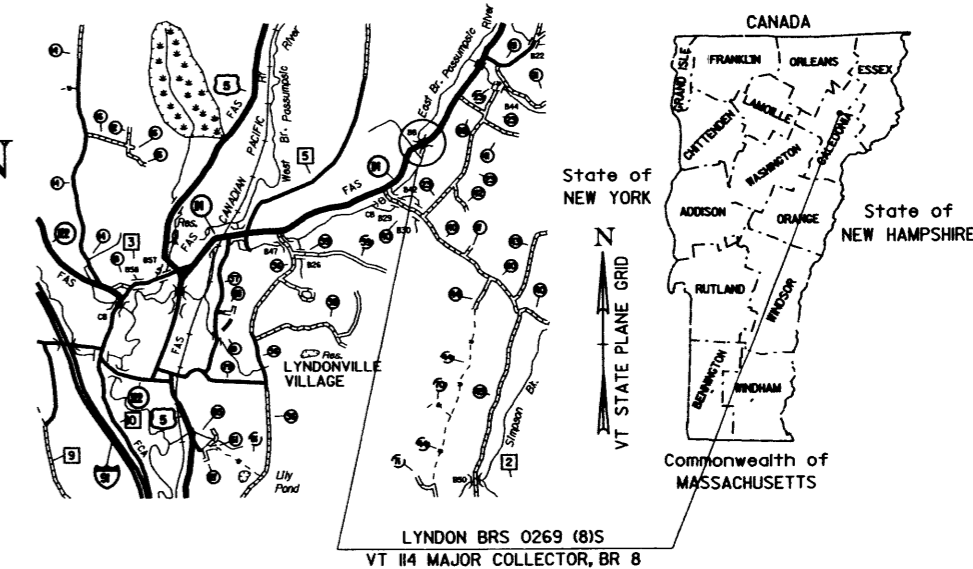


ROUTE NO : VT 114 MAJOR COLLECTOR BRIDGE NO : 8

PROJECT LOCATION : BEGINNING AT A POINT APPROXIMATELY 3.505 KILOMETERS NORTHEASTERLY FROM THE INTERSECTION OF US 5 AND VT 114 AND EXTENDING NORTHEASTERLY 0.120 KILOMETERS ALONG VT 114.

PROJECT DESCRIPTION : REPLACEMENT OF THE EXISTING BRIDGE INCLUDING RELATED APPROACH ROADWAY AND CHANNEL WORK.


LENGTH OF STRUCTURE : 28.838 METERS.
LENGTH OF ROADWAY : 91.162 METERS.
LENGTH OF PROJECT : 120.000 METERS.

David C. Dine
Secretary of Transportation
or Duly Authorized Agent
1/20/06
Date

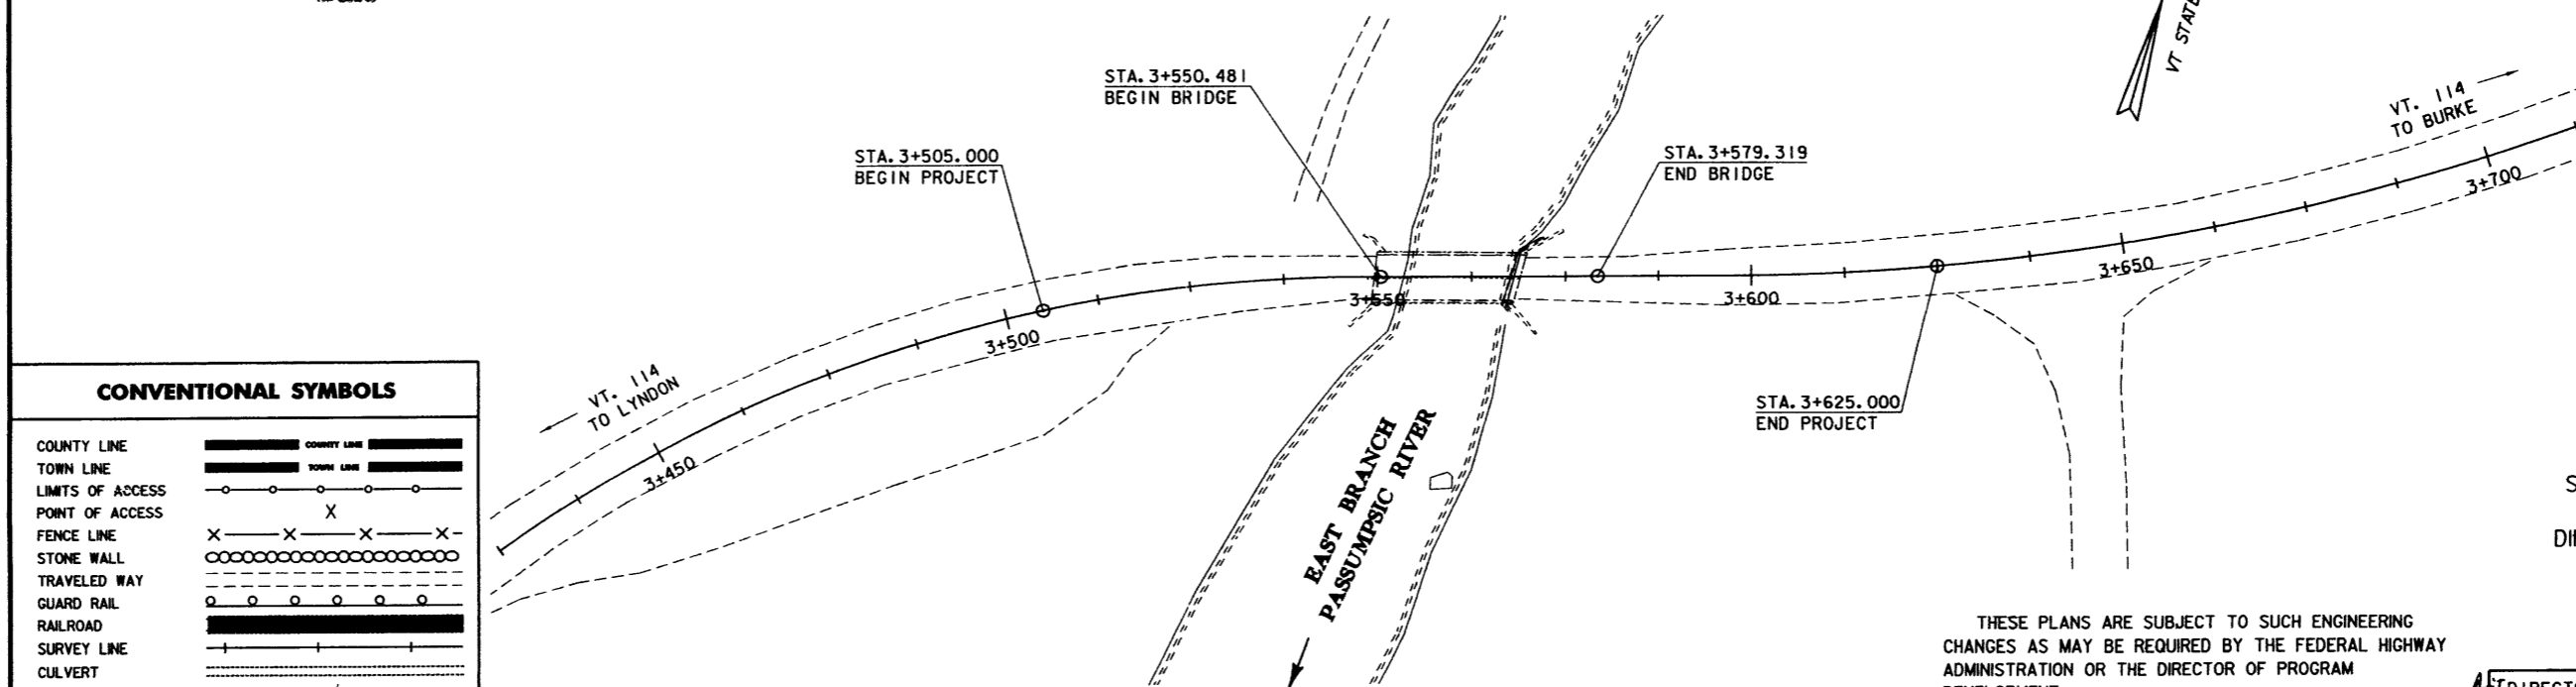

CONVENTIONAL SYMBOLS	
COUNTY LINE	--- COUNTY LINE ---
TOWN LINE	--- TOWN LINE ---
LIMITS OF ACCESS	--- LIMITS OF ACCESS ---
POINT OF ACCESS	--- POINT OF ACCESS ---
FENCE LINE	X X X X X X X X X X
STONE WALL	--- STONE WALL ---
TRAVELED WAY	--- TRAVELED WAY ---
GUARD RAIL	--- GUARD RAIL ---
RAILROAD	--- RAILROAD ---
SURVEY LINE	--- SURVEY LINE ---
CULVERT	--- CULVERT ---
POWER POLE	--- POWER POLE ---
TELEPHONE POLE	--- TELEPHONE POLE ---
TREES	--- TREES ---
CONTROL OF ACCESS	--- CONTROL OF ACCESS ---
PROPERTY LINE	--- PROPERTY LINE ---
R.O.W. TAKING LINE	--- R.O.W. TAKING LINE ---
SLOPE RIGHTS	--- SLOPE RIGHTS ---
TOP OF CUT	--- TOP OF CUT ---
TOE OF SLOPE	--- TOE OF SLOPE ---

SURVEYED BY : R. MOREAU
SURVEYED DATE : 01-31-1993
DATUM
VERTICAL NAVD 88
HORIZONTAL NAD 83 (92)

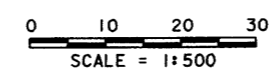

Metric
UNLESS NOTED OTHERWISE
STATIONS ARE IN KILOMETERS
ELEVATIONS ARE IN METERS
DIMENSIONS ARE IN MILLIMETERS

THESE PLANS ARE SUBJECT TO SUCH ENGINEERING CHANGES AS MAY BE REQUIRED BY THE FEDERAL HIGHWAY ADMINISTRATION OR THE DIRECTOR OF PROGRAM DEVELOPMENT.
CONSTRUCTION IS TO BE CARRIED ON IN ACCORDANCE WITH THESE PLANS AND THE STANDARD SPECIFICATIONS FOR CONSTRUCTION DATED 2001, AS APPROVED BY THE FEDERAL HIGHWAY ADMINISTRATION ON JANUARY 4, 2001 FOR USE ON THIS PROJECT, INCLUDING ALL SUBSEQUENT REVISIONS AND SUCH REVISED SPECIFICATIONS AND SPECIAL PROVISIONS AS ARE INCORPORATED IN THESE PLANS.

APPROVED BY DIRECTOR OF PROGRAM DEVELOPMENT
R. Whitcomb
DATE 10-6-05
PROJECT/MANAGER : ROGER R. WHITCOMB
PROJECT NAME : LYNDON
PROJECT NUMBER : BRS 0269 (B)S
SHEET 1 OF 68 SHEETS