
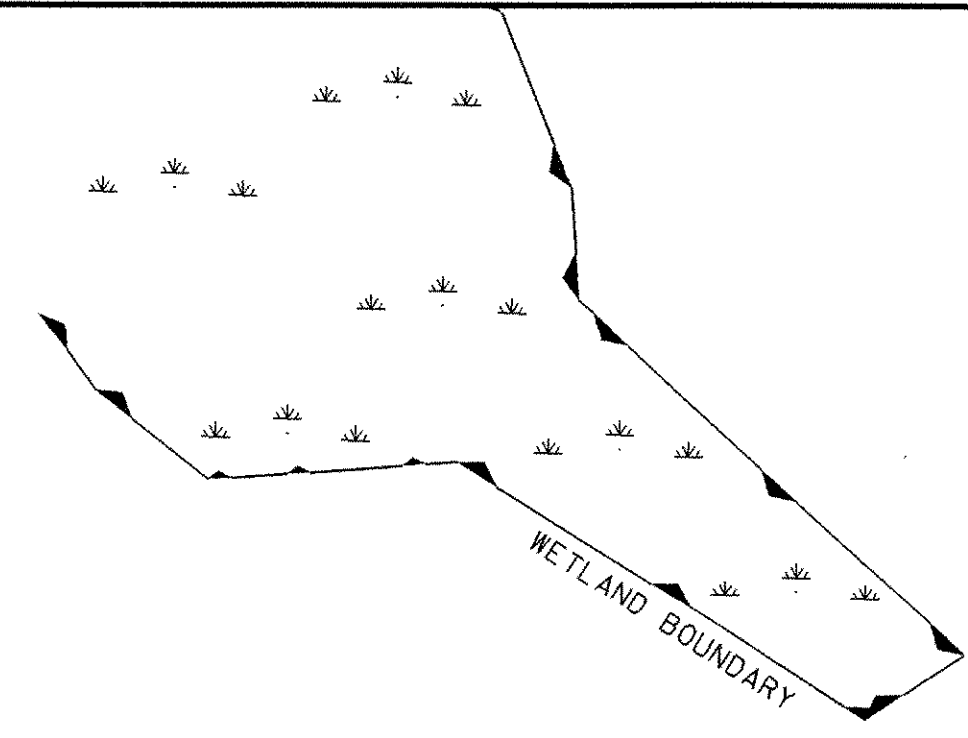



CONSTRUCT PAVED APRON
3+627.5 RT. - 3+657.5 RT. (7.3m)

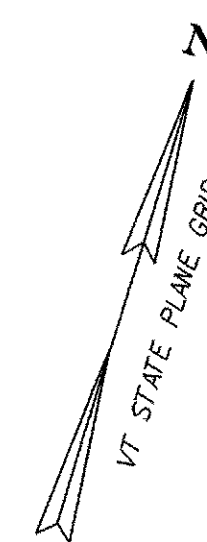

STA. 3+770.9 CL
EXISTING 450mm ACGRIP
DO NOT DISTURB

MATCH LINE A-A

STA. 3+600

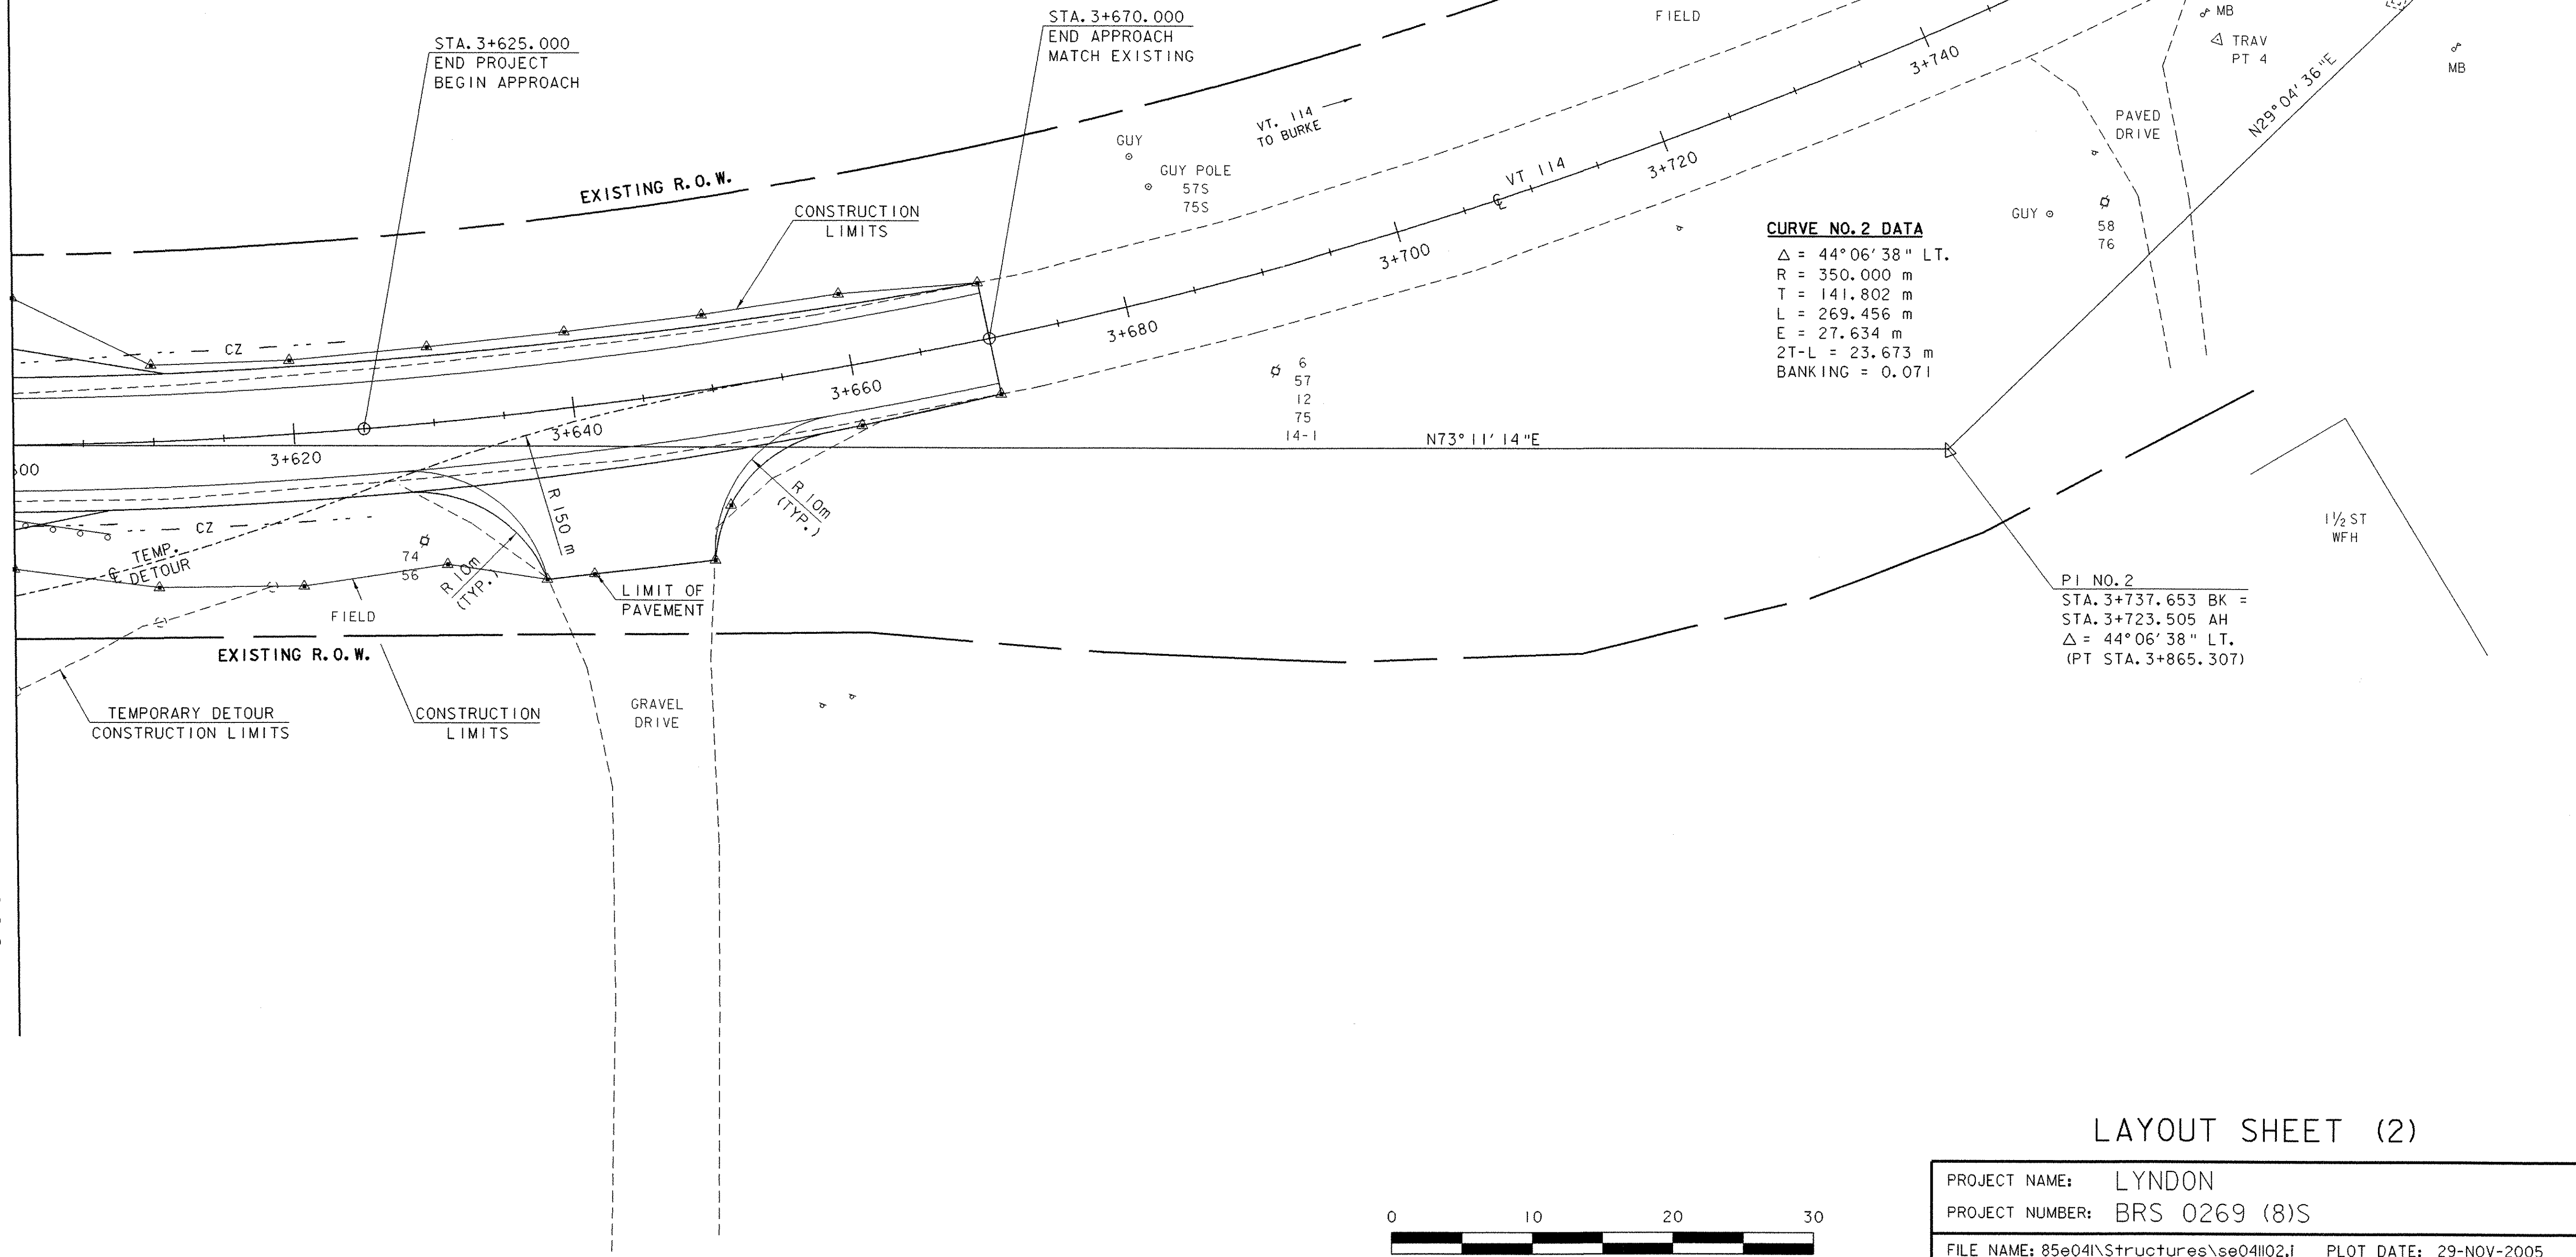

CURVE NO. 2 DATA
 $\Delta = 44^\circ 06' 38''$ LT.
 $R = 350.000$ m
 $T = 141.802$ m
 $L = 269.456$ m
 $E = 27.634$ m
 $2T-L = 23.673$ m
 $BANKING = 0.071$

PI NO. 2
 STA. 3+737.653 BK =
 STA. 3+723.505 AH
 $\Delta = 44^\circ 06' 38''$ LT.
 (PT STA. 3+865.307)

LAYOUT SHEET (2)

PROJECT NAME:	LYNDON	PLOT DATE:	29-NOV-2005
PROJECT NUMBER:	BRS 0269 (8)S	DRAWN BY:	G. ROY
FILE NAME:	85e04\structures\se04i02.i	CHECKED BY:	M. LOZIER
PROJECT MANAGER:	R. R. WHITCOMB	SHEET	12 OF 68
DESIGNED BY:	G. ROY		

