



PROFILE ALONG PROPOSED CENTERLINE VT 114

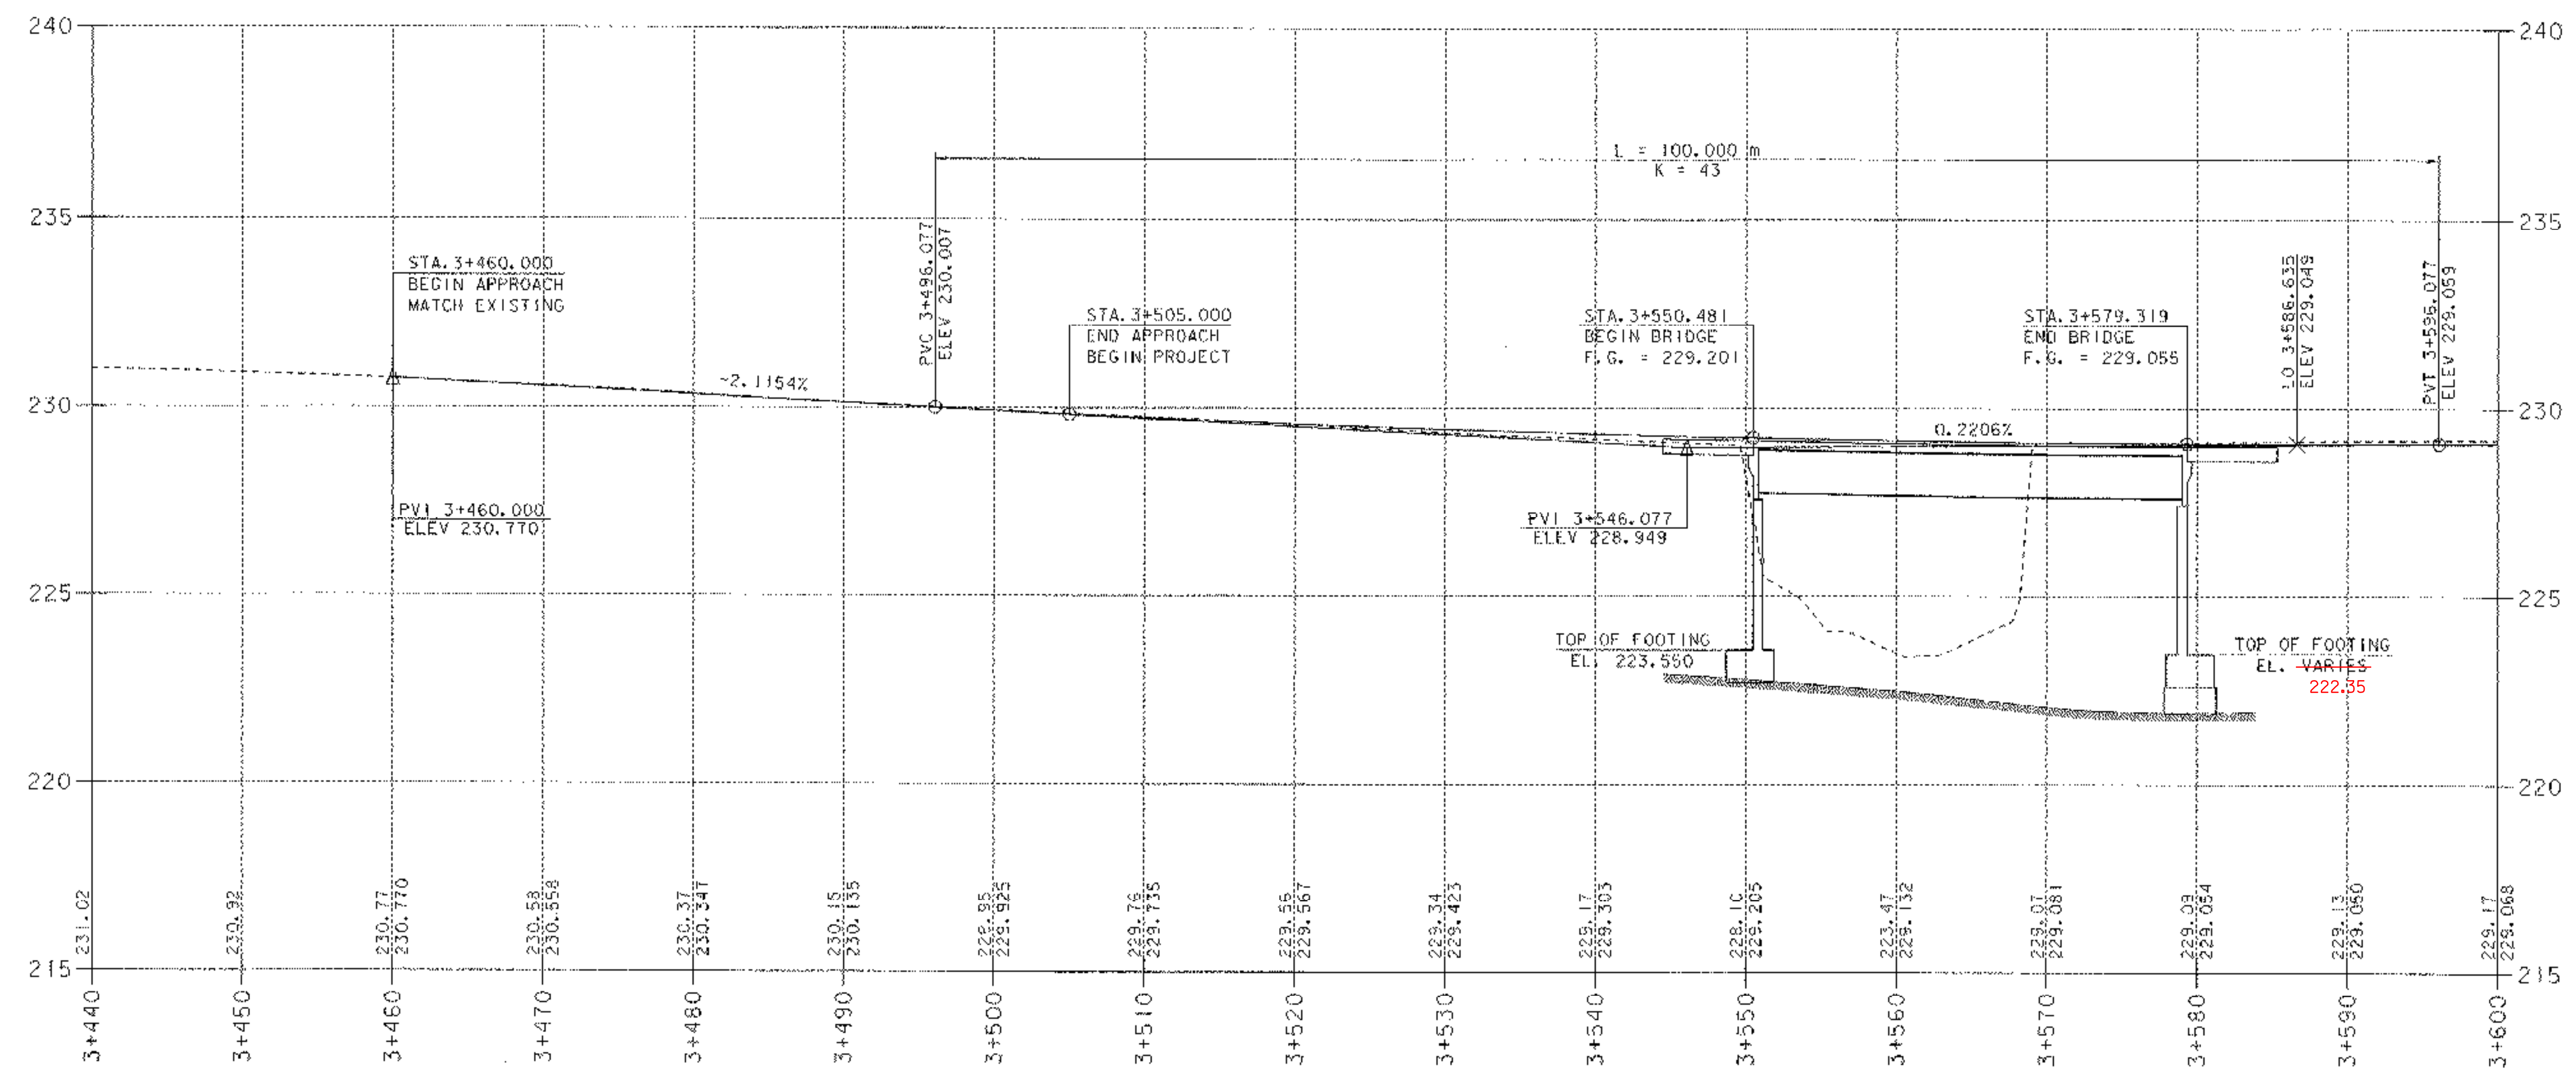

NOTE:
 ELEVATIONS TO THE NEAREST HUNDREDTH ARE EXISTING GROUND ALONG PROPOSED CENTERLINE.
 ELEVATIONS TO THE NEAREST THOUSANDTH ARE FINISH GRADE ALONG PROPOSED CENTERLINE.

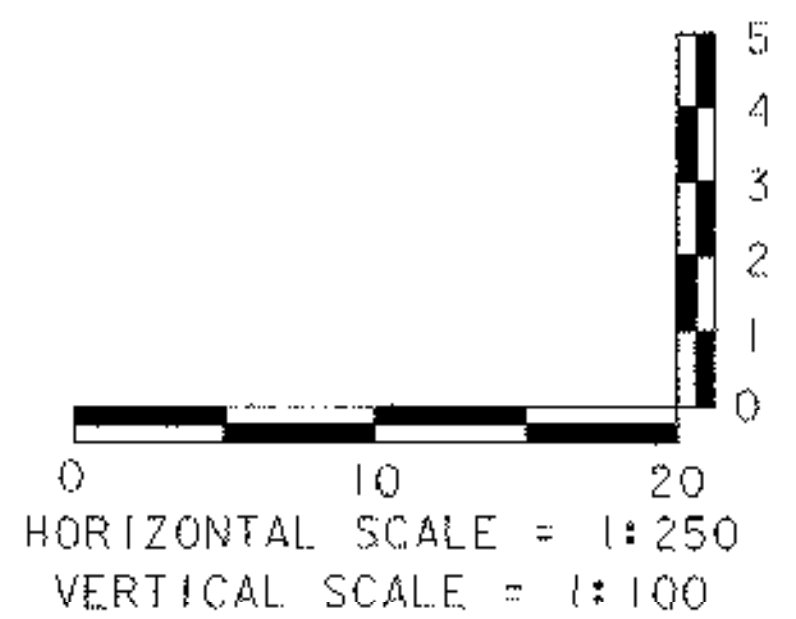

PROFILE SHEET (I)

PROJECT NAME: LYNDON	PLOT DATE: 29-NOV-2005
PROJECT NUMBER: BRS 0269 (8)S	DRAWN BY: G. ROY
FILE NAME: 85e04\Structures\se04ip11	CHECKED BY: M. LOZIER
DESIGNED BY: G. ROY	SHEET 13 OF 68