

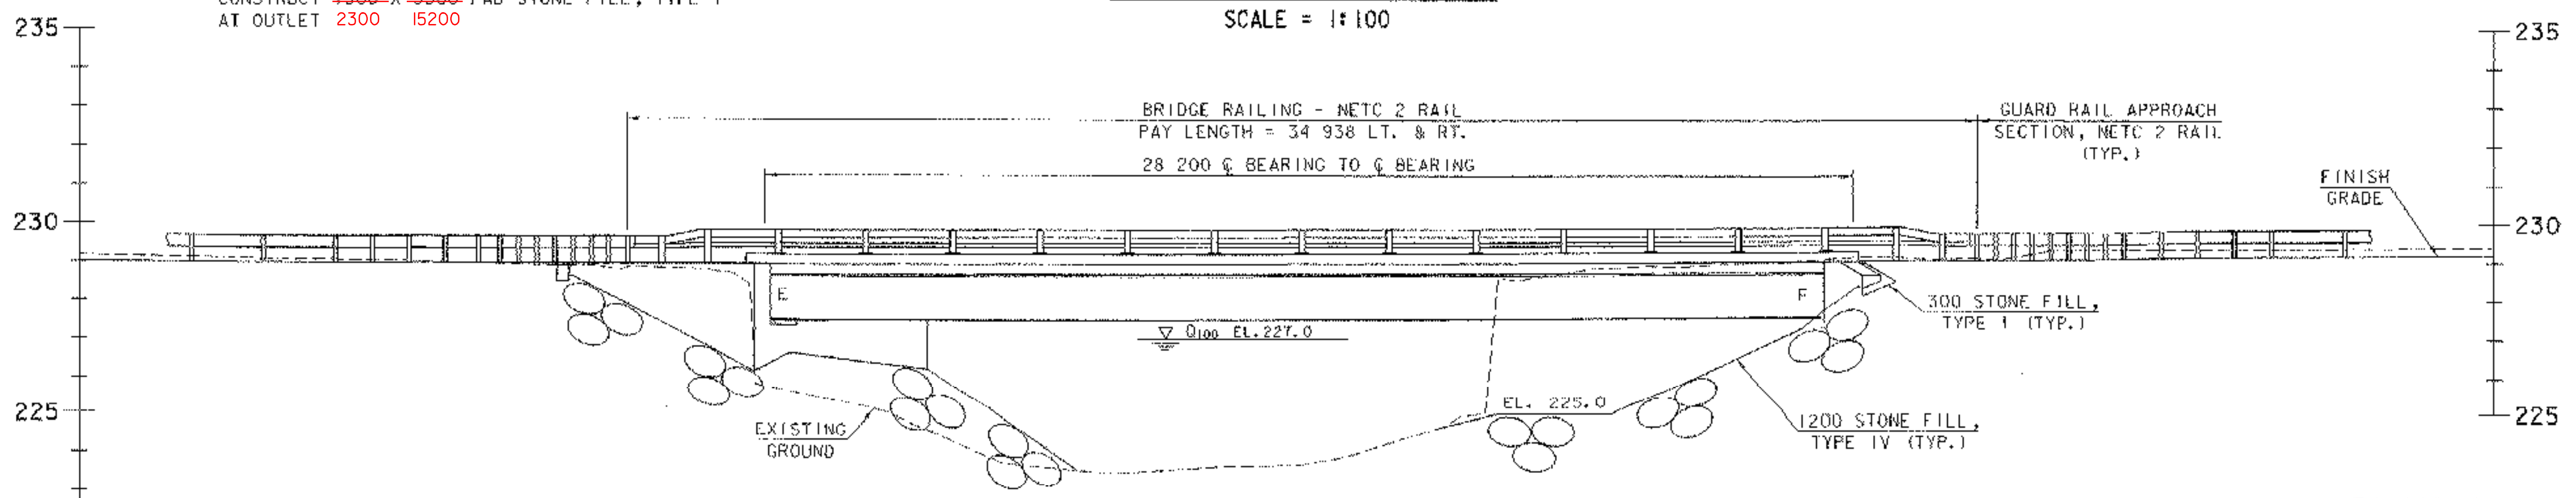


PLAN

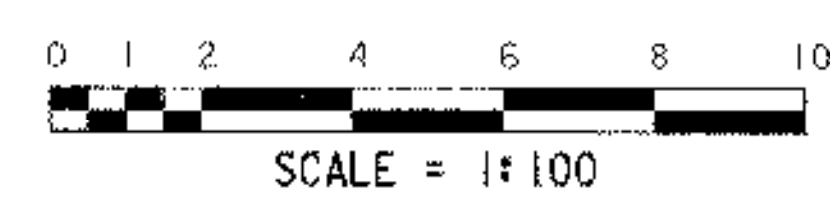

ELEVATION

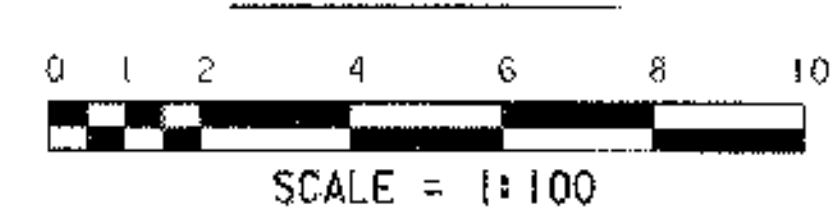

NOTE:
SEE SHEETS 38 - 39 FOR
ADDITIONAL RAIL DETAILS.

PLAN AND ELEVATION

PROJECT NAME:	LYNDON	FILE NAME:	85e04\structures\se04pe.1	PLOT DATE:	29-NOV-2005
PROJECT NUMBER:	BRS 0269 (8)S	PROJECT MANAGER:	R. R. WHITCOMB	DRAWN BY:	G. ROY
		DESIGNED BY:	G. ROY	CHECKED BY:	M. LOZIER
				SHEET	21 OF 68