

MATCH LINE A-A

STA. 3+600

BM NO. 1  
USGS DISK M23  
EL. 228.963

STA. 3+413.7 CL  
EXISTING 1.22m X 0.91m CONCR. BOX  
(RETAIN)


**EXISTING BRIDGE DATA**

DECK IS A SIMPLE SPAN CONCRETE DECK WITH ASPHALT OVERLAY

SUPERSTRUCTURE CONSISTS OF 5 ROLLED BEAMS 0.711m DEEP X 0.362m WIDE X 246 kg/m

ABUTMENTS AND WINGWALLS ARE CAST-IN-PLACE CONCRETE

BRIDGE LENGTH: 8.90m  
BRIDGE WIDTH: 6.96m  
VERTICAL CLEARANCE UNDER BRIDGE: 4.1m

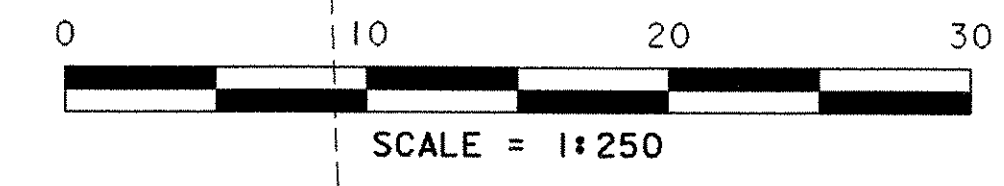

**EXISTING CONDITIONS SITE PLAN (1)**

PROJECT NAME:	LYNDON	FILE NAME:	85e04\structures\se04ie02.1	PLOT DATE:	29-NOV-2005
PROJECT NUMBER:	BRS 0269 (8)S	PROJECT MANAGER:	R. R. WHITCOMB	DRAWN BY:	G. ROY
DESIGNED BY:	G. ROY	CHECKED BY:	J. PERRIGO	SHEET	23 OF 68