




**DECK REINFORCING PLAN**

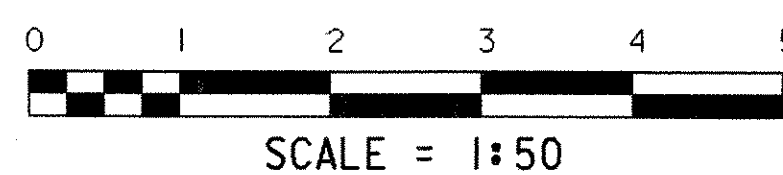

NOTE: ES2501 BARS NOT SHOWN  
SEE SHEET 43 FOR DETAILS

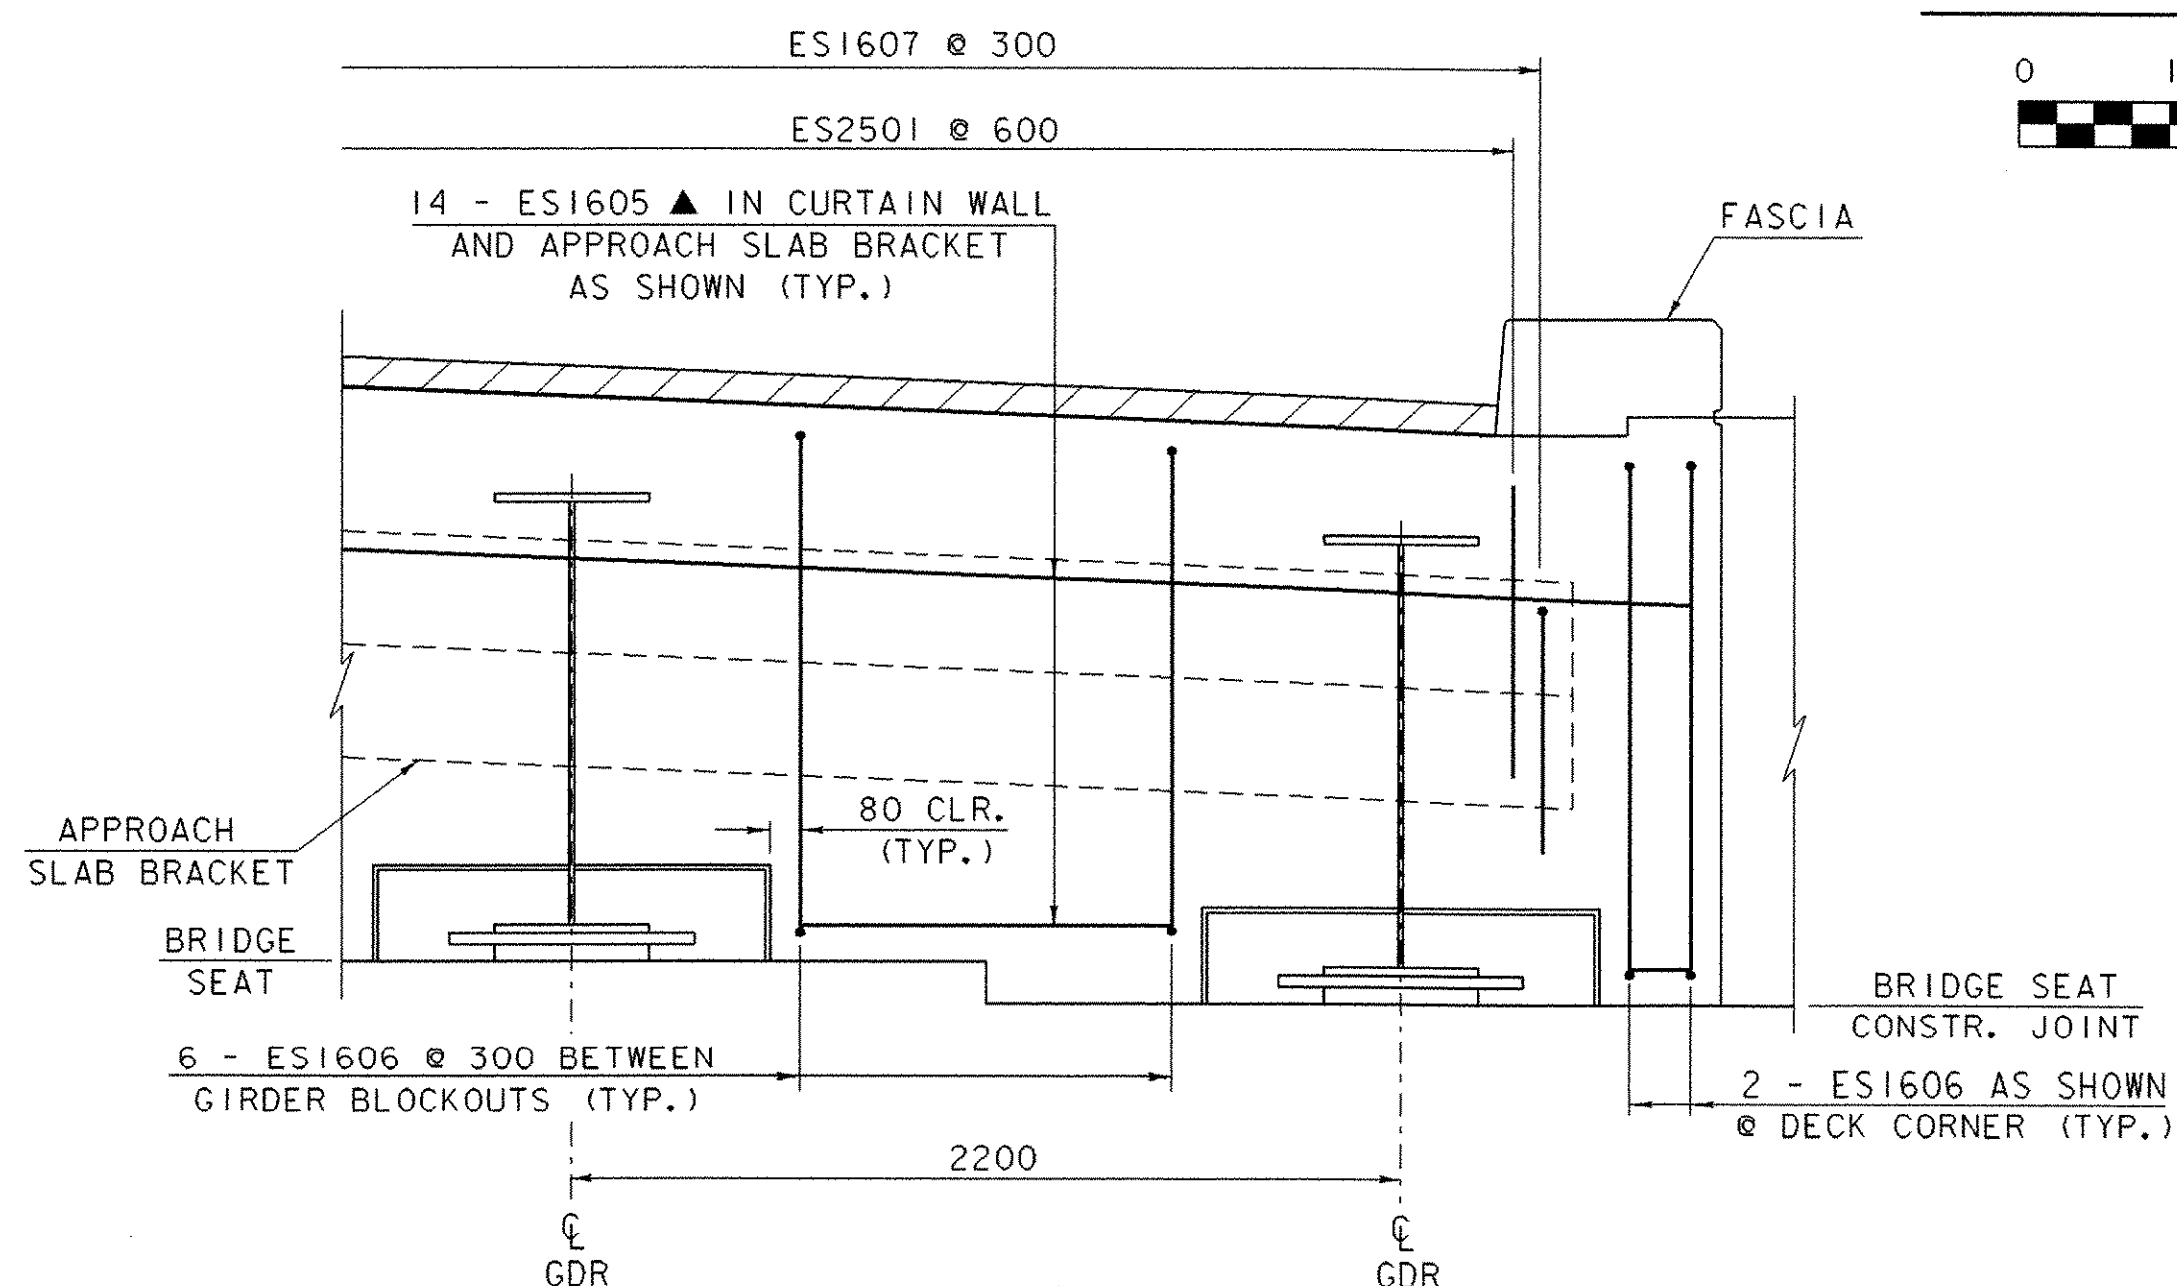

**SECTION A - A**

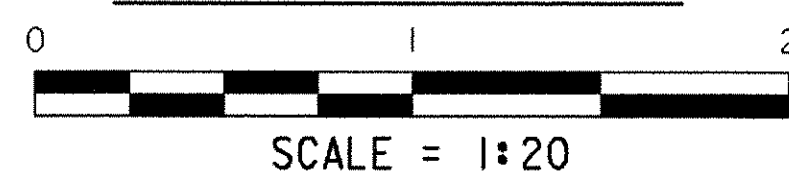

**DECK REINFORCING PLAN**

PROJECT NAME: LYNDON	PLOT DATE: 29-NOV-2005
PROJECT NUMBER: BRS 0269(8)S	DRAWN BY: L. BULLOCK
FILE NAME: 85e04\structures\ee04ldck.i	CHECKED BY: S. SCRIBNER
PROJECT LEADER: R.R. WHITCOMB	SHEET 34 OF 68
DESIGNED BY: S. SCRIBNER	