

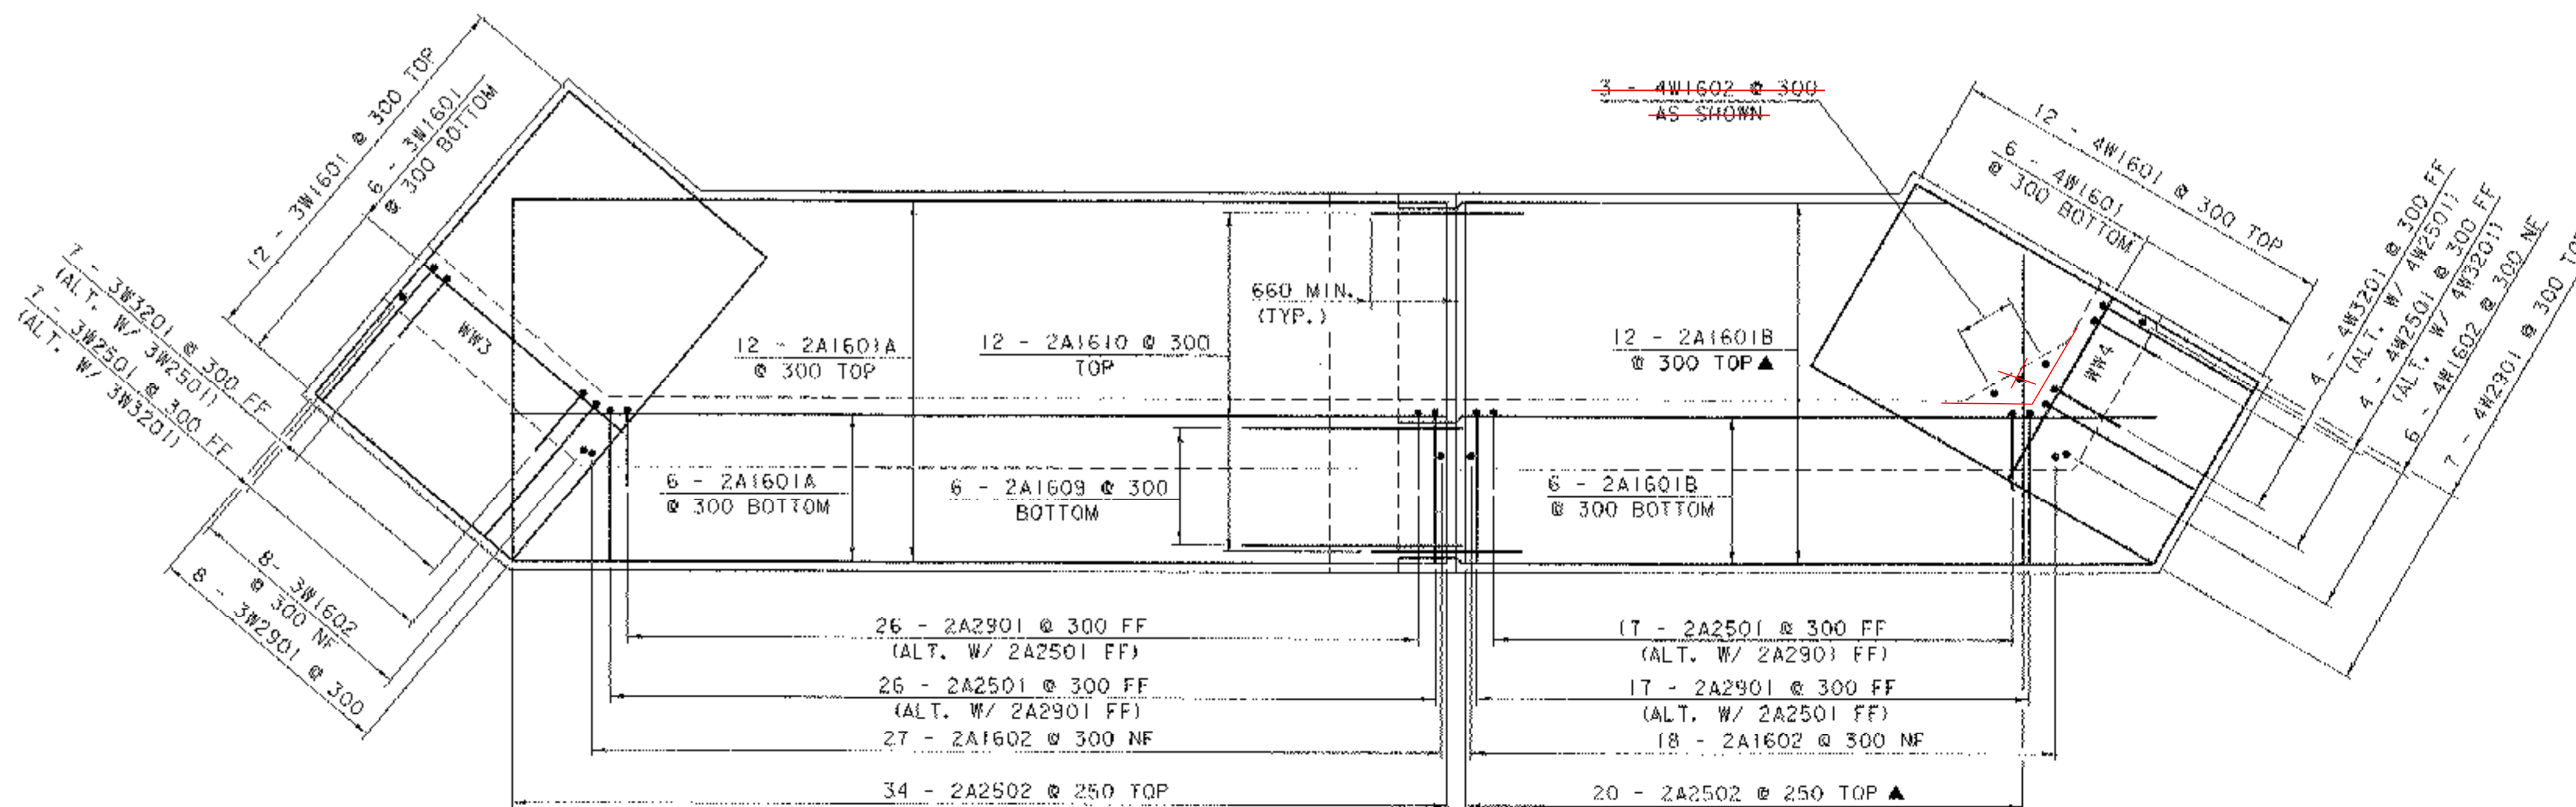


ABUTMENT NO. 1 FOOTING REINFORCING PLAN

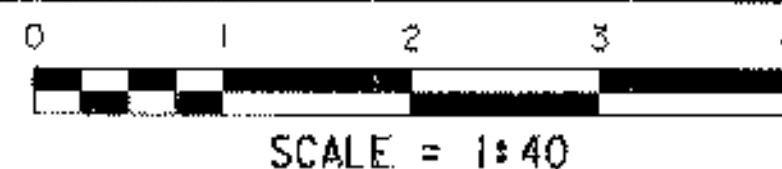

ABUTMENT NO. 2 FOOTING REINFORCING PLAN

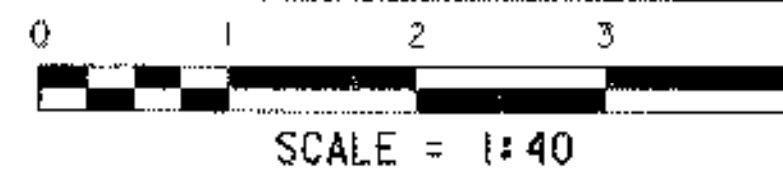

NOTE:

- NF = NEAR FACE
- FF = FAR FACE
- EF = EACH FACE
- ▲ = CUT TO FIT IN FIELD
- 80 CLR. UNLESS OTHERWISE SPECIFIED ON THE PLANS.

FOOTING REINFORCING PLAN

PROJECT NAME:	LYNDON	PLOT DATE:	29-NOV-2005
PROJECT NUMBER:	BRS 0269 (8)S	DRAWN BY:	L. BULLOCK
FILE NAME:	85e04\Structures\se04ftg.I	CHECKED BY:	S. SCRIBNER
PROJECT MANAGER:	R. R. WHITCOMB	SHEET	46 OF 68
DESIGNED BY:	S. SCRIBNER		