




WINGWALL NO. 2 ELEVATION

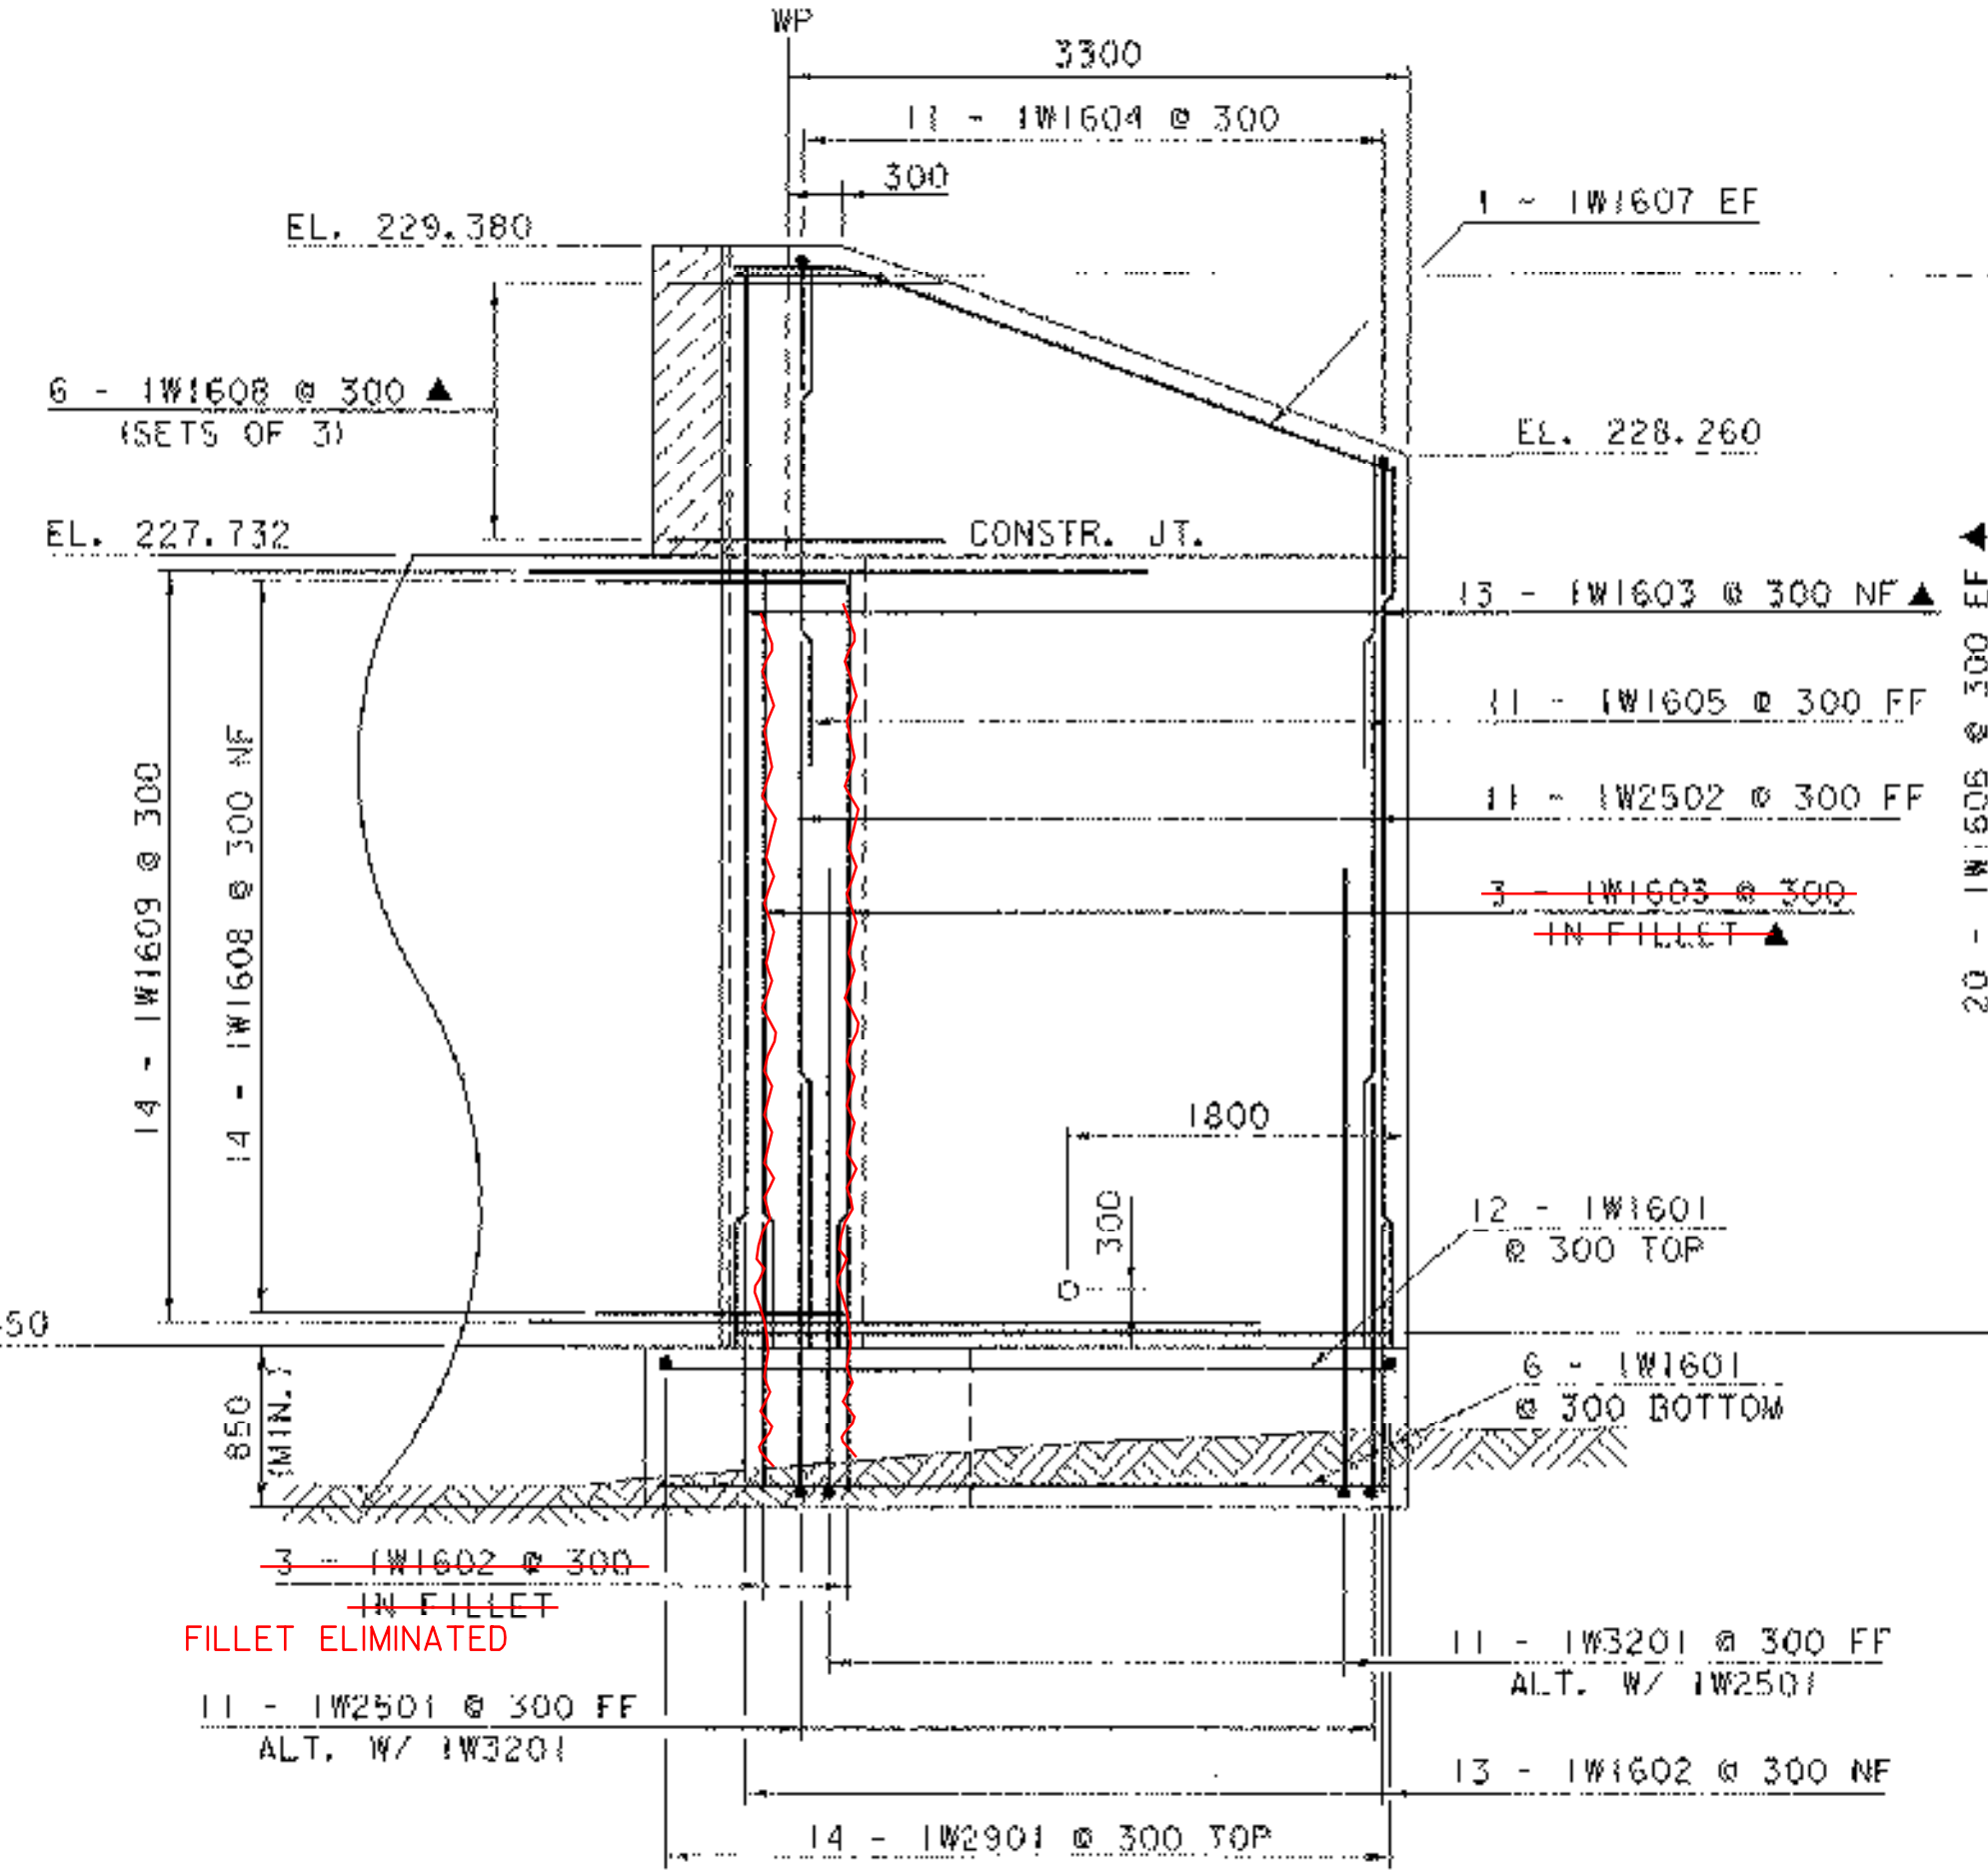

WINGWALL NO. 1 ELEVATION

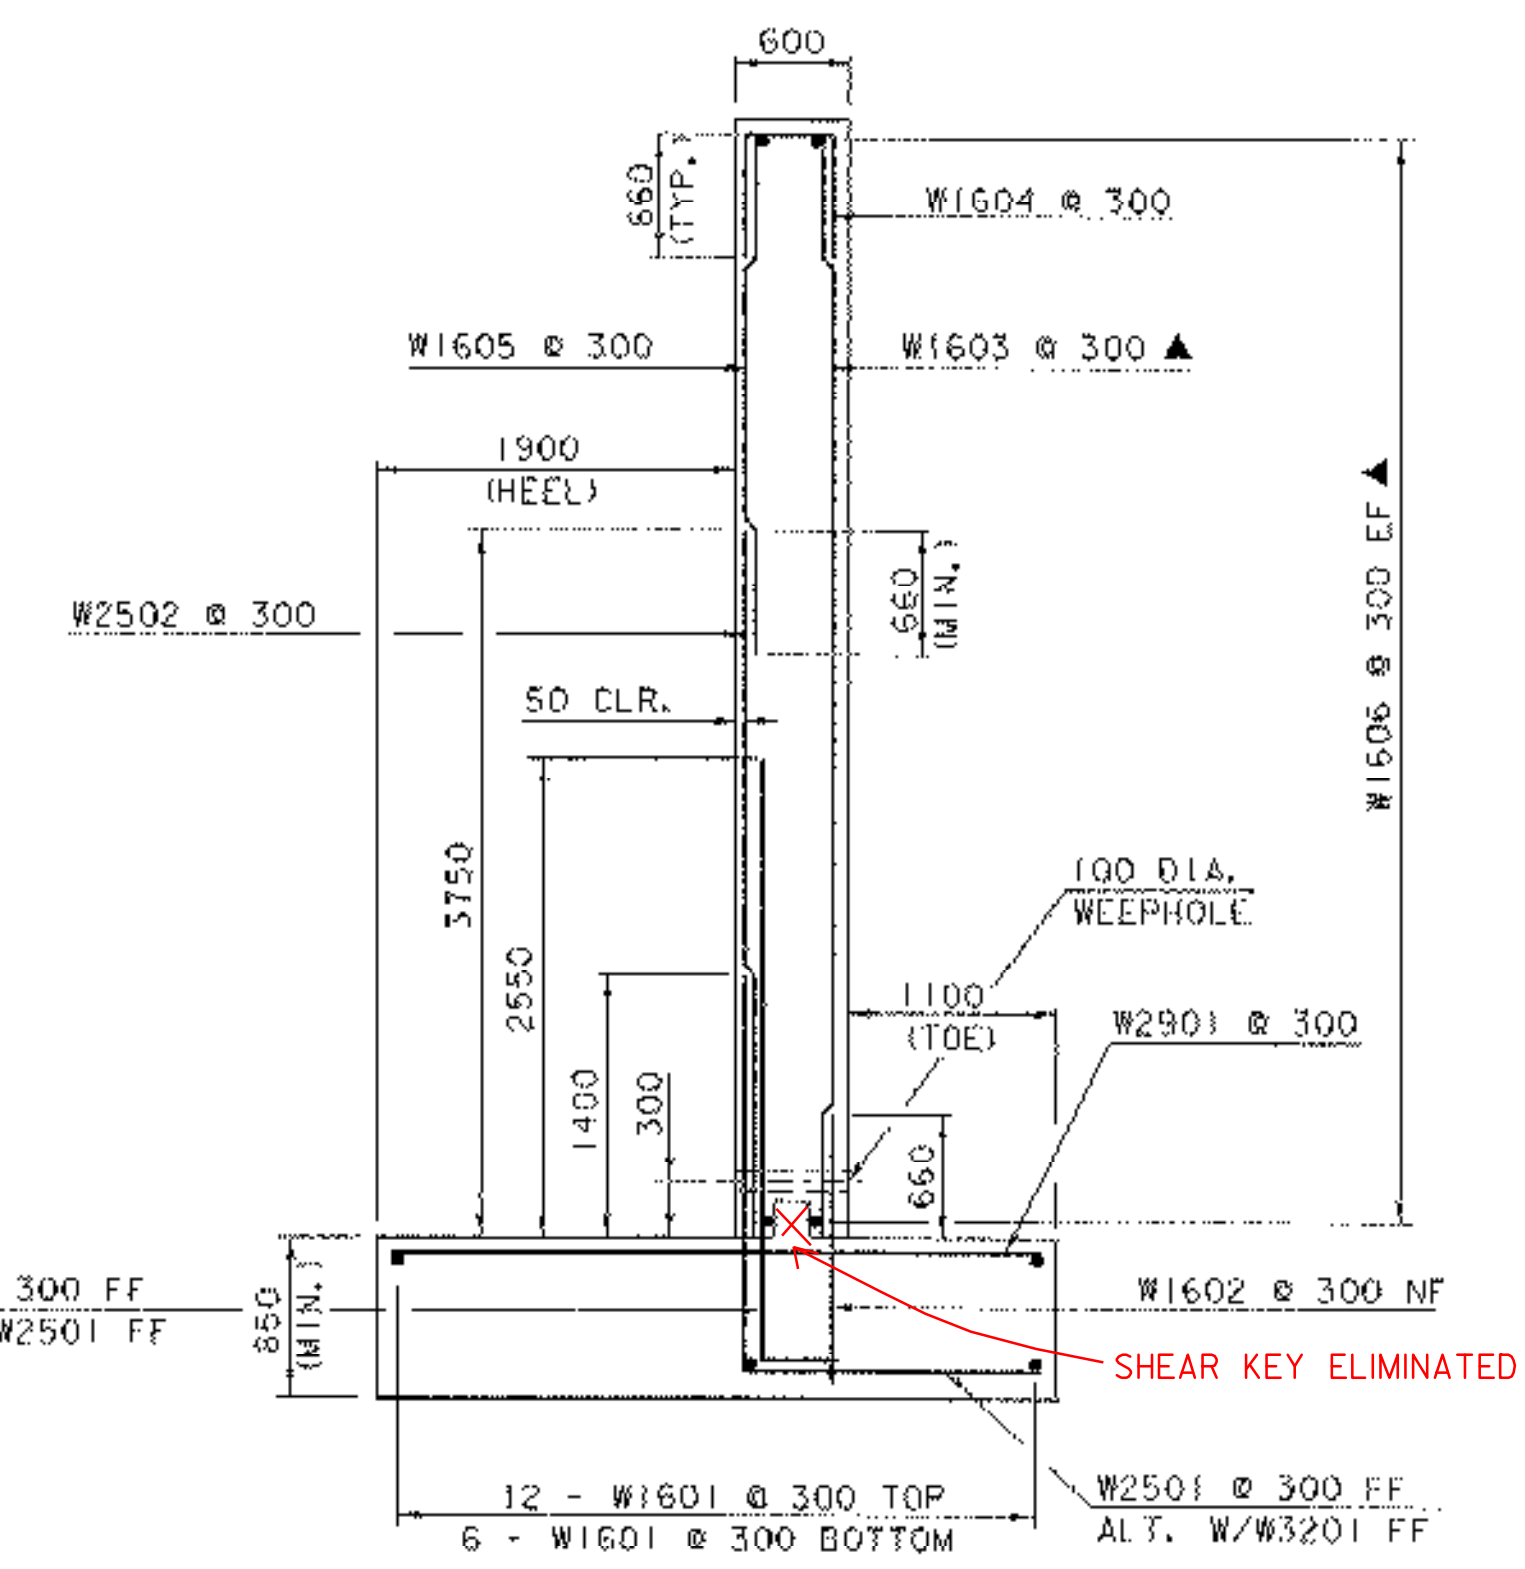


WINGWALL TYPICAL

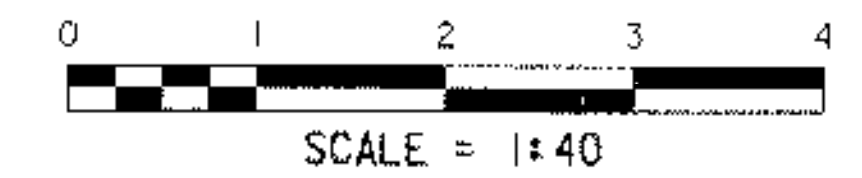


NOTE:

- NF = NEAR FACE
- FF = FAR FACE
- EF = EACH FACE
- ▲ = CUT TO FIT IN FIELD
- 80 CLR. UNLESS OTHERWISE SPECIFIED ON THE PLANS.

WINGWALL DETAILS

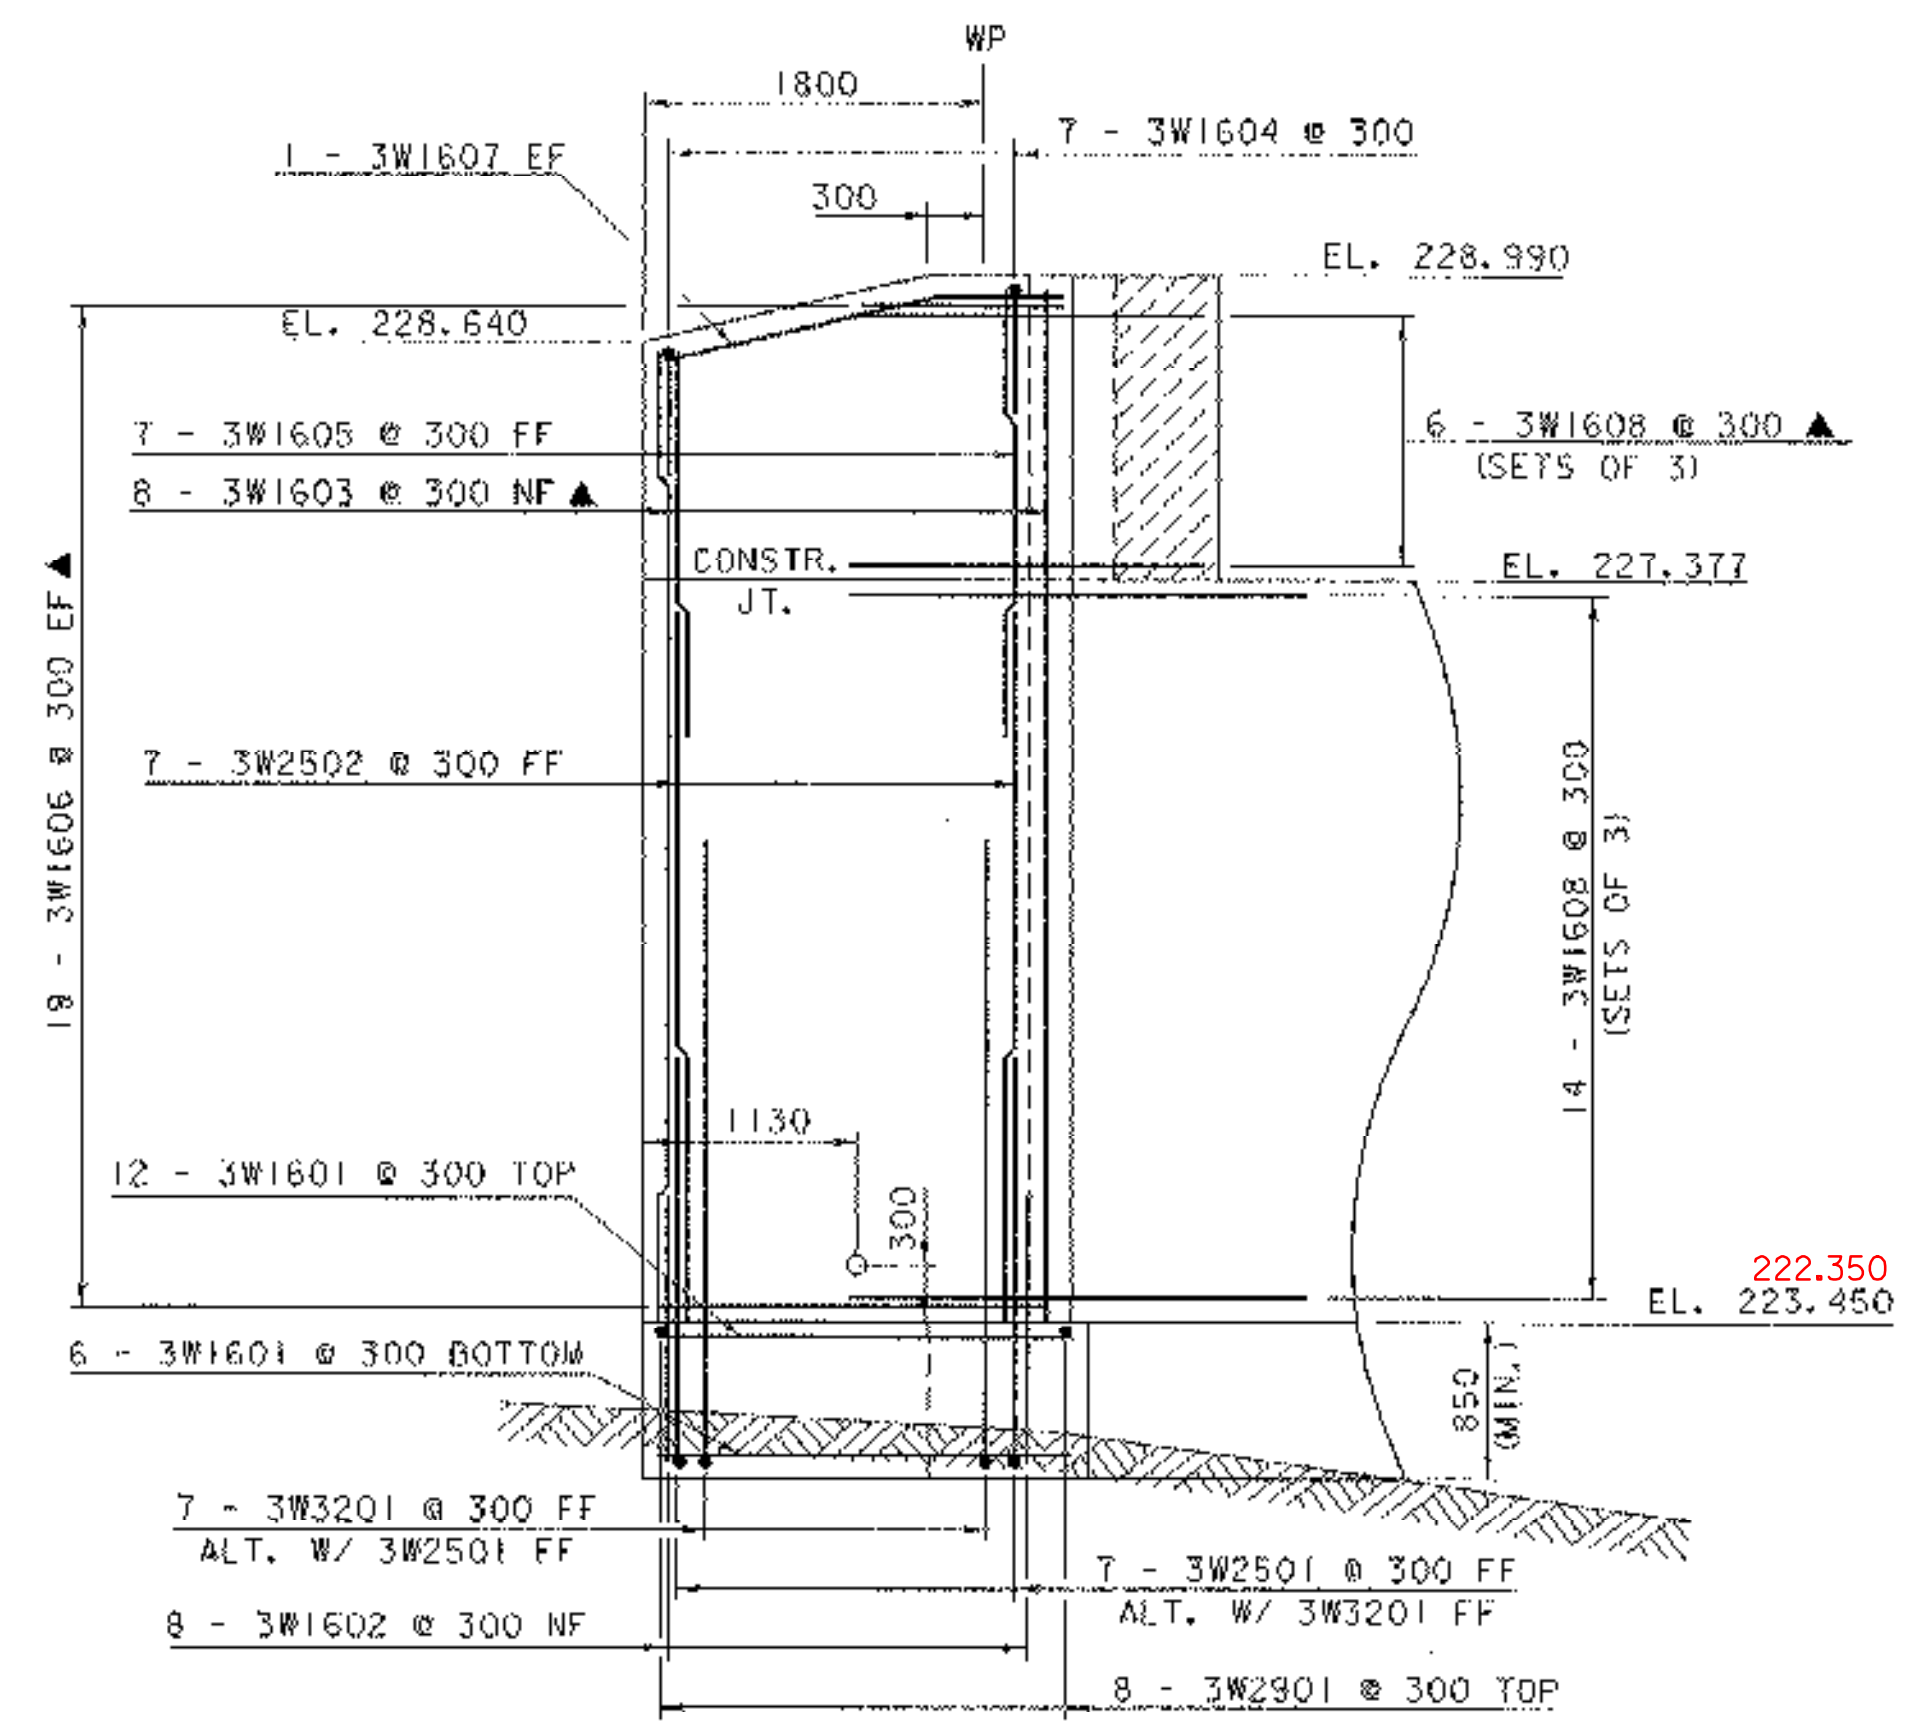

WINGWALL NO. 3 ELEVATION

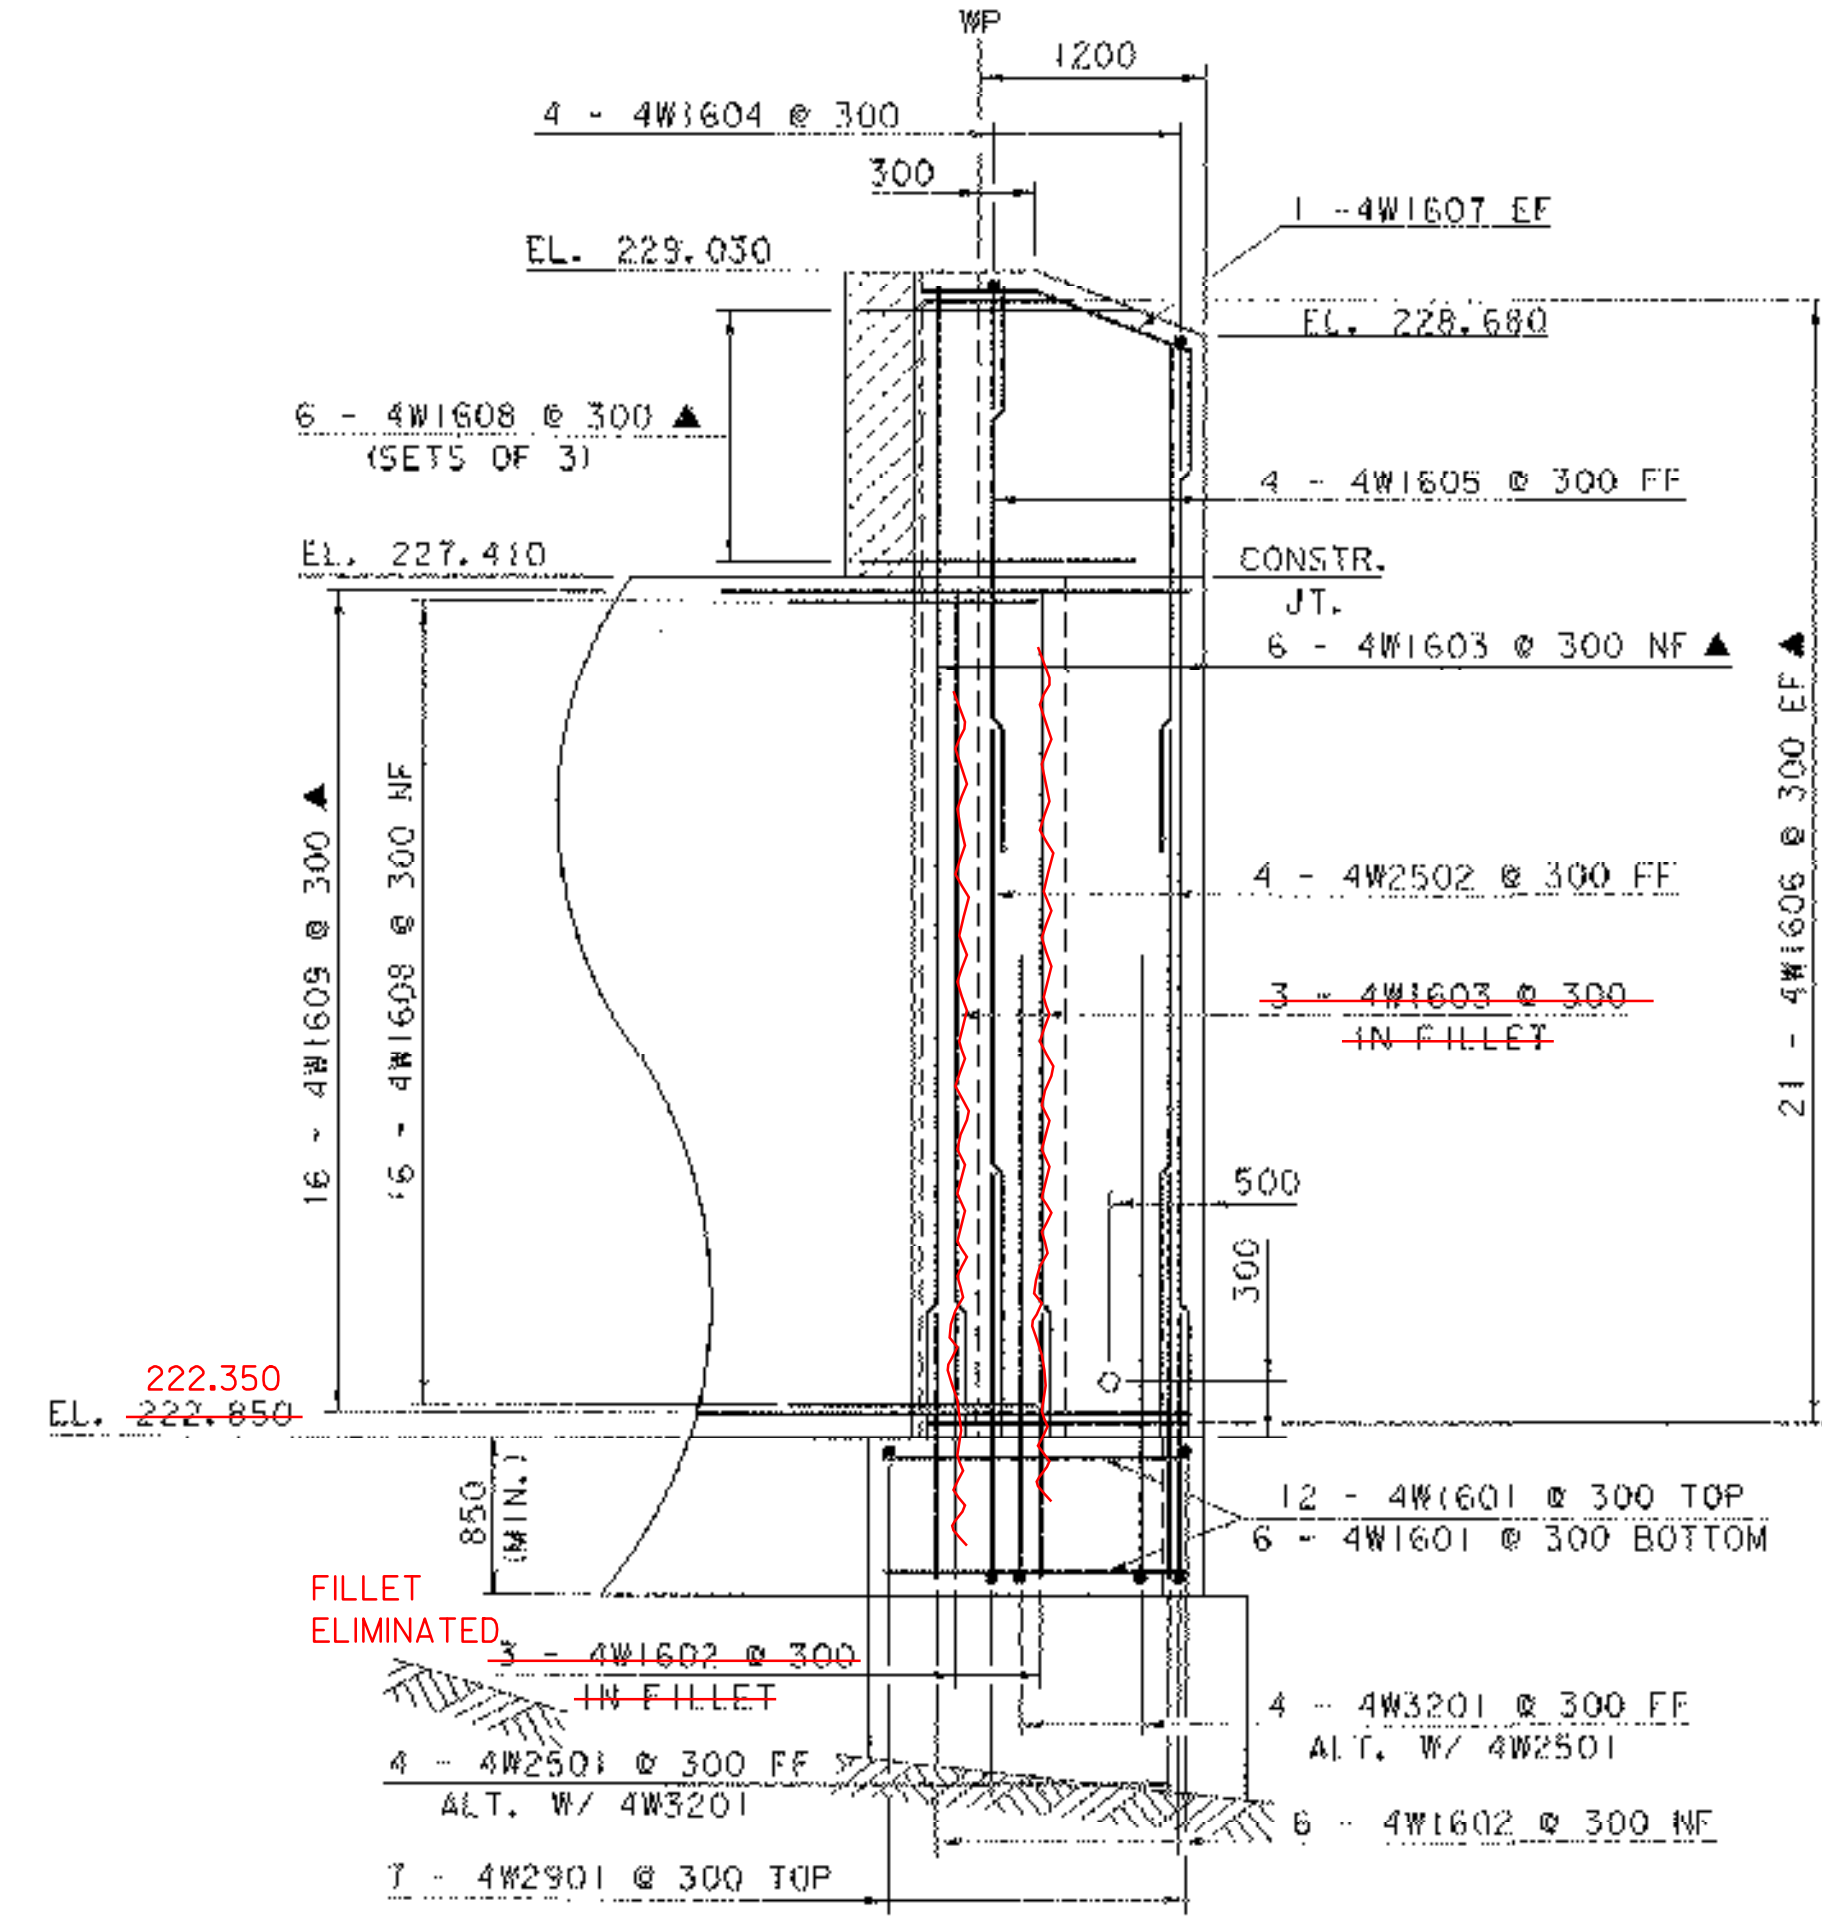

WINGWALL NO. 4 ELEVATION

PROJECT NAME:	LYNDON	PLOT DATE:	29-NOV-2005
PROJECT NUMBER:	BR5 0269 (8)	DRAWN BY:	L. BULLOCK
FILE NAME:	85e04\structures\se04\wll	CHECKED BY:	S. SCRIBNER
PROJECT MANAGER:	R. R. WHITCOMB	SHEET	48 OF 68
DESIGNED BY:	S. SCRIBNER		