


ITEM	QTY	UNIT	DESCRIPTION
1	1.00	sq. ft.	50 TOPSOIL (SEED AND MULCH)
2	1.00	sq. ft.	15% AGGREGATE SURFACE COURSE
3	1.00	sq. ft.	15% AGGREGATE SURFACE COURSE
4	1.00	sq. ft.	15% AGGREGATE SURFACE COURSE
5	1.00	sq. ft.	15% AGGREGATE SURFACE COURSE
6	1.00	sq. ft.	15% AGGREGATE SURFACE COURSE
7	1.00	sq. ft.	15% AGGREGATE SURFACE COURSE
8	1.00	sq. ft.	15% AGGREGATE SURFACE COURSE
9	1.00	sq. ft.	15% AGGREGATE SURFACE COURSE
10	1.00	sq. ft.	15% AGGREGATE SURFACE COURSE

SEE FULL SIZED PLANS FOR RECORD FINAL X-SECTIONS (SHEETS 51-68)

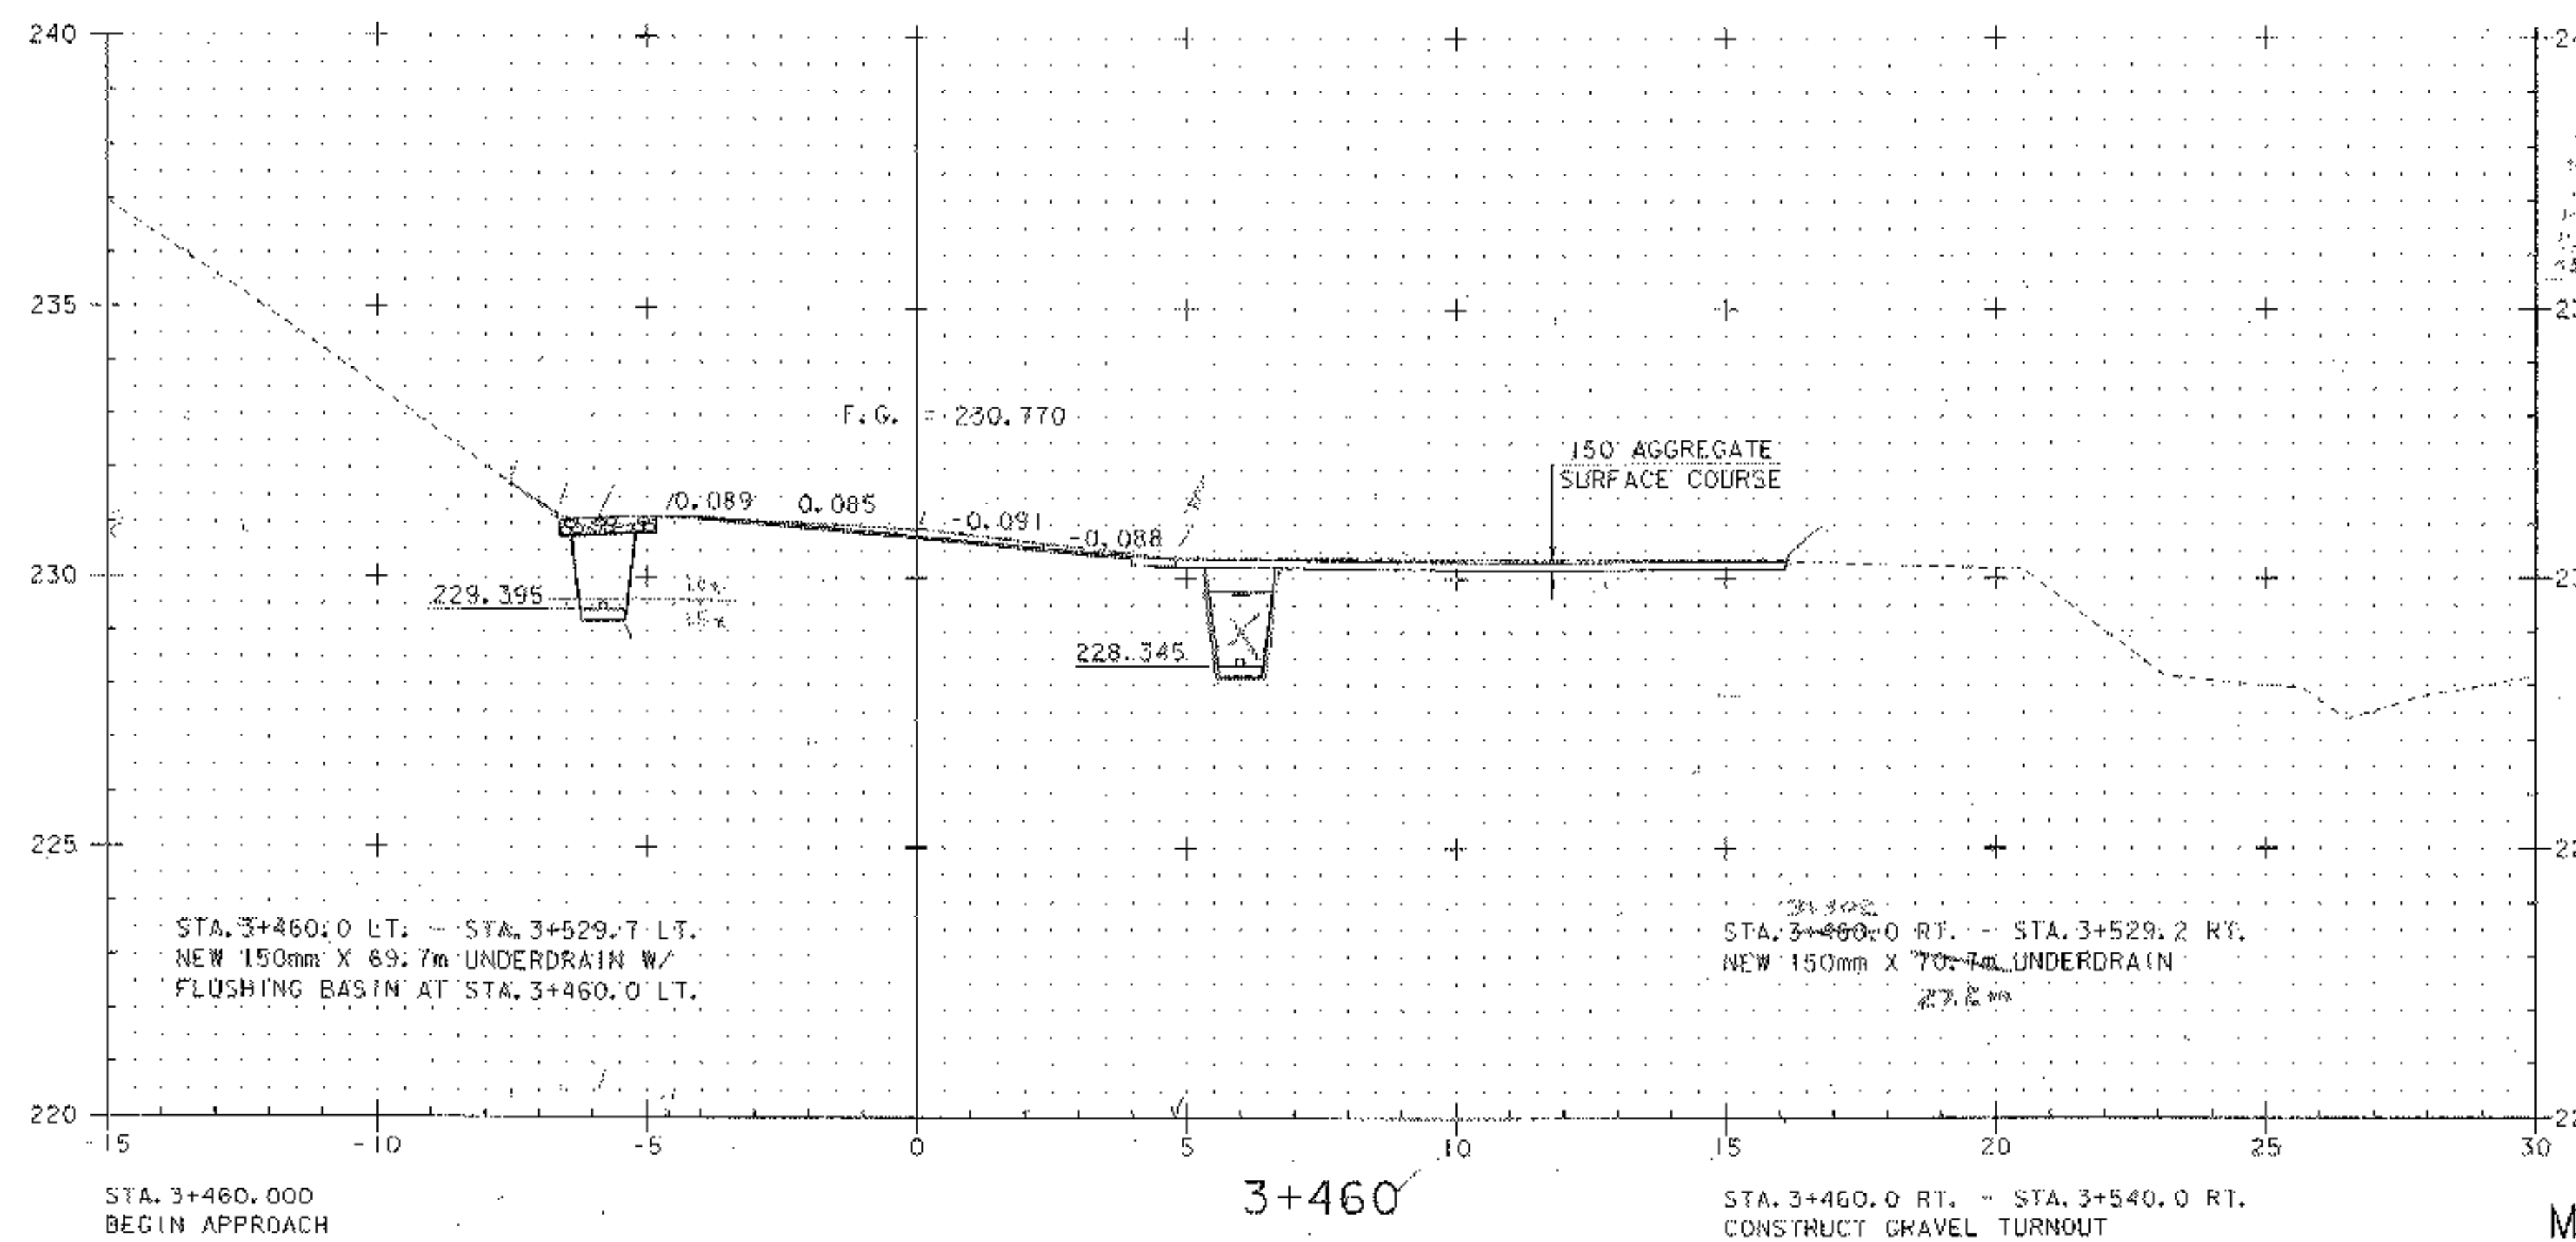


ITEM	QTY	UNIT	DESCRIPTION
1	1.00	sq. ft.	150 AGGREGATE SURFACE COURSE
2	1.00	sq. ft.	15% AGGREGATE SURFACE COURSE
3	1.00	sq. ft.	15% AGGREGATE SURFACE COURSE
4	1.00	sq. ft.	15% AGGREGATE SURFACE COURSE
5	1.00	sq. ft.	15% AGGREGATE SURFACE COURSE
6	1.00	sq. ft.	15% AGGREGATE SURFACE COURSE
7	1.00	sq. ft.	15% AGGREGATE SURFACE COURSE
8	1.00	sq. ft.	15% AGGREGATE SURFACE COURSE
9	1.00	sq. ft.	15% AGGREGATE SURFACE COURSE
10	1.00	sq. ft.	15% AGGREGATE SURFACE COURSE

STA. 3+460.000  
BEGIN APPROACH  
MATCH EXISTING GRADE AND BANKING

STA. 3+460.0 LT. - STA. 3+530.0 LT.  
CONSTRUCT STONE LINED DITCH

STA. 3+460.0 RT. - STA. 3+540.0 RT.  
CONSTRUCT GRAVEL TURNOUT

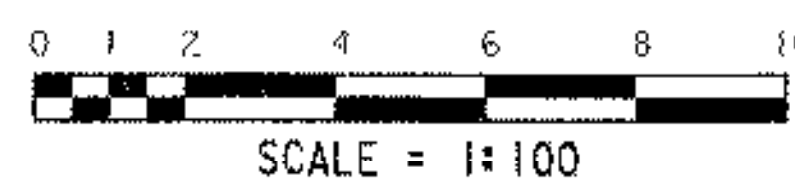

**MAINLINE CROSS SECTIONS (1)**

PROJECT NAME:	LYNDON	FILE NAME:	85e04\Structures\85e04\m01	PLOT DATE:	29-NOV-2005
PROJECT NUMBER:	BRS 0269 (8)S	PROJECT MANAGER:	R. R. WHITCOMB	DRAWN BY:	G. ROY
		DESIGNED BY:	G. ROY	CHECKED BY:	M. LOZIER
		STA. 3+460 TO STA. 3+470		SHEET	51 OF 68