

GEOTECH JOB		DENSE GRAVEL		COMMON EX	
LT	RT	LT	RT	LT	RT
17	17	17	17	18	18
18	18	18	18	19	19
19	19	19	19	20	20
20	20	20	20	21	21
21	21	21	21	22	22
22	22	22	22	23	23
23	23	23	23	24	24
24	24	24	24	25	25
25	25	25	25	26	26
26	26	26	26	27	27
27	27	27	27	28	28
28	28	28	28	29	29
29	29	29	29	30	30

Trench LT (0-15m)
 16 17
 34 34
 17 18
 36 36
 6 6
 12 12
 6 6
 11 11


Trench RT (0-15m)
 11 11
 22 22
 11 11
 22 22

LT (15m)
 6 6
 12 12
 6 6
 11 11

RT (15m)
 6 6
 12 12
 6 6
 11 11

STA. 3+505.000
 END APPROACH
 BEGIN PROJECT

3+510

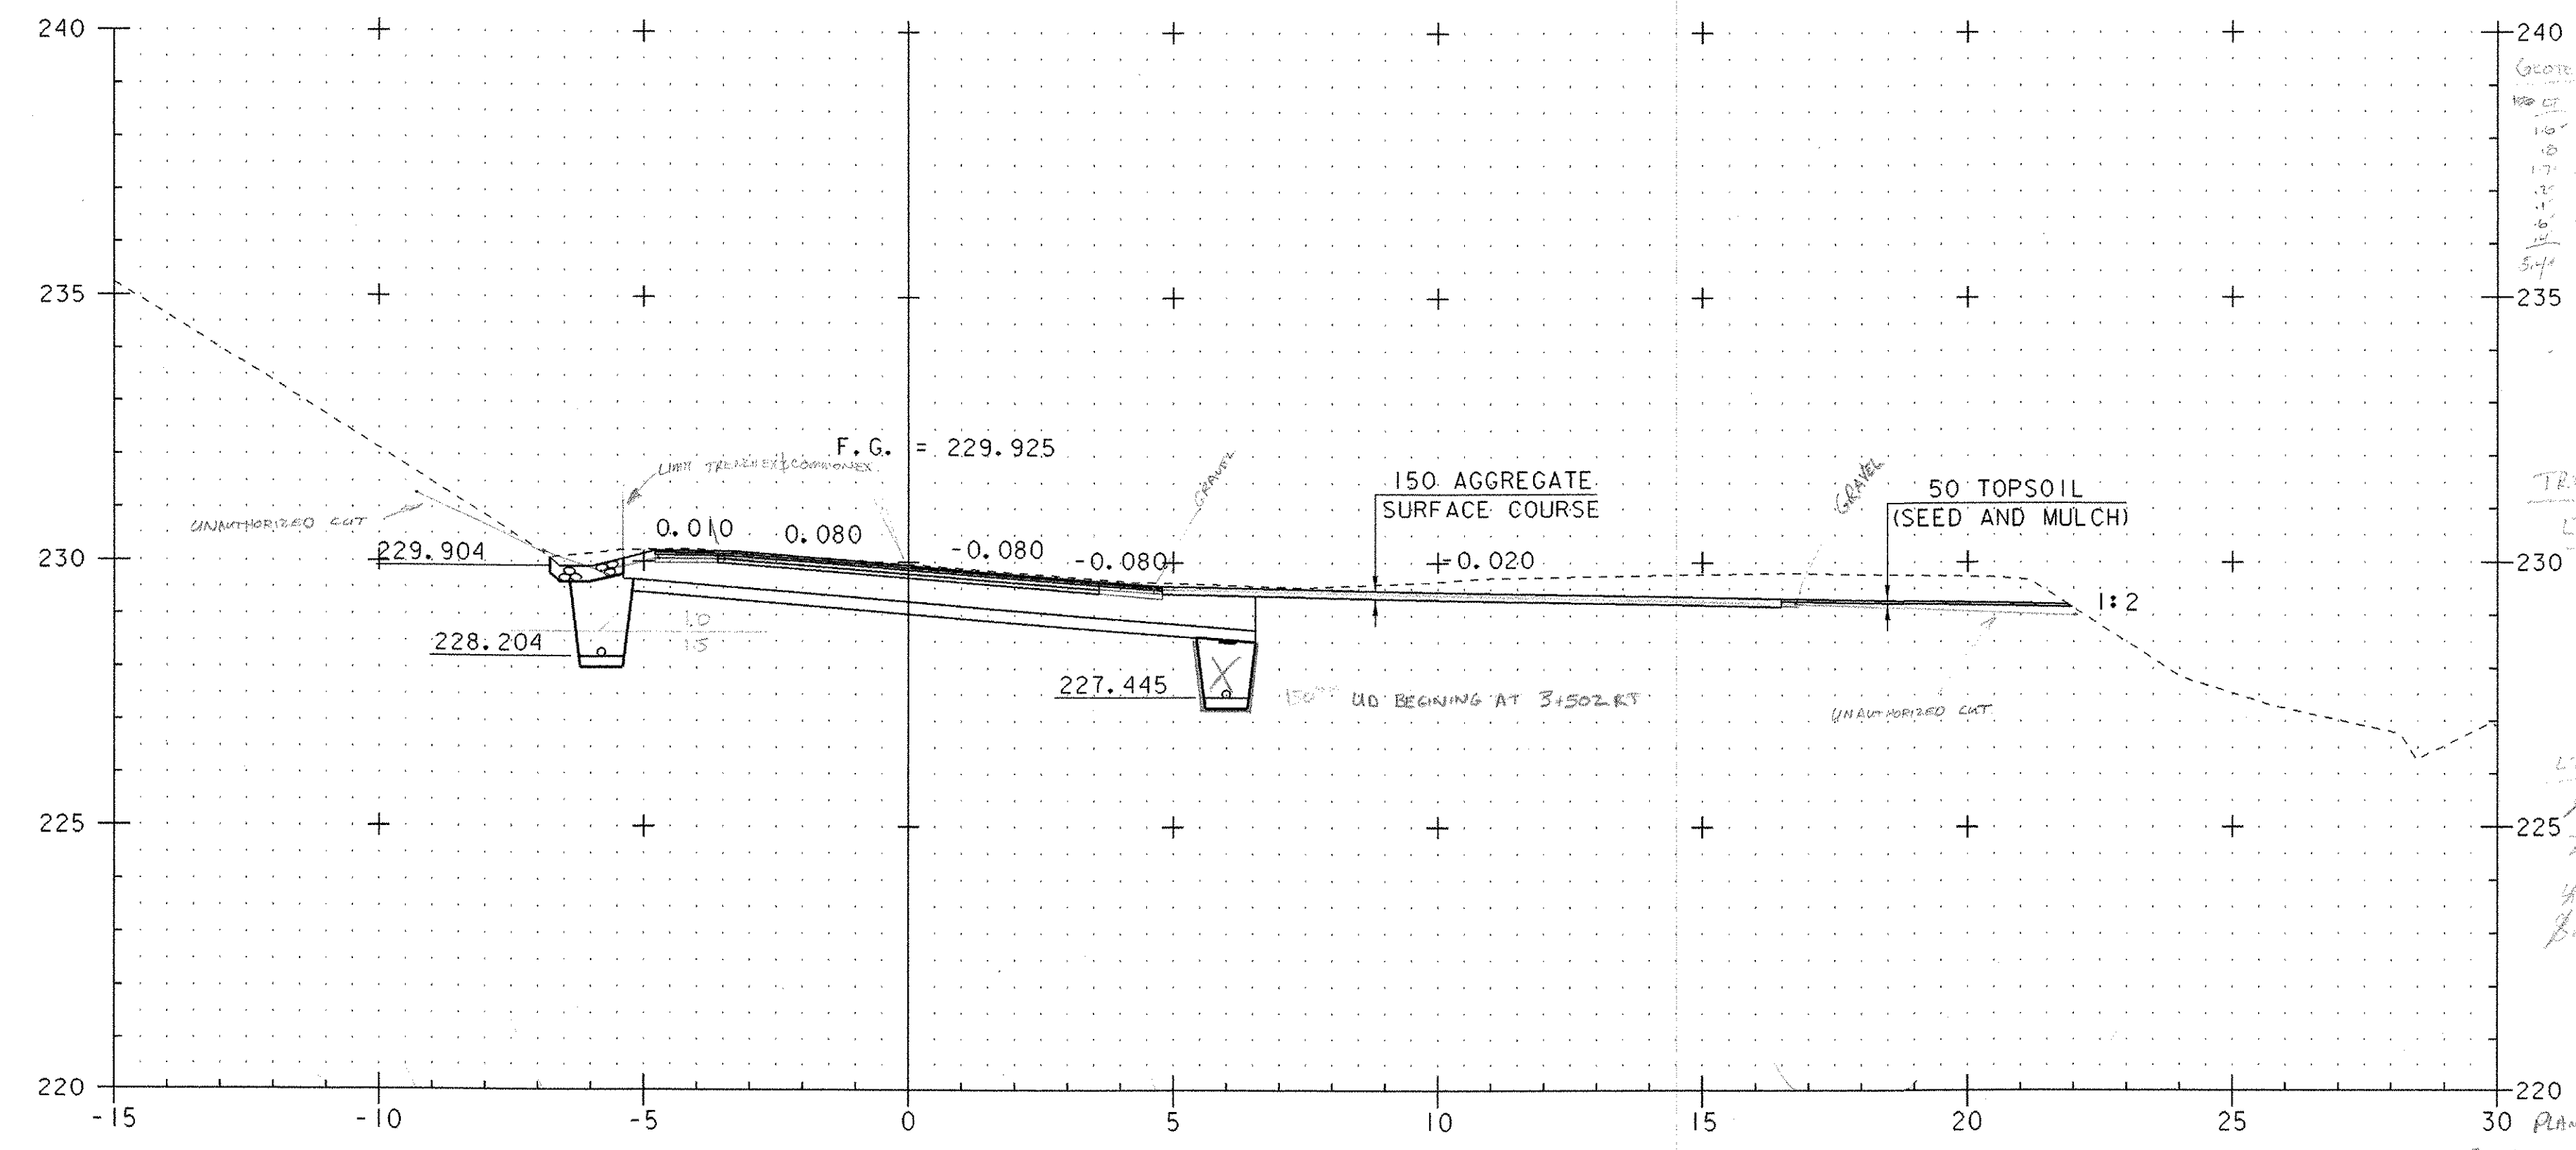

GEOTECH JOB		DENSE GRAVEL		COMMON EX	
LT	RT	LT	RT	LT	RT
17	17	17	17	18	18
18	18	18	18	19	19
19	19	19	19	20	20
20	20	20	20	21	21
21	21	21	21	22	22
22	22	22	22	23	23
23	23	23	23	24	24
24	24	24	24	25	25
25	25	25	25	26	26
26	26	26	26	27	27
27	27	27	27	28	28
28	28	28	28	29	29
29	29	29	29	30	30


Trench LT (0-15m)
 17 18
 36 36
 18 18
 36 36
 11 11
 22 22
 46 46
 11 11
 22 22
 46 46
 11 11
 22 22

Trench RT (0-15m)
 17 18
 36 36
 18 18
 36 36
 11 11
 22 22
 46 46
 11 11
 22 22

LT (15m)
 11 11
 22 22
 46 46
 11 11
 22 22

RT (15m)
 11 11
 22 22
 46 46
 11 11
 22 22

3+500

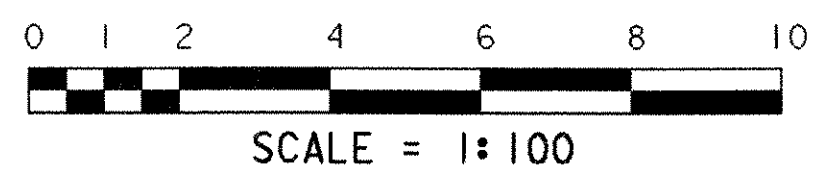

MAINLINE CROSS SECTIONS (3)

PROJECT NAME: LYNDON
 PROJECT NUMBER: BRS 0269 (8)S
 FILE NAME: 85e04\Structures\se04im03.1 PLOT DATE: 29-NOV-2005
 PROJECT MANAGER: R. R. WHITCOMB DRAWN BY: G. ROY
 DESIGNED BY: G. ROY CHECKED BY: M. LOZIER
 STA. 3+500 TO STA. 3+510 SHEET 53 OF 68