


DEANE GRAVEL (3'x4')		COMMON EY (8.5'x4' - 8.2'x4')	
STATION	WIDTH	STATION	WIDTH
125	12.5	129	12.5
127	12.5	129	12.5
128	12.5	129	12.5
129	12.5	129	12.5
130	12.5	129	12.5
131	12.5	129	12.5
132	12.5	129	12.5
133	12.5	129	12.5
134	12.5	129	12.5
135	12.5	129	12.5

DEANE GRAVEL (FORWARD)  
8'x4' - 3'x4'

DEANE GRAVEL (FORWARD)  
8'x4' - 3'x4'

DEANE GRAVEL (FORWARD)  
8'x4' - 3'x4'

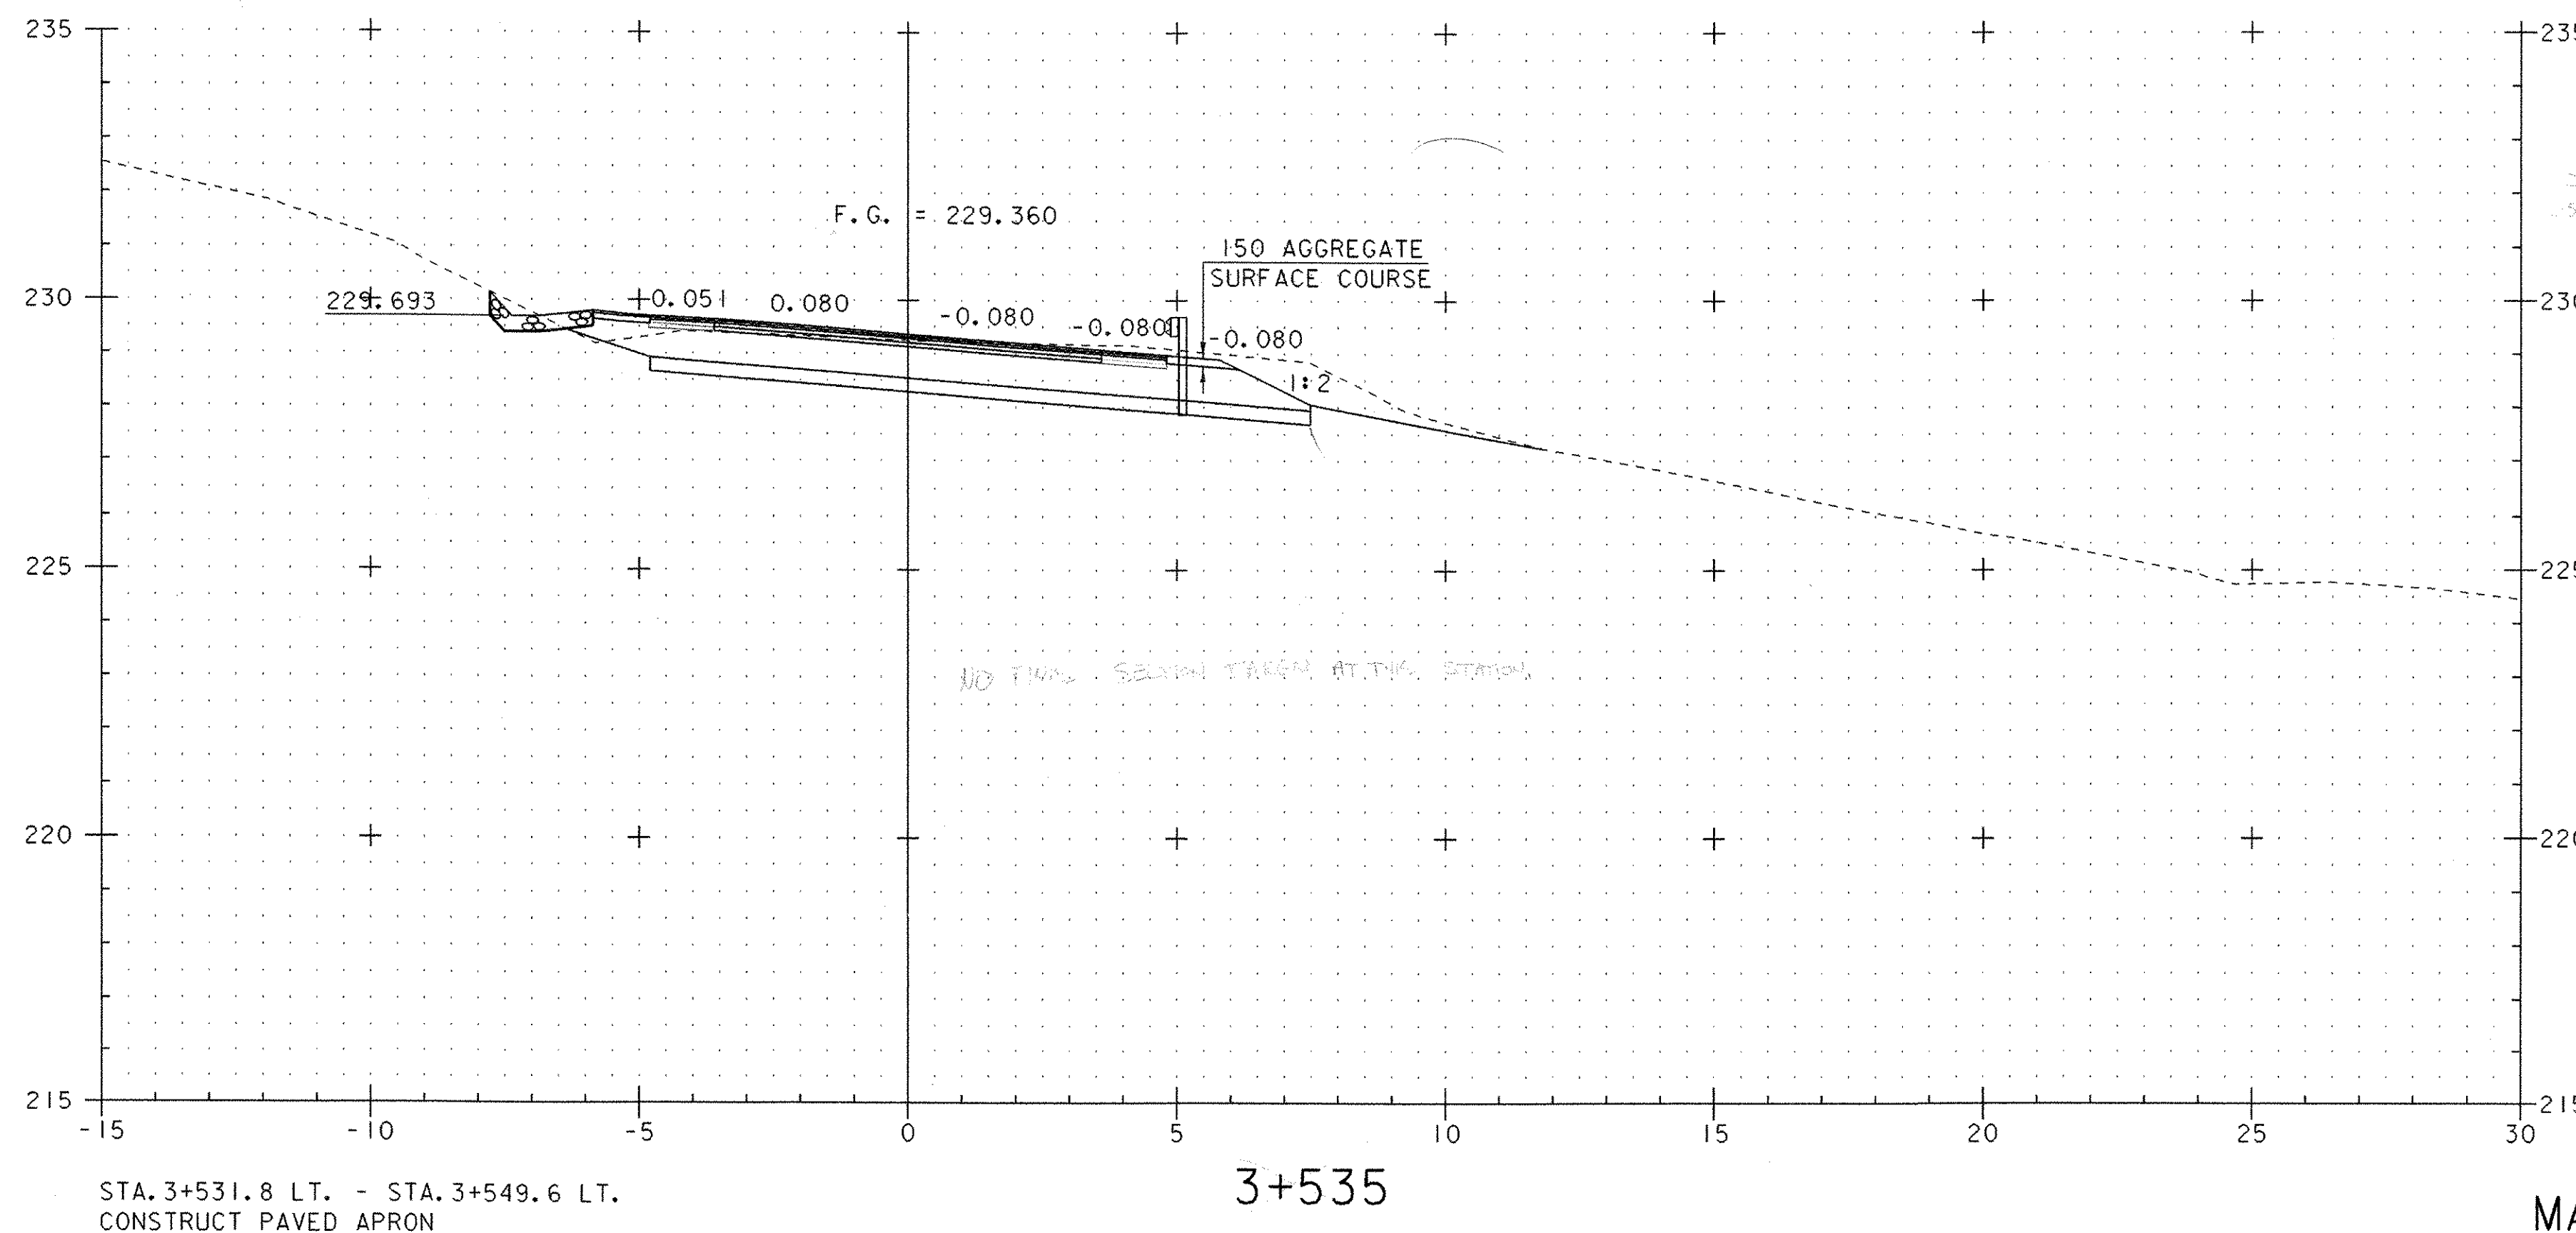

PLANNED BY GJ 11-10-05  
PLANNED BY RRM 12-6-05

**MAINLINE CROSS SECTIONS (5)**

PROJECT NAME:	LYNDON
PROJECT NUMBER:	BRS 0269 (8)S
FILE NAME:	85e04\Structures\se04im05.i
PROJECT MANAGER:	R. R. WHITCOMB
DESIGNED BY:	G. ROY
STA. 3+535 TO STA. 3+540	
PLOT DATE:	29-NOV-2005
DRAWN BY:	G. ROY
CHECKED BY:	M. LOZIER
SHEET	55 OF 68

