


STA. 3+550.481
BEGIN BRIDGE

MAINLINE CROSS SECTIONS (7)

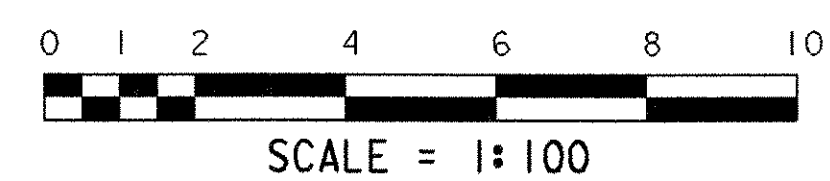

PROJECT NAME:	LYNDON
PROJECT NUMBER:	BRS 0269 (8)S
FILE NAME:	85e04\Structures\se04m07.i
PROJECT MANAGER:	R. R. WHITCOMB
DESIGNED BY:	G. ROY
STA. 3+555 TO STA. 3+570	
DRAWN BY:	G. ROY
CHECKED BY:	M. LOZIER
DATE:	29-NOV-2005
SHEET	57 OF 68