


MAINLINE CROSS SECTIONS (10)

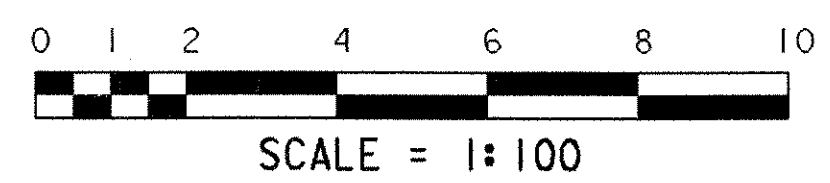

PROJECT NAME:	LYNDON
PROJECT NUMBER:	BRS 0269 (8)S
FILE NAME:	85e04\Structures\se04lm0.i
PROJECT MANAGER:	R. R. WHITCOMB
DESIGNED BY:	G. ROY
STA. 3+670 TO STA. 3+670	
PLOT DATE:	29-NOV-2005
DRAWN BY:	G. ROY
CHECKED BY:	M. LOZIER
SHEET	60 OF 68