


CHANNEL LINE CROSS SECTIONS (1)

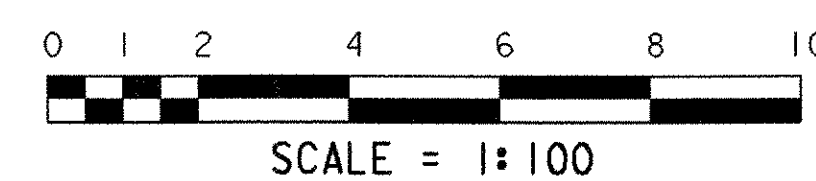

PROJECT NAME:	LYNDON	PLOT DATE:	29-NOV-2005
PROJECT NUMBER:	BRS 0269 (8)S	DRAWN BY:	G. ROY
FILE NAME:	85e04\Structures\se04ic01.1	CHECKED BY:	M. LOZIER
PROJECT MANAGER:	R. R. WHITCOMB	SHEET	63 OF 68
DESIGNED BY:	G. ROY		
STA. 9+975 TO STA. 9+980			