


STA. 9+984.6 RT.
 BEGIN UNCL. CHAN. EXCAVATION
 GEOTEXTILE UNDER STONE FILL
 STONE FILL, TYPE IV
 GRUBBING MATERIAL

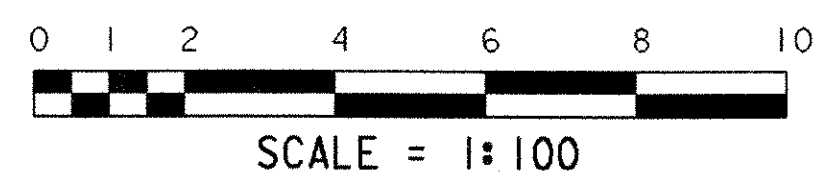

CHANNEL LINE CROSS SECTIONS (2)

PROJECT NAME:	LYNDON	PLLOT DATE:	29-NOV-2005
PROJECT NUMBER:	BRS 0269 (8)S	DRAWN BY:	G. ROY
FILE NAME:	85e04\Structures\se04ic02.i	CHECKED BY:	M. LOZIER
PROJECT MANAGER:	R. R. WHITCOMB	STA. 9+985 TO STA. 9+990	SHEET 64 OF 68
DESIGNED BY:	G. ROY		