


**CHANNEL LINE CROSS SECTIONS (4)**

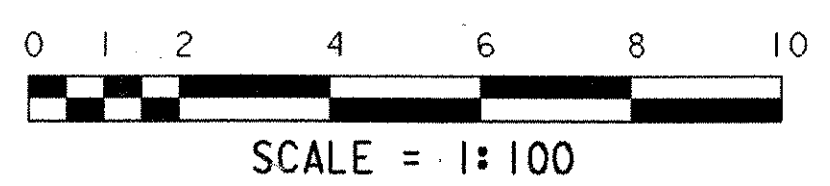

PROJECT NAME:	LYNDON
PROJECT NUMBER:	BRS 0269 (8)S
FILE NAME: 85e04\Structures\se04ic04.i	PLOT DATE: 29-NOV-2005
PROJECT MANAGER: R. R. WHITCOMB	DRAWN BY: G. ROY
DESIGNED BY: G. ROY	CHECKED BY: M. LOZIER
STA. 10+005 TO STA. 10+010	SHEET 66 OF 68