


STA. 10+014.1 RT.
 END UNCL. CHAN. EXCAVATION
 GEOTEXTILE UNDER STONE FILL
 STONE FILL, TYPE IV
 GRUBBING MATERIAL

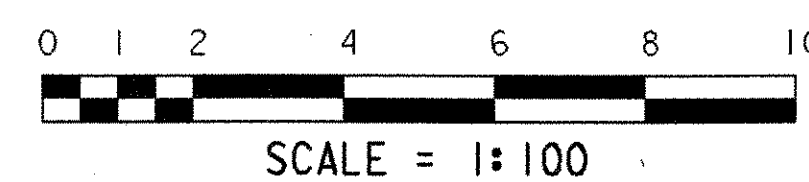

CHANNEL LINE CROSS SECTIONS (5)

PROJECT NAME:	LYNDON	PLOT DATE:	29-NOV-2005
PROJECT NUMBER:	BRS 0269 (8)S	DRAWN BY:	G. ROY
FILE NAME:	85e04\Structures\se04ic05.i	CHECKED BY:	M. LOZIER
PROJECT MANAGER:	R. R. WHITCOMB	STA. 10+015 TO STA. 10+020	SHEET 67 OF 68