


CHANNEL LINE CROSS SECTIONS (6)

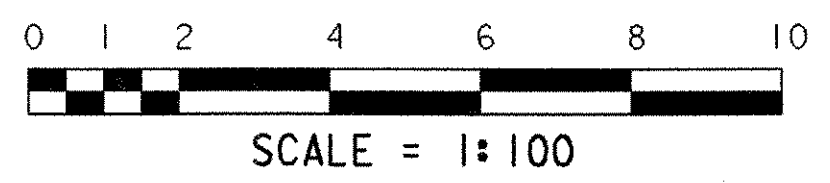

PROJECT NAME:	LYNDON	FILE NAME:	85e04\Structures\se04ic06.i	PLOT DATE:	29-NOV-2005
PROJECT NUMBER:	BRS 0269 (8)S	PROJECT MANAGER:	R. R. WHITCOMB	DRAWN BY:	G. ROY
		DESIGNED BY:	G. ROY	CHECKED BY:	M. LOZIER
		STA. 10+025 TO STA. 10+030		SHEET	68 OF 68