



LIMITS OF ITEM 525.33 BRIDGE RAILING NETC 2 RAIL = 34.938m

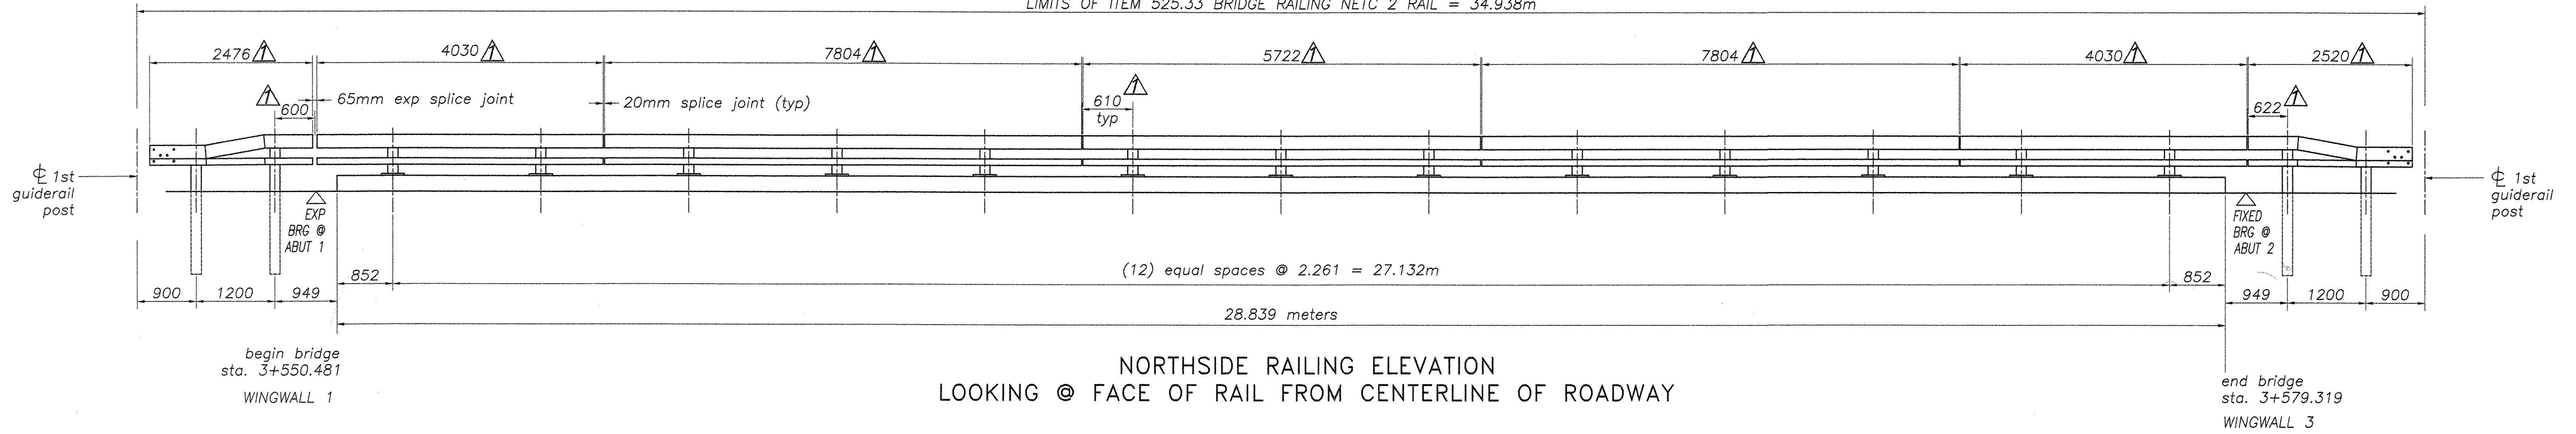

LIMITS OF ITEM 525.33 BRIDGE RAILING NETC 2 RAIL = 34.938m

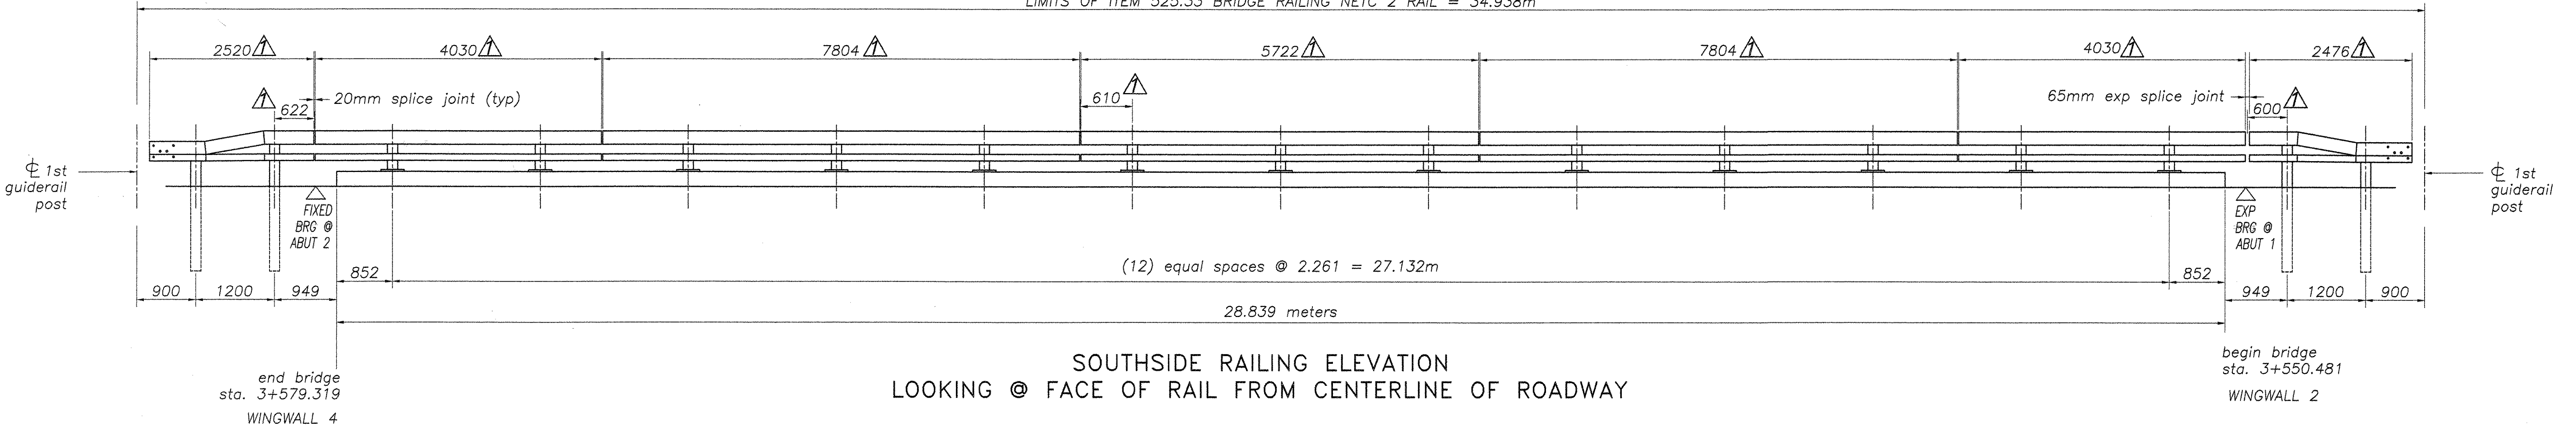

total pay limit (item 525.33) = 70 meters

all dimensions shown are in millimeters (mm) unless otherwise noted

REVISIONS		
No.	Remarks	Date
0	Initial submittal	xx.xx.xx
1	Final Copy w/Approved as Noted Corrections	06.20.06

VTrans - PDD
JUL 0 5 2006
Structures Design
Section

RECORD PLANS

HIGHWAY SAFETY CORP.
GLASTONBURY, CT

item 525.33 NETC 2-rail bridge railing
Town of Lyndon, Vermont
Caledonia County, Route VT 114
Bridge no. 8 over East Branch Passumpsic River
Proj. BRS 0269 (8) S

GENERAL CONTRACTOR
SUB CONTRACTOR
F.R. Lafayette

DRAWN	p. radice
CHECKED	
DATE	5-16-06
SCALE	1/4" = 12'
HSC REFERENCE NO.	1549
SIZE	D
REVISION	1
SHEET NO.	1 of 2



092-BR

RW