


INDEX OF SHEETS  
SEE SHEET 2 OF 144

# STATE OF VERMONT AGENCY OF TRANSPORTATION



## PROPOSED IMPROVEMENT TOWN OF CORNWALL BRIDGE PROJECT COUNTY OF ADDISON VT ROUTE 125 (MAJOR COLLECTOR) BRIDGE NO. 9

BEGINNING AT A POINT ON VT ROUTE 125 APPROXIMATELY 0.60 KILOMETERS EAST OF THE BRIDPORT/CORNWALL TOWN LINE  
EXTENDING SOUTHERLY THEN EASTERLY ALONG VT ROUTE 125 FOR A DISTANCE OF 320 METERS AND ON TOWN HIGHWAY 33, BEGINNING  
AT ITS INTERSECTION WITH VT 125 AND EXTENDING SOUTHERLY FOR A DISTANCE OF 90 METERS  
LENGTH OF ROADWAY = 274.00 m 0.274 km  
LENGTH OF BRIDGE = 46.00 m 0.046 km  
LENGTH OF PROJECT = 320.00 m 0.320 km

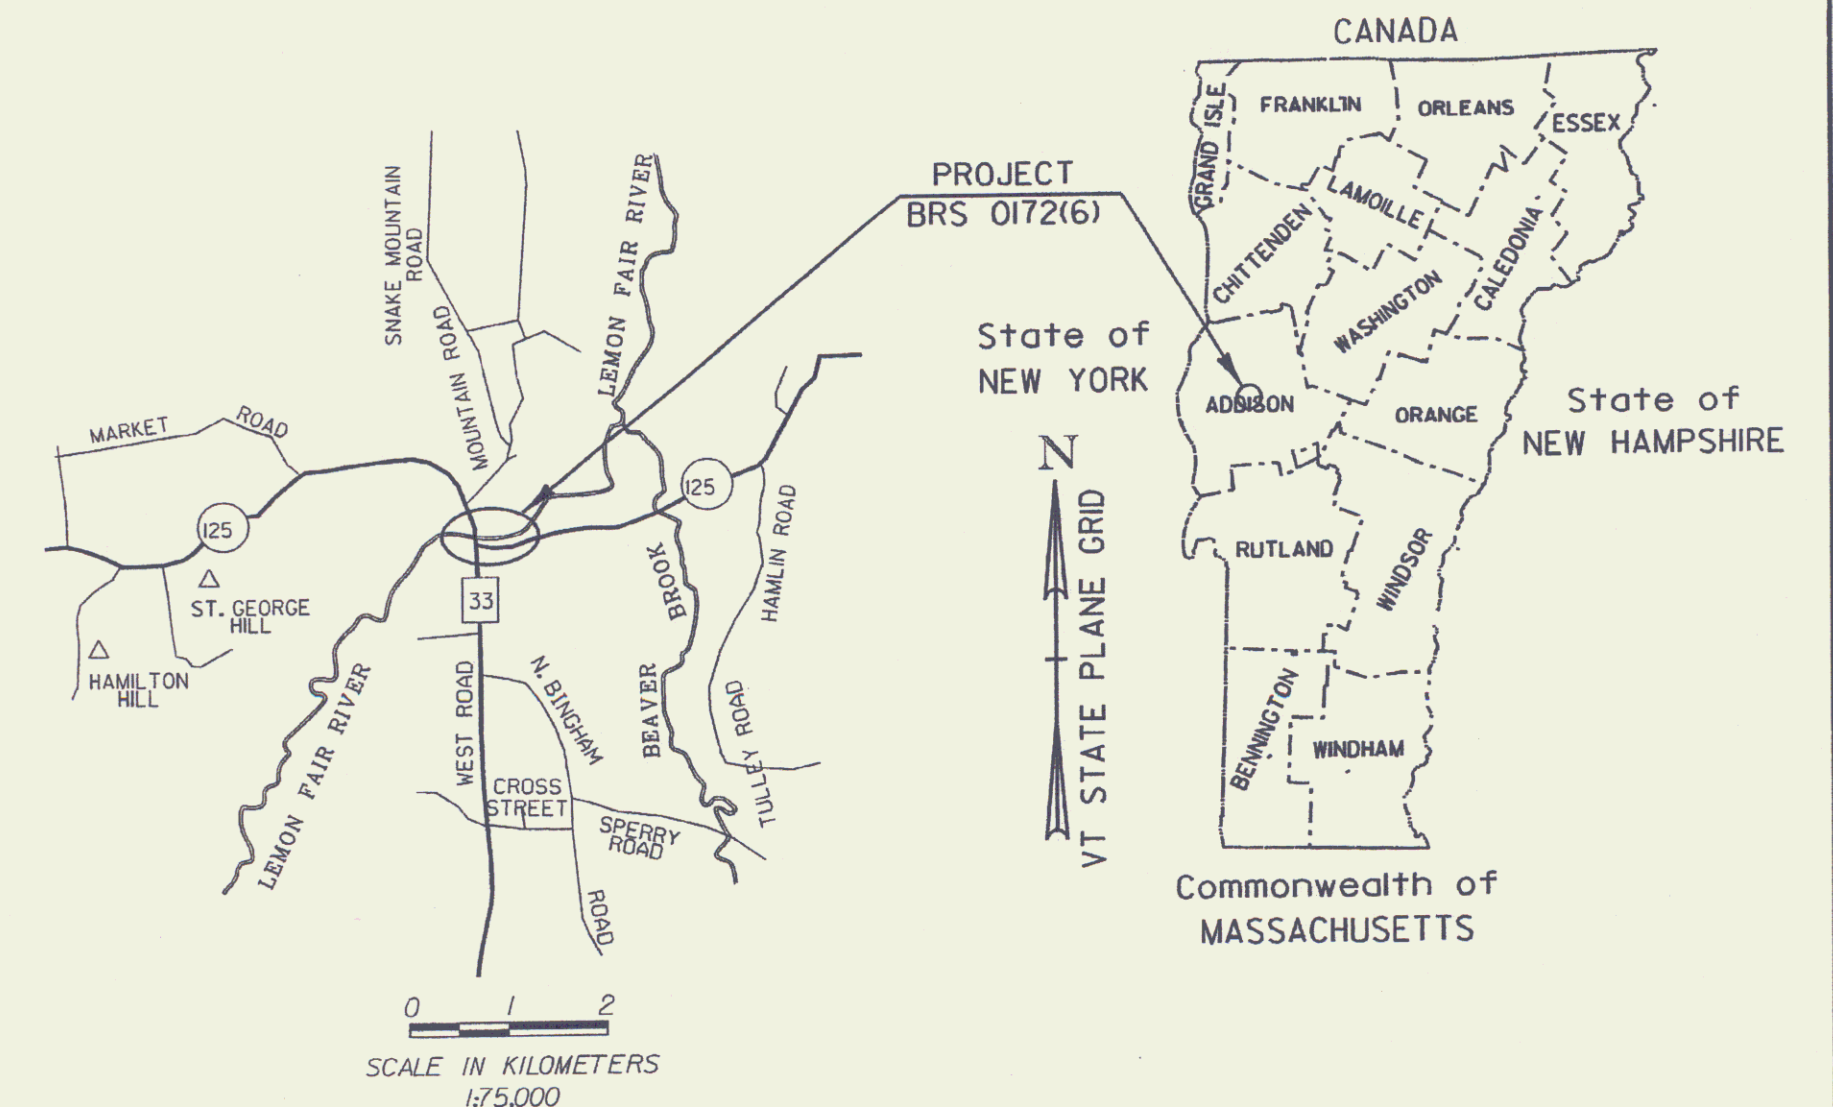

**RECORD PLANS**

CONTRACTOR: AL ST ONGE CONTRACTOR INC. - MONTGOMERY, VT

RESIDENT ENGINEER: JOE KNIPES

CONSTRUCTION BEGAN: JUNE 3, 2010

CONSTRUCTION COMPLETE: NOVEMBER 18, 2011

RECORD PLANS BY: JOE KNIPES & JENNA HYDE


I HEREBY CERTIFY THAT ALL THE CONSTRUCTION REQUIRED BY THIS SET OF DRAWINGS HAS BEEN ACCOMPLISHED AS INDICATED HEREIN.

BY [Signature] RESIDENT ENGINEER

DATE 5-21-13

NOTE: Any further information concerning final quantities, amounts or other details relative to this project may be found at Central Files in the electronic archives.

WORK TO BE PERFORMED UNDER THIS PROJECT INCLUDES REPLACEMENT OF BRIDGE #9, CONSTRUCTION OF A SINGLE SPAN PLATE GIRDER SUPERSTRUCTURE ON INTEGRAL ABUTMENTS, CONSTRUCTION OF TEMPORARY BRIDGE AND TEMPORARY DETOUR APPROACHES, RECONSTRUCTION OF ROADWAY APPROACHES AND COLD PLANING OF VT ROUTE 125 AND T.H. 33

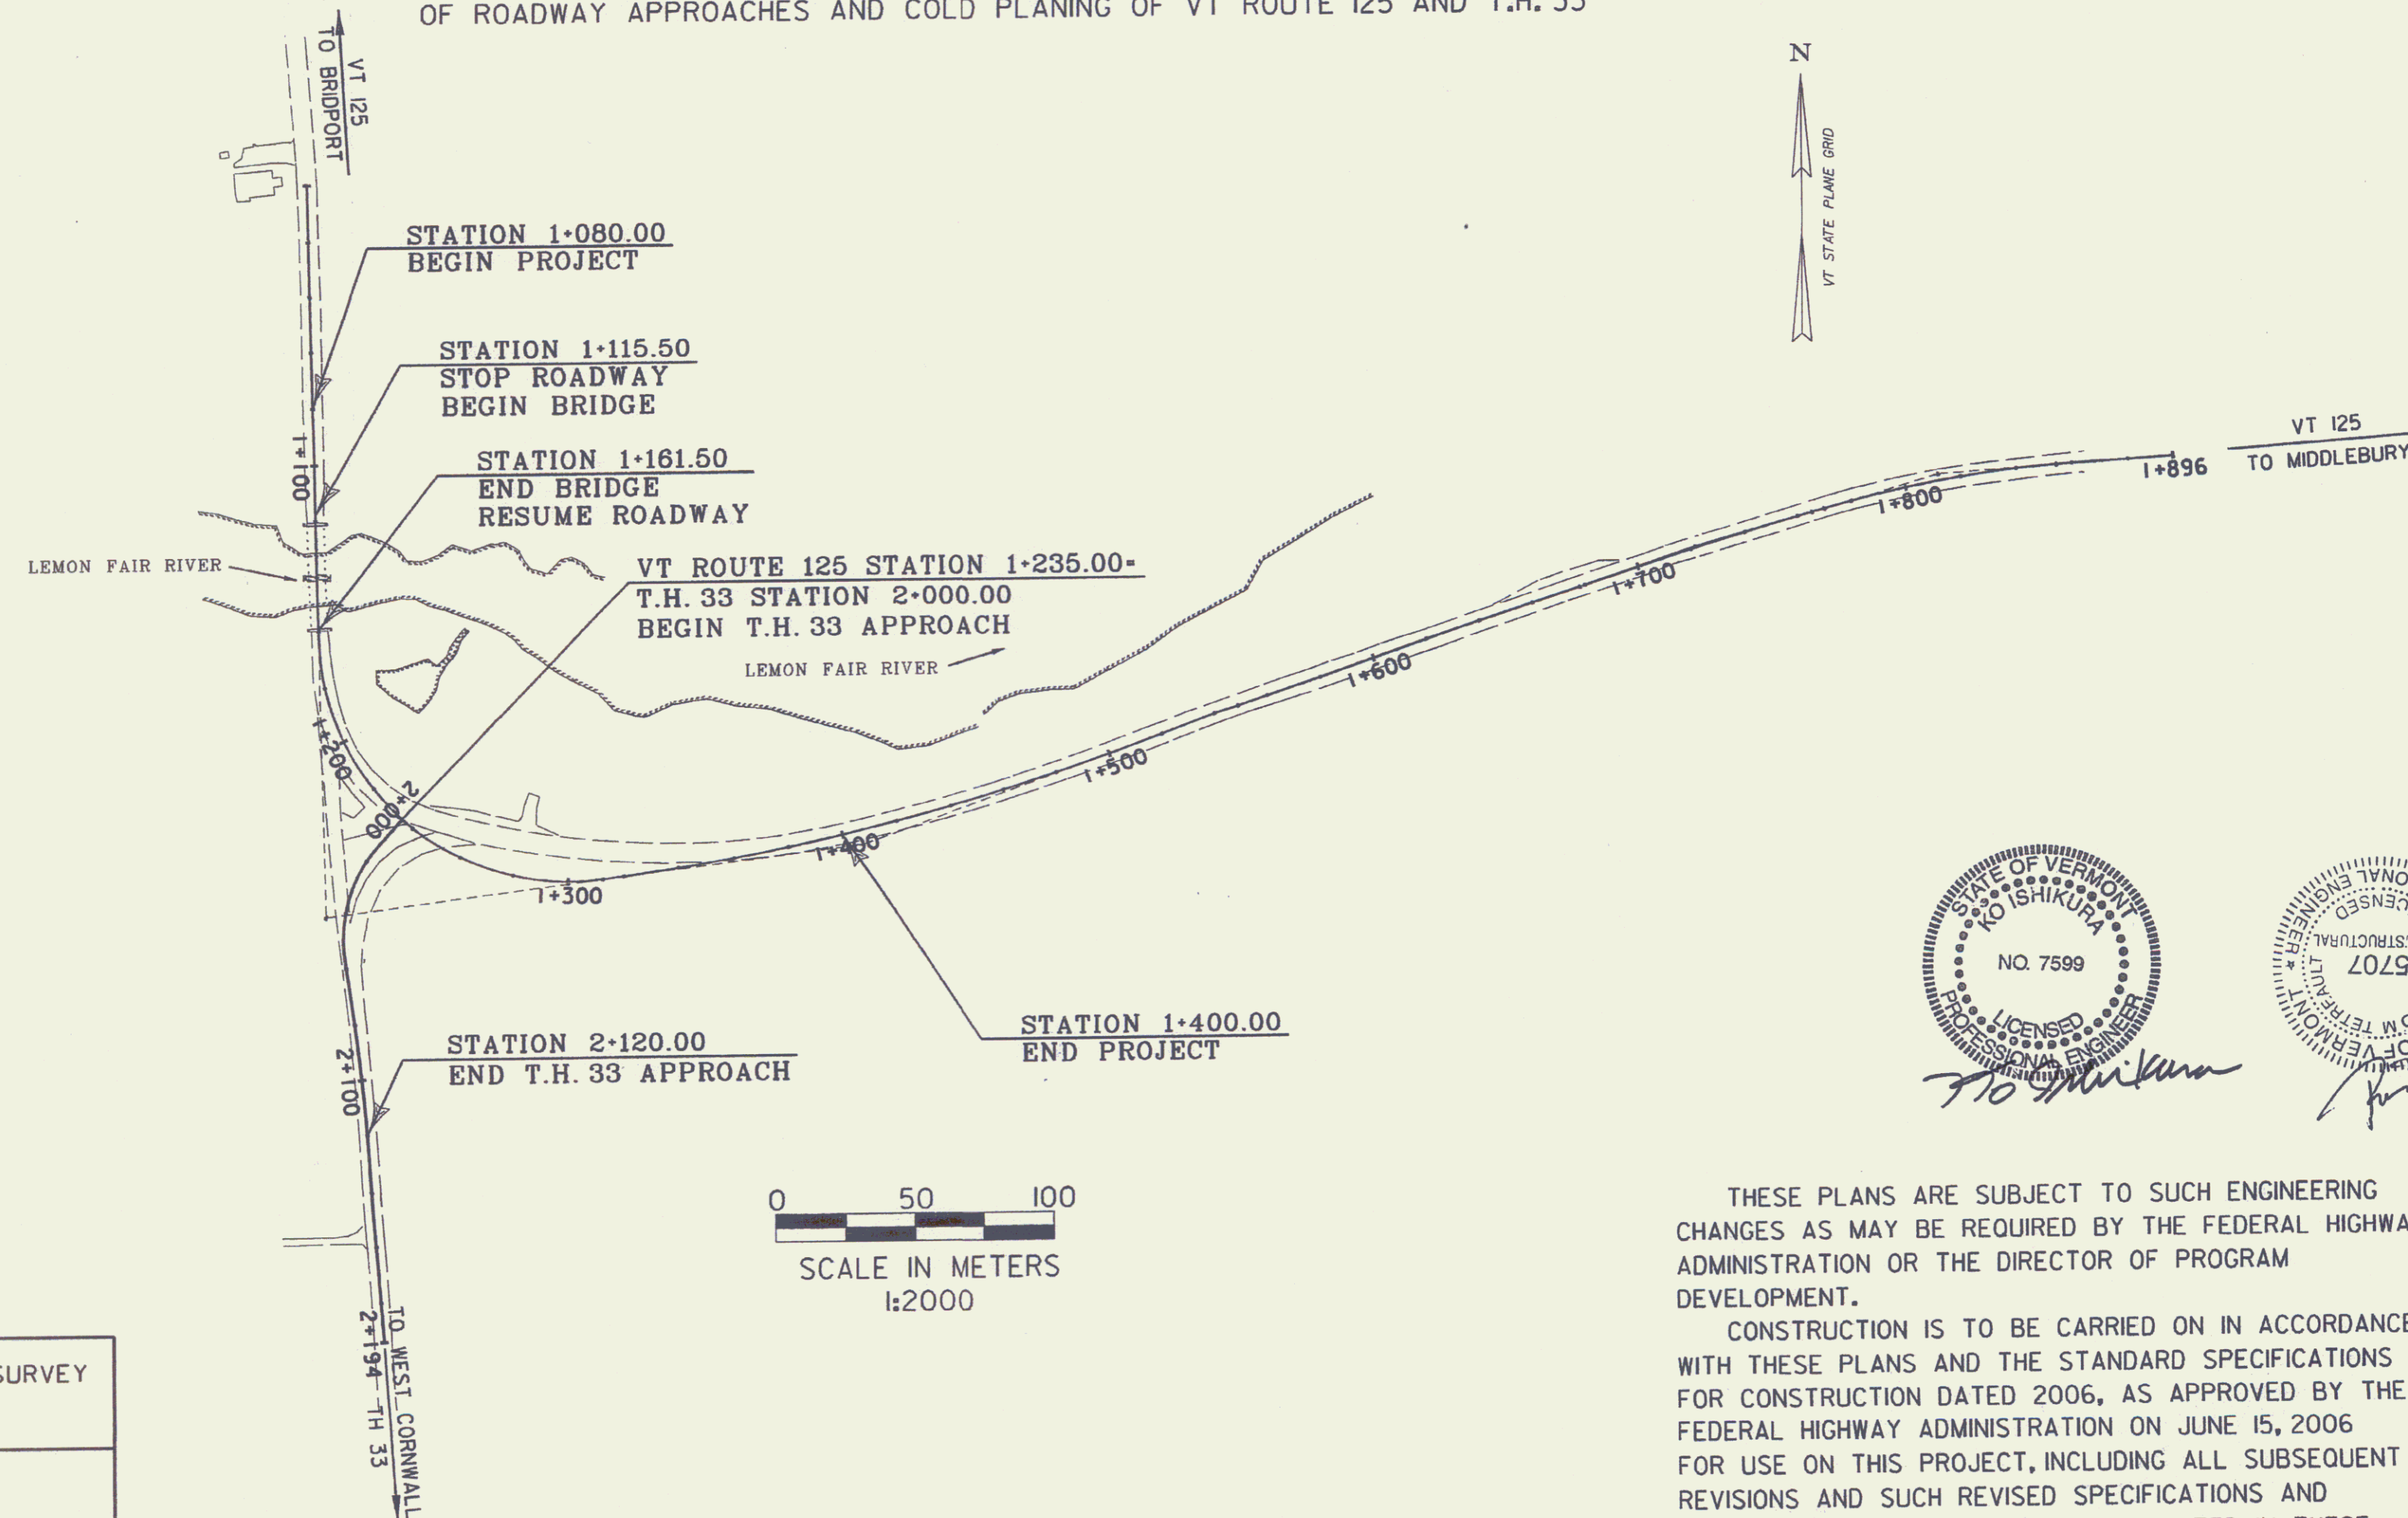


**CONVENTIONAL SYMBOLS**

COUNTY LINE	
TOWN LINE	
LIMITS OF ACCESS	
POINT OF ACCESS	
FENCE LINE	
STONE WALL	
TRAVELED WAY	
GUARD RAIL	
RAILROAD	
SURVEY LINE	
CULVERT	
POWER POLE	
TELEPHONE POLE	
TREES	
CONTROL OF ACCESS	
PROPERTY LINE	
R.O.W. TAKING LINE	
SLOPE RIGHTS	
TOP OF CUT	
TOE OF SLOPE	

SURVEYED BY : VTRANS & VT SURVEY  
SURVEYED DATE : VARIOUS

DATUM  
VERTICAL NAVD88  
HORIZONTAL NAD83 (92)

**Green International Affiliates, Inc.**  
Civil and Structural Engineers Westford, MA

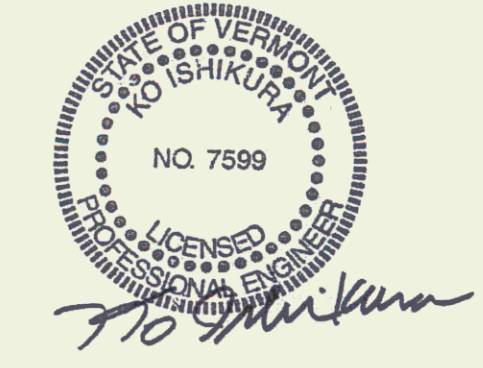

**Metric**  
UNLESS NOTED OTHERWISE  
STATIONS ARE IN KILOMETERS  
ELEVATIONS ARE IN METERS  
DIMENSIONS ARE IN MILLIMETERS

THESE PLANS ARE SUBJECT TO SUCH ENGINEERING CHANGES AS MAY BE REQUIRED BY THE FEDERAL HIGHWAY ADMINISTRATION OR THE DIRECTOR OF PROGRAM DEVELOPMENT.

CONSTRUCTION IS TO BE CARRIED ON IN ACCORDANCE WITH THESE PLANS AND THE STANDARD SPECIFICATIONS FOR CONSTRUCTION DATED 2006, AS APPROVED BY THE FEDERAL HIGHWAY ADMINISTRATION ON JUNE 15, 2006 FOR USE ON THIS PROJECT, INCLUDING ALL SUBSEQUENT REVISIONS AND SUCH REVISED SPECIFICATIONS AND SPECIAL PROVISIONS AS ARE INCORPORATED IN THESE PLANS.

DIRECTOR OF PROGRAM DEVELOPMENT  
APPROVED [Signature] DATE 2-25-10

PROJECT MANAGER : MARTHA EVANS-MONGEON

PROJECT NAME : CORNWALL  
PROJECT NUMBER : BRS 0172 (16)

SHEET 1 OF 144 SHEETS