
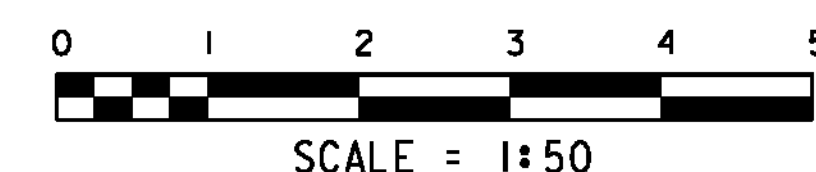


MATERIAL ITEM	THICKNESS	TOLERANCE
PAVEMENT (TOTAL DEPTH ALL LAYERS)		+/-5
SUBBASE		+/-30
SAND BORROW		+/-30

TYPICAL SECTION T.H. 33

40 BITUMINOUS CONCRETE PAVEMENT TYPE IV IN ONE LIFT•
 50 BITUMINOUS CONCRETE PAVEMENT TYPE IIN ONE LIFT•
 75 BITUMINOUS CONCRETE PAVEMENT TYPE IIN ONE LIFT•
 500 SUBBASE OF DENSE GRADED CRUSHED STONE
 250 SAND BORROW
 •FOR PG GRADE SEE SECTION 406 OF THE GENERAL SPECIAL PROVISIONS
 REFER TO SHEET 7 FOR MATERIAL TRANSITION AND COLD PLANING DETAILS.

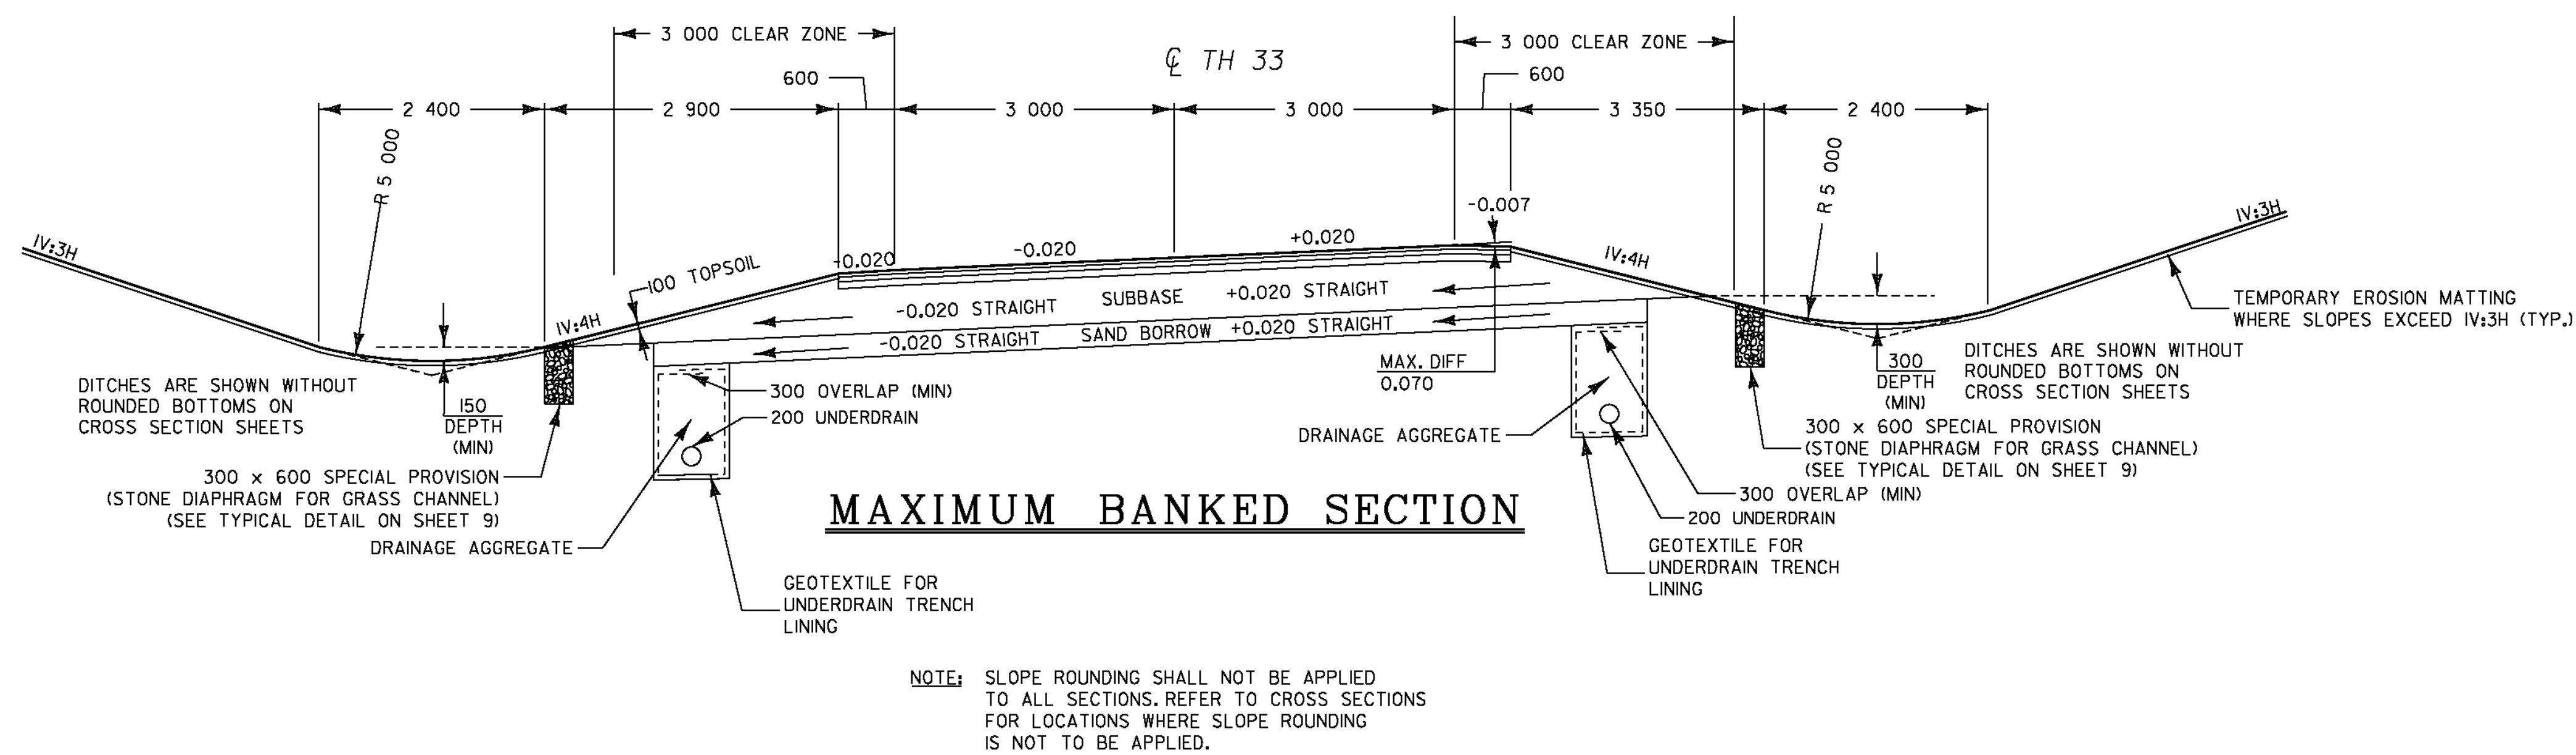

DATUM	
VERTICAL	NAVD88
HORIZONTAL	NAD83(92)

PROJECT: CORNWALL	PROJECT NO.: BRS 0172(6)
DESIGN FILE NAME: z85e042typxs.DGN	PLOT DATE: 2/4/2010
IPARM FILE NAME:	SURVEY DATE: 1996&1999
SURVEYED BY: VTRANS & VT SURVEY	DRAWN BY: ERIK ATKINS
SQUAD LEADER: MARTHA EVANS-MONGEON	SHEET: 4 OF 144
TYPICAL SECTION T.H. 33	