

GPS CONTROL POINTS

TRAV. 1

VTAT DISK STAMPED
 * LEMON FAIR AZ MK*
 N = 166531.783
 E = 439175.480
 Z = 59.740

VTPID - VTO153
 GENERAL LOCATION, 5 MI (8.0 KM) WEST OF MIDDLEBURY, 3 MI (4.8 KM) WEST OF BRIDPORT.

TO REACH, FROM THE JUNCTION OF VT ROUTE 30 AND VT ROUTE 125 IN MIDDLEBURY, PROCEED WEST ON ROUTE 125 FOR 5.3 MI (8.5 KM) TO THE MARK ON THE LEFT.

THE MARK IS LOCATED 315 FT (96.0 M) WEST OF THE CORNWALL/BRIDPORT TOWN LINE, 96.1 FT (29.3 M) SOUTHEAST OF UTILITY POLE NUMBER 49, 25.6 FT (7.8 M) SOUTH OF THE CENTERLINE OF ROUTE 125, AND 1 FT (0.3 M) NORTH OF A FIBERGLASS WITNESS POST.

TRAV. 2

VTAT DISK STAMPED
 * LEMON FAIR 1995*
 N = 165432.306
 E = 439683.347
 Z = 63.140

VTPID - 0152
 GENERAL LOCATION, 5 MI (8.0 KM) WEST OF MIDDLEBURY, 3 MI (4.8 KM) EAST OF BRIDPORT.

TO REACH, FROM THE JUNCTION OF VT ROUTE 30 AND VT ROUTE 125 IN MIDDLEBURY, PROCEED WEST ON ROUTE 125 FOR 4.7 MI (7.6 KM) TO A SIDE ROAD LEFT CALLED WEST ST. PROCEED SOUTH ON WEST ST FOR 0.3 MI (0.5 KM) TO A GRAVEL DRIVE AND THE MARK ON THE LEFT AND EAST.


THE MARK IS LOCATED 25 FT (7.6 M) EAST OF THE CENTERLINE OF THE ROAD, 18 FT (5.5 M) NORTH OF THE CENTERLINE OF THE GRAVEL DRIVE 4 FT (1.2 M) WEST OF A FENCE CORNER, AND 2 FT (0.6 M) WEST OF A FIBERGLASS WITNESS POST.

• DESCRIPTIONS PROVIDED BY AGENCY OF TRANSPORTATION GEODETIC SURVEY UNIT.

TRAVERSE TIES


TRAV. 7

N = 166509.1388
 E = 439358.5463
 Z = 63.500

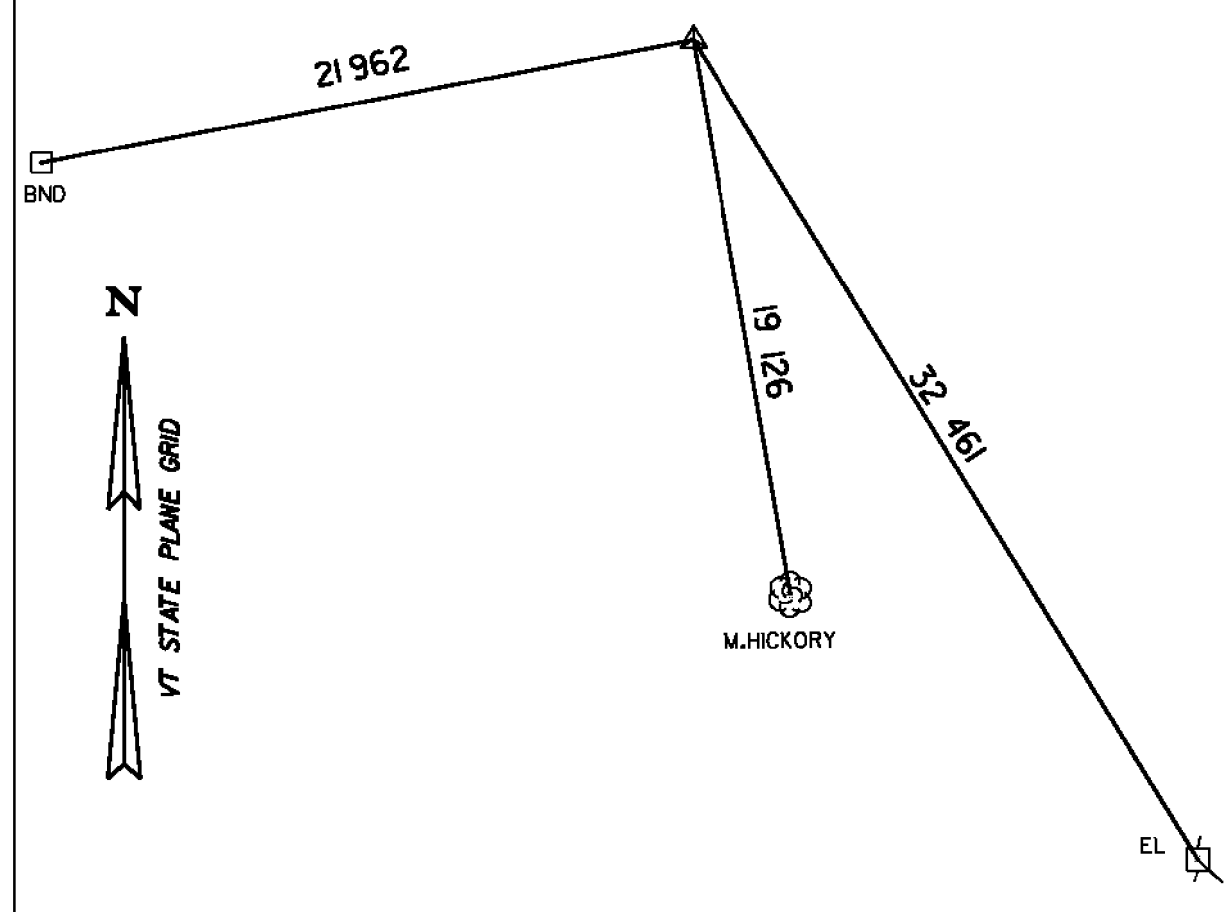


TRAV. 6

N = 166343.2069
 E = 439534.2342
 Z = 69.696

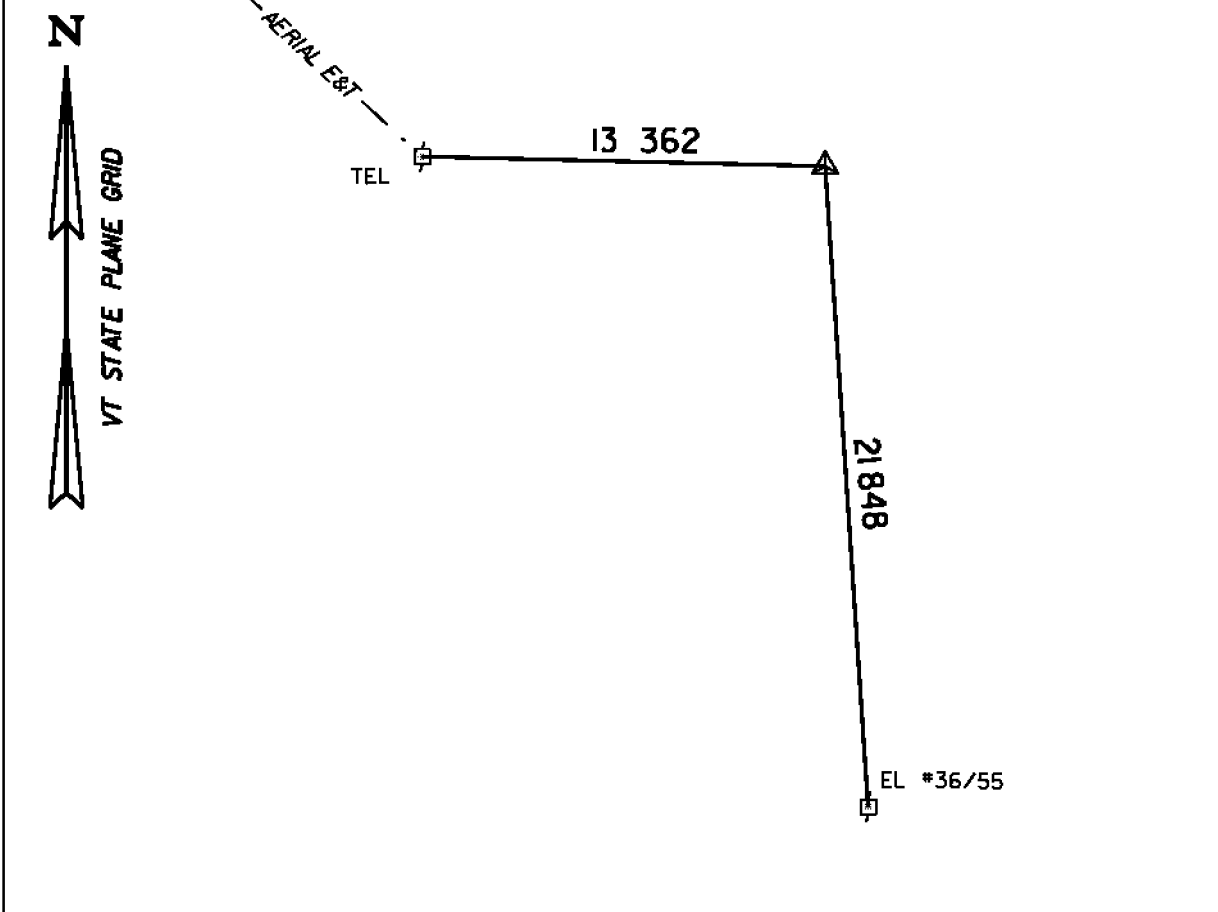


TRAV. 5

N = 166170.3197
 E = 439635.1399
 Z = 58.921

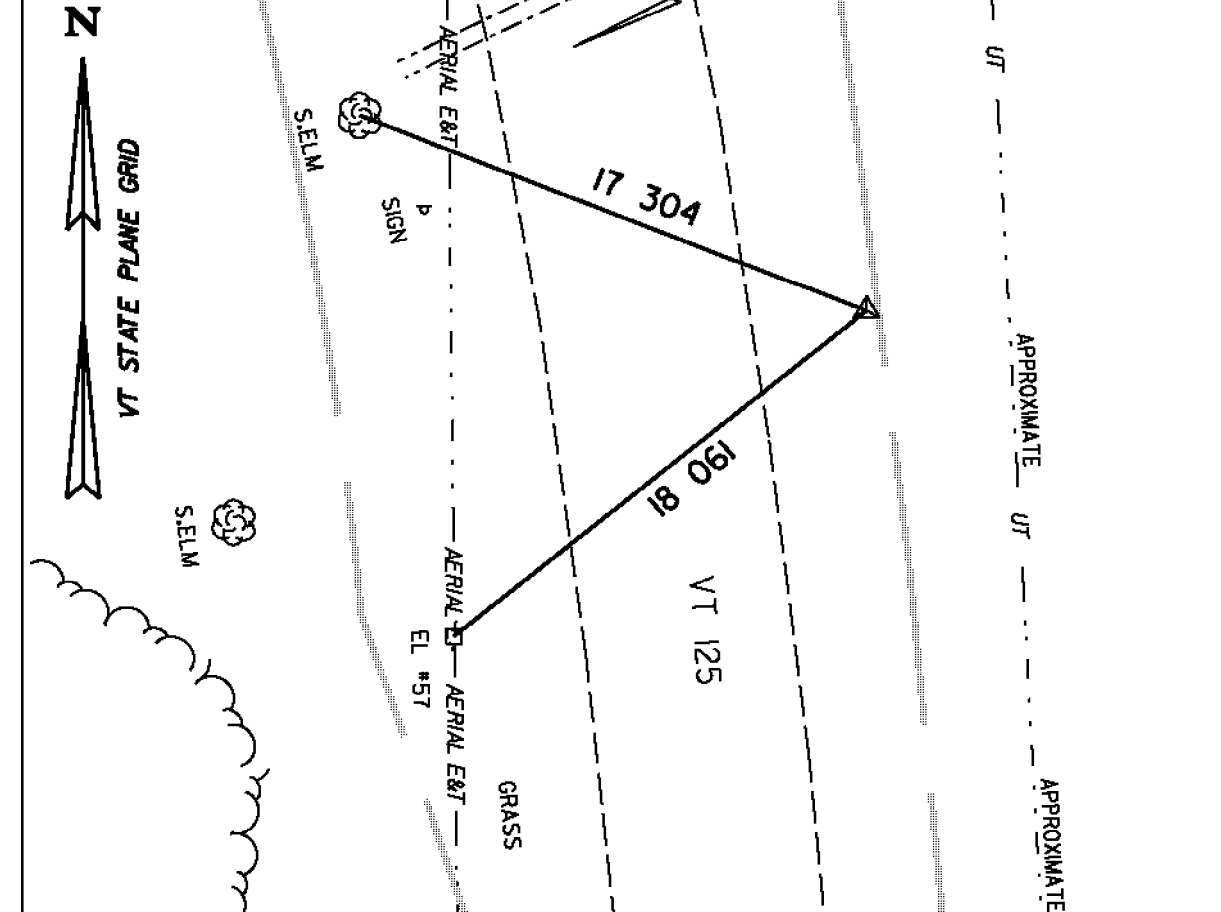

TRAV. 4


N = 165753.2227
 E = 439650.5615
 Z = 54.404

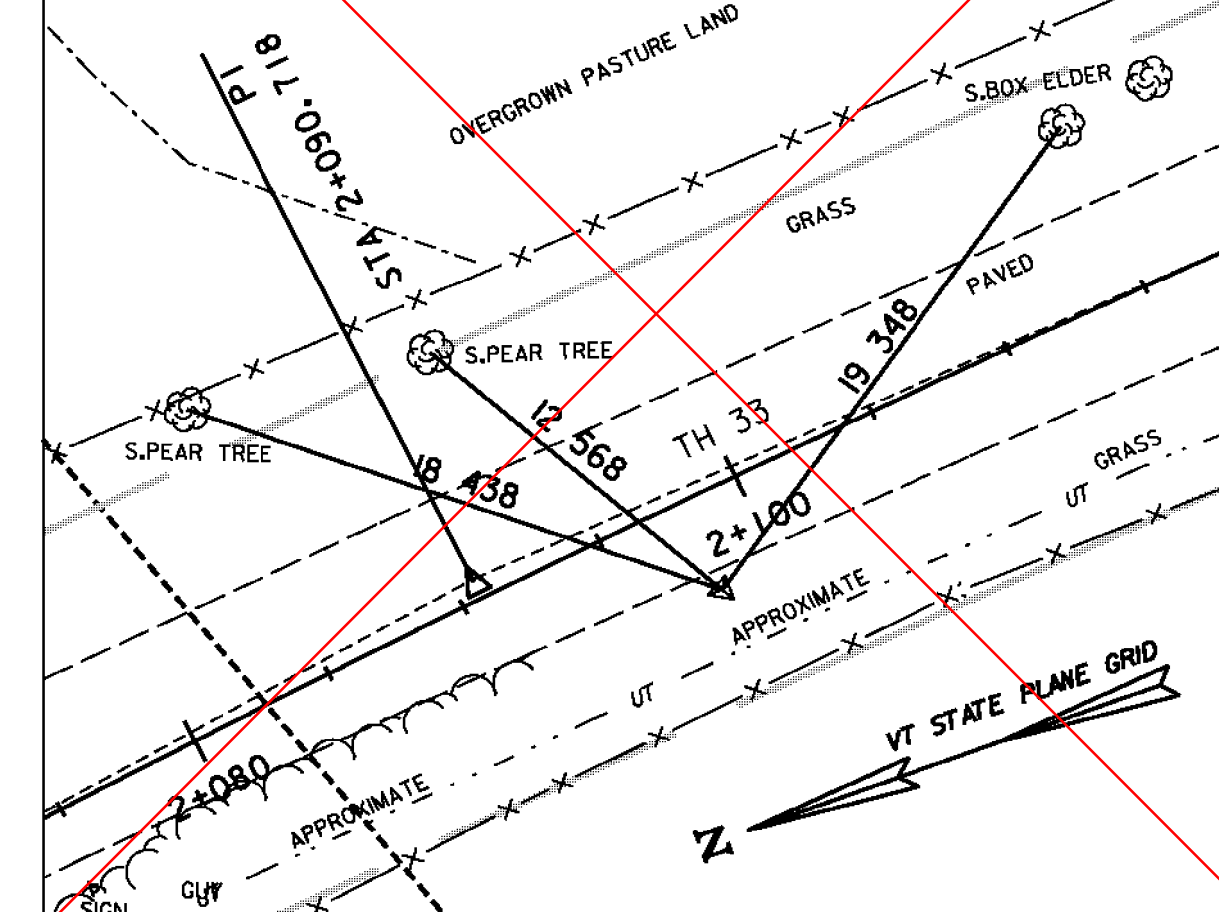

TRAVERSE TIES


TRAV. 50

N = 165920.3837
 E = 440067.4537
 Z = 54.723

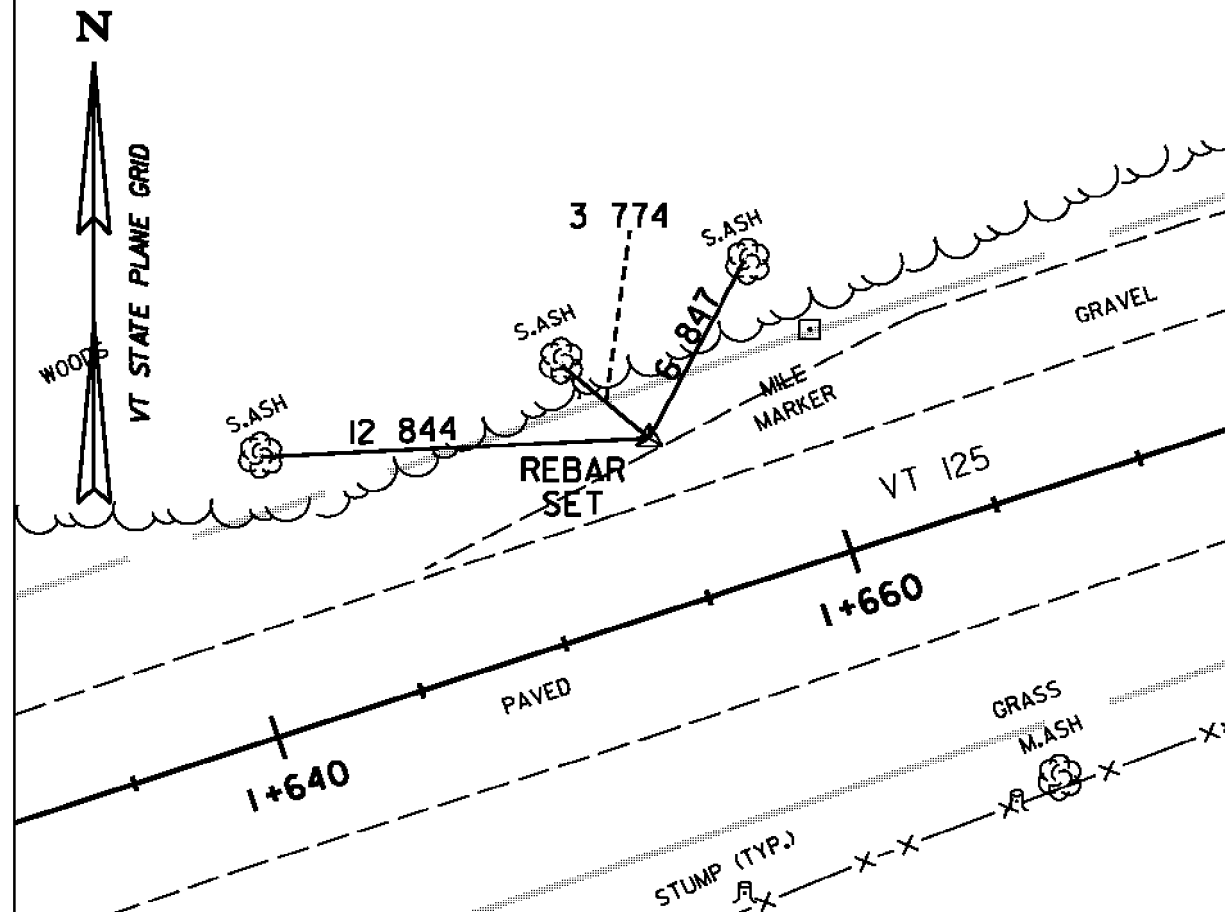

TRAV. 51


N = 166009.5762
 E = 440484.8726
 Z = 45.165

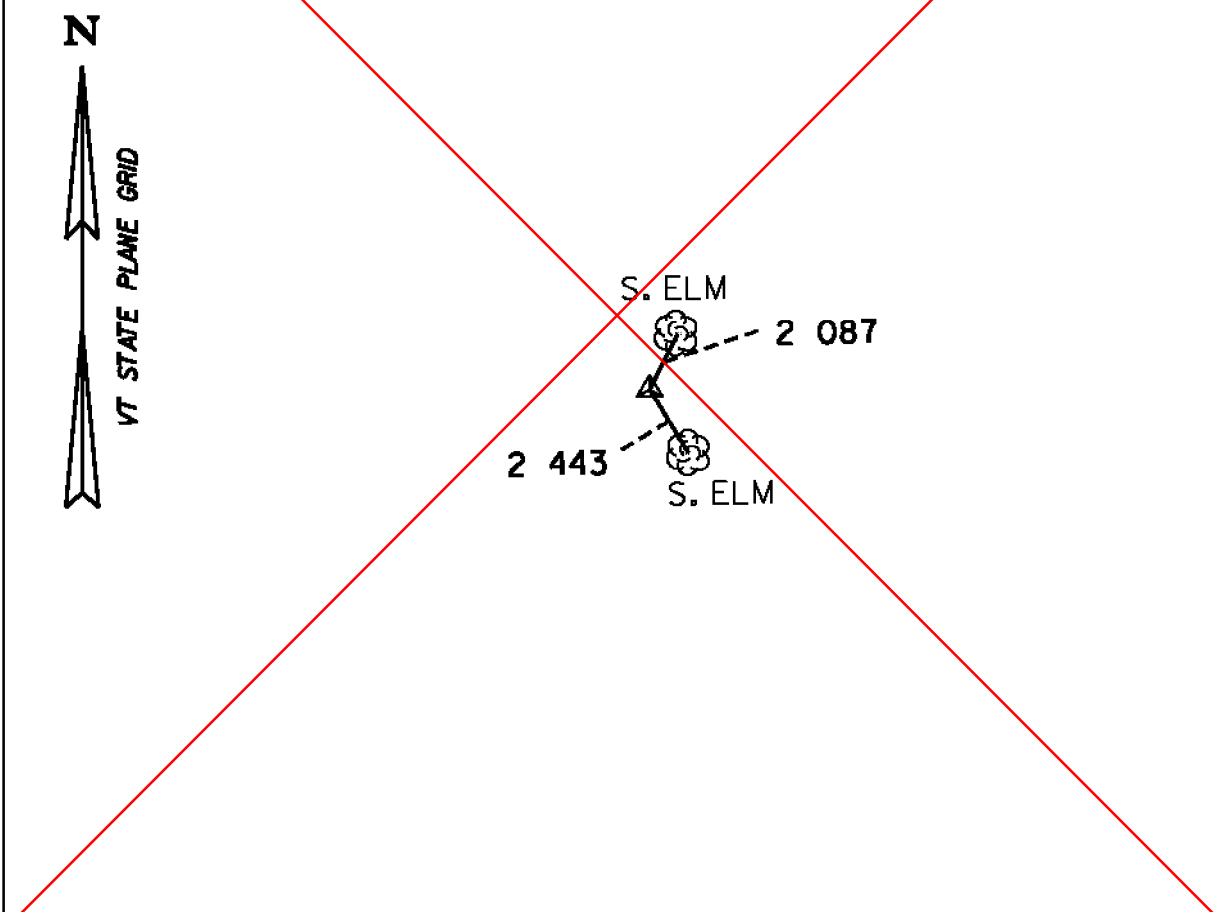

ALIGNMENT TIES


VT 125 POB STA. 1+000.000

N = 166071.2122
 E = 439636.1740

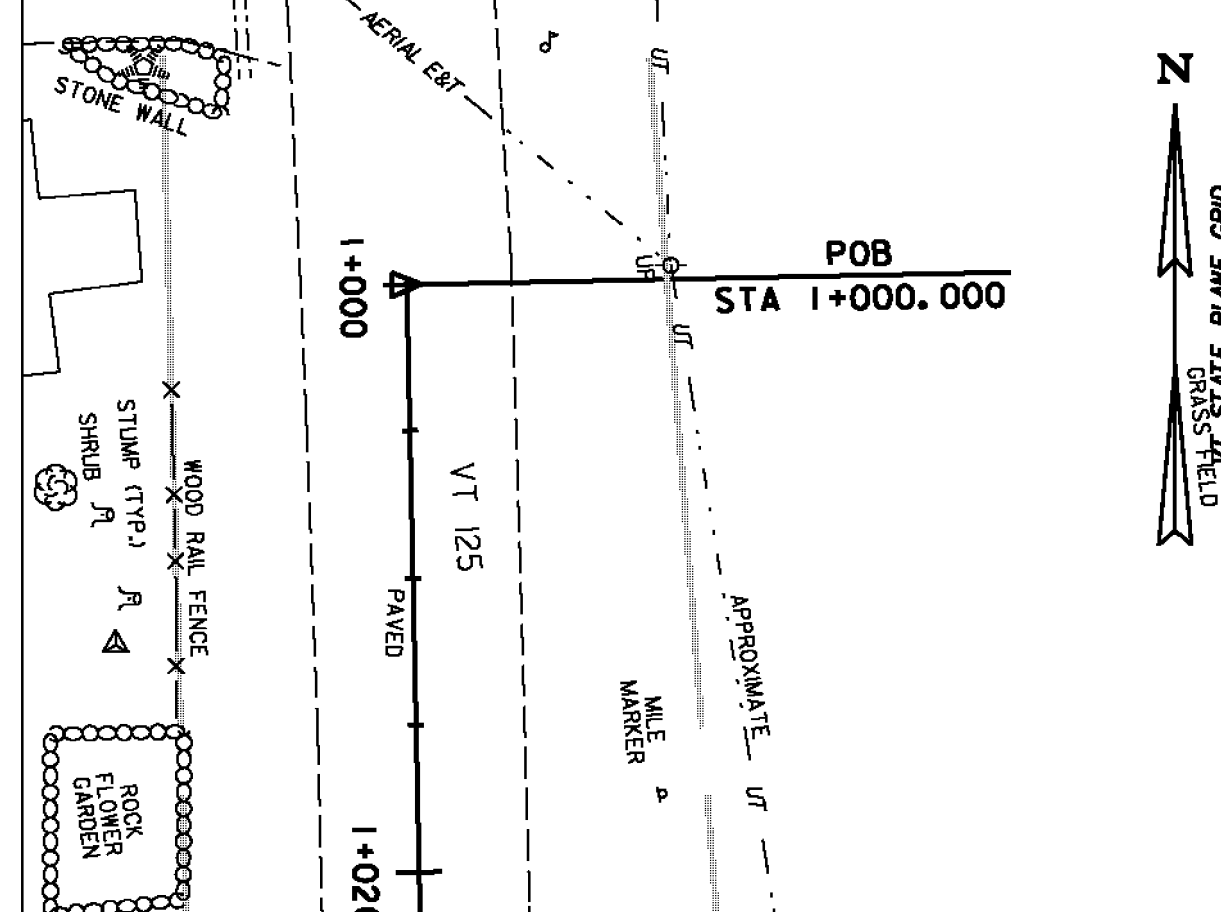

VT 125 POT STA. 1+040.000

N = 166031.2207
 E = 439637.0001

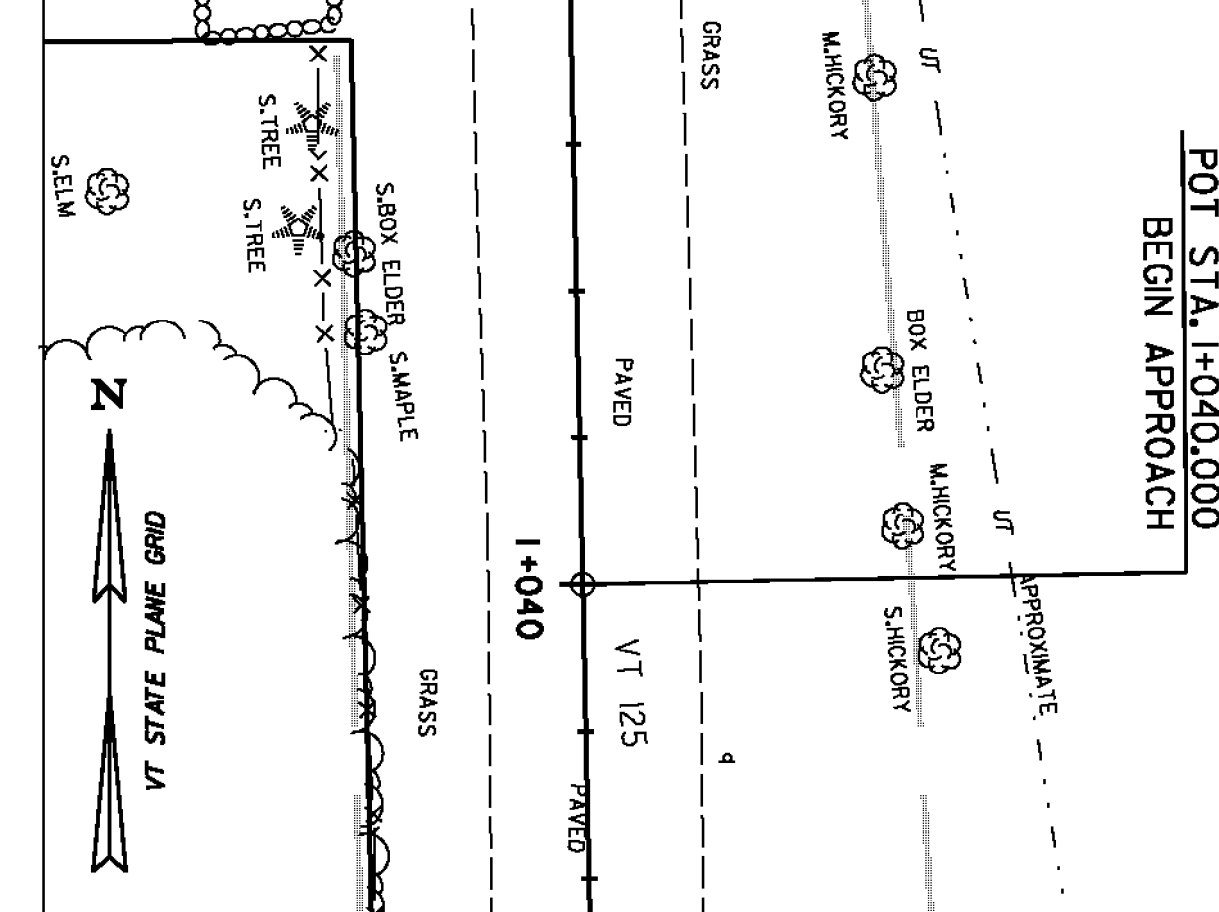

DATUM
 VERTICAL NAVD 88
 HORIZONTAL NAD 83(92)

PROJECT: CORNWALL	PROJECT NO. : BR5 0172(6)
DESIGN FILE NAME: z85e042tie.dgn	PLOT DATE: 2/4/2010
IPARM FILE NAME:	SURVEY DATE: 1996&1999
SURVEYED BY: VTRANS & VT SURVEY	DRAWN BY: ERIK ATKINS
SQUAD LEADER: MARTHA EVANS-MONGEON	SHEET: 18 OF 144
TIE SHEET 1 OF 4	