

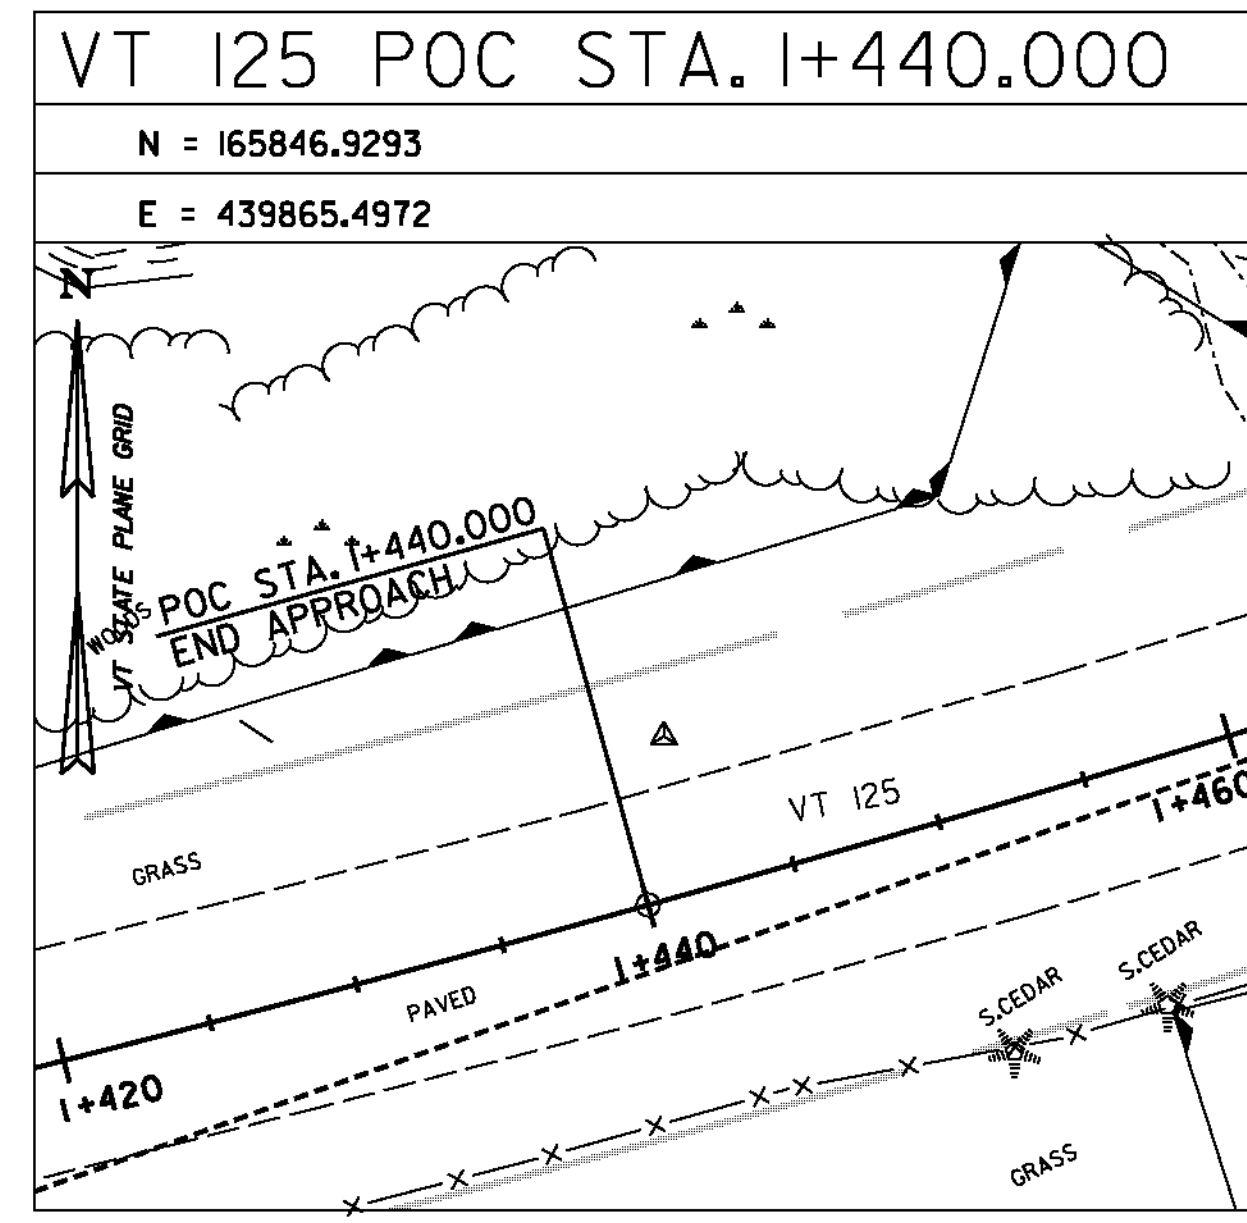
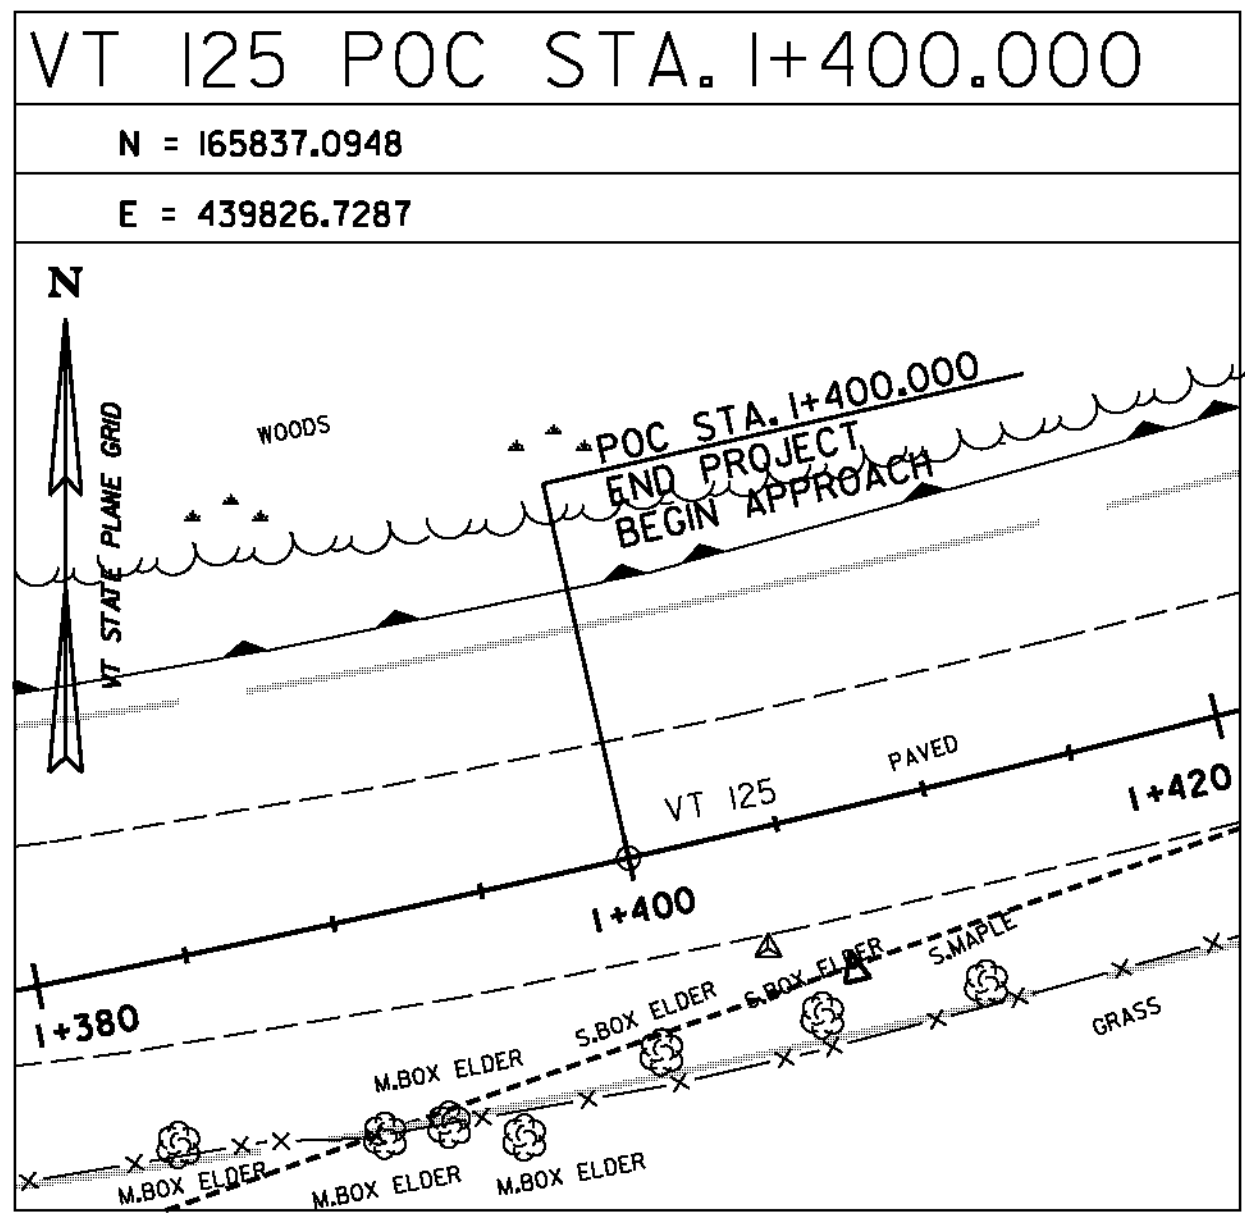
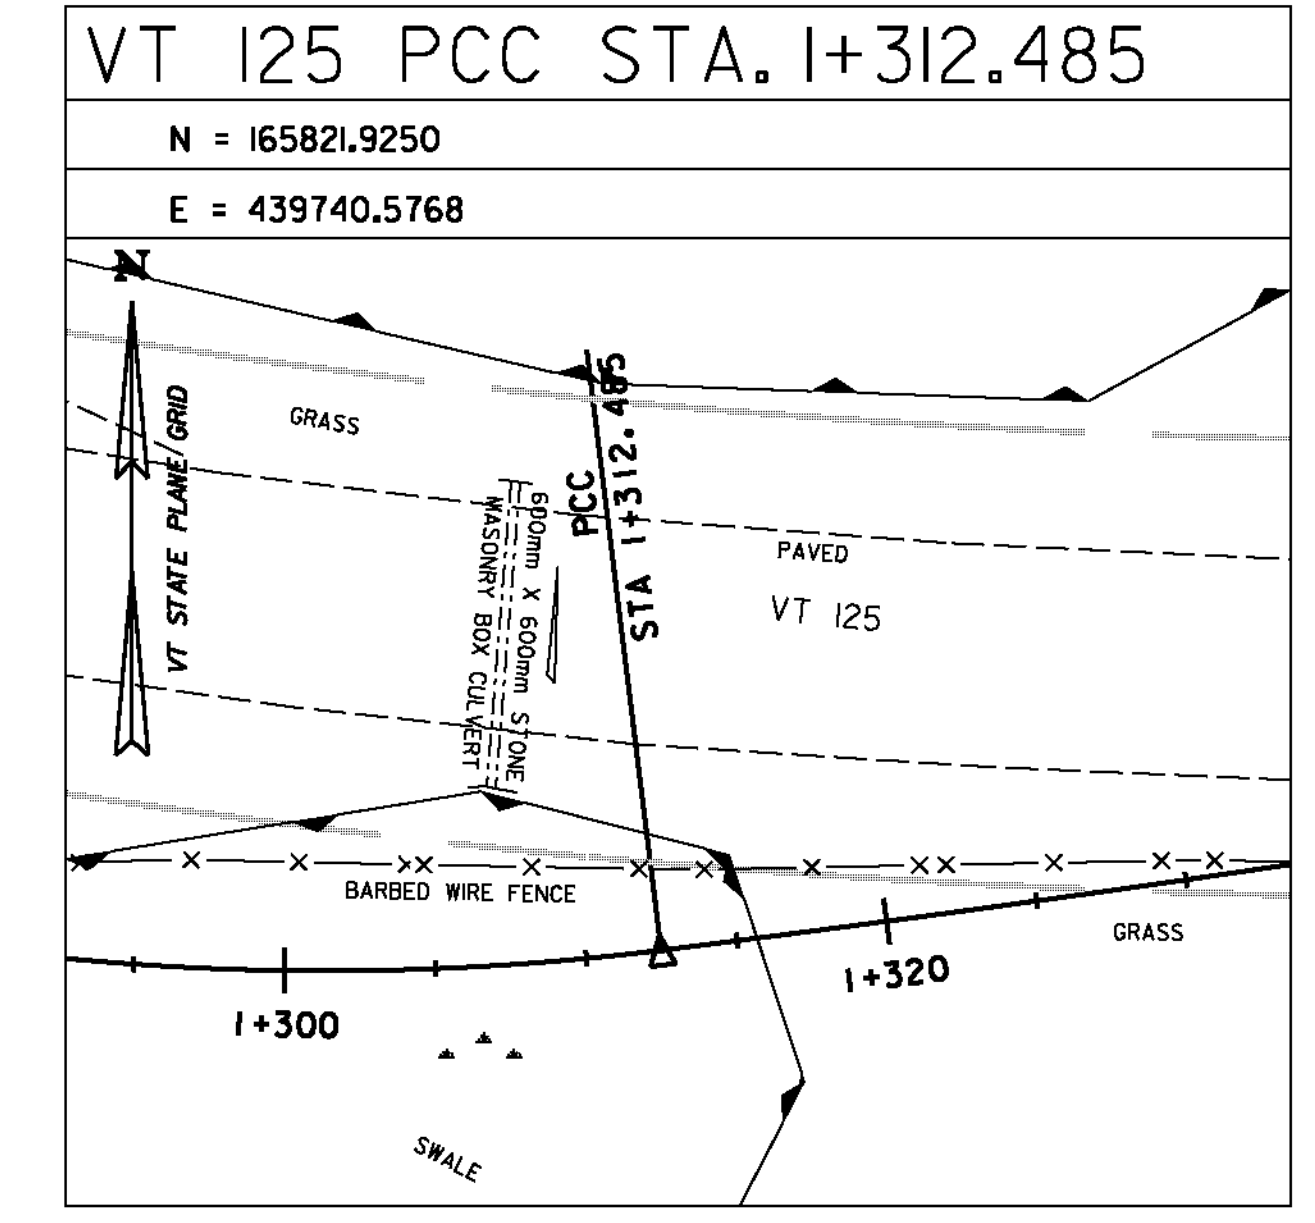
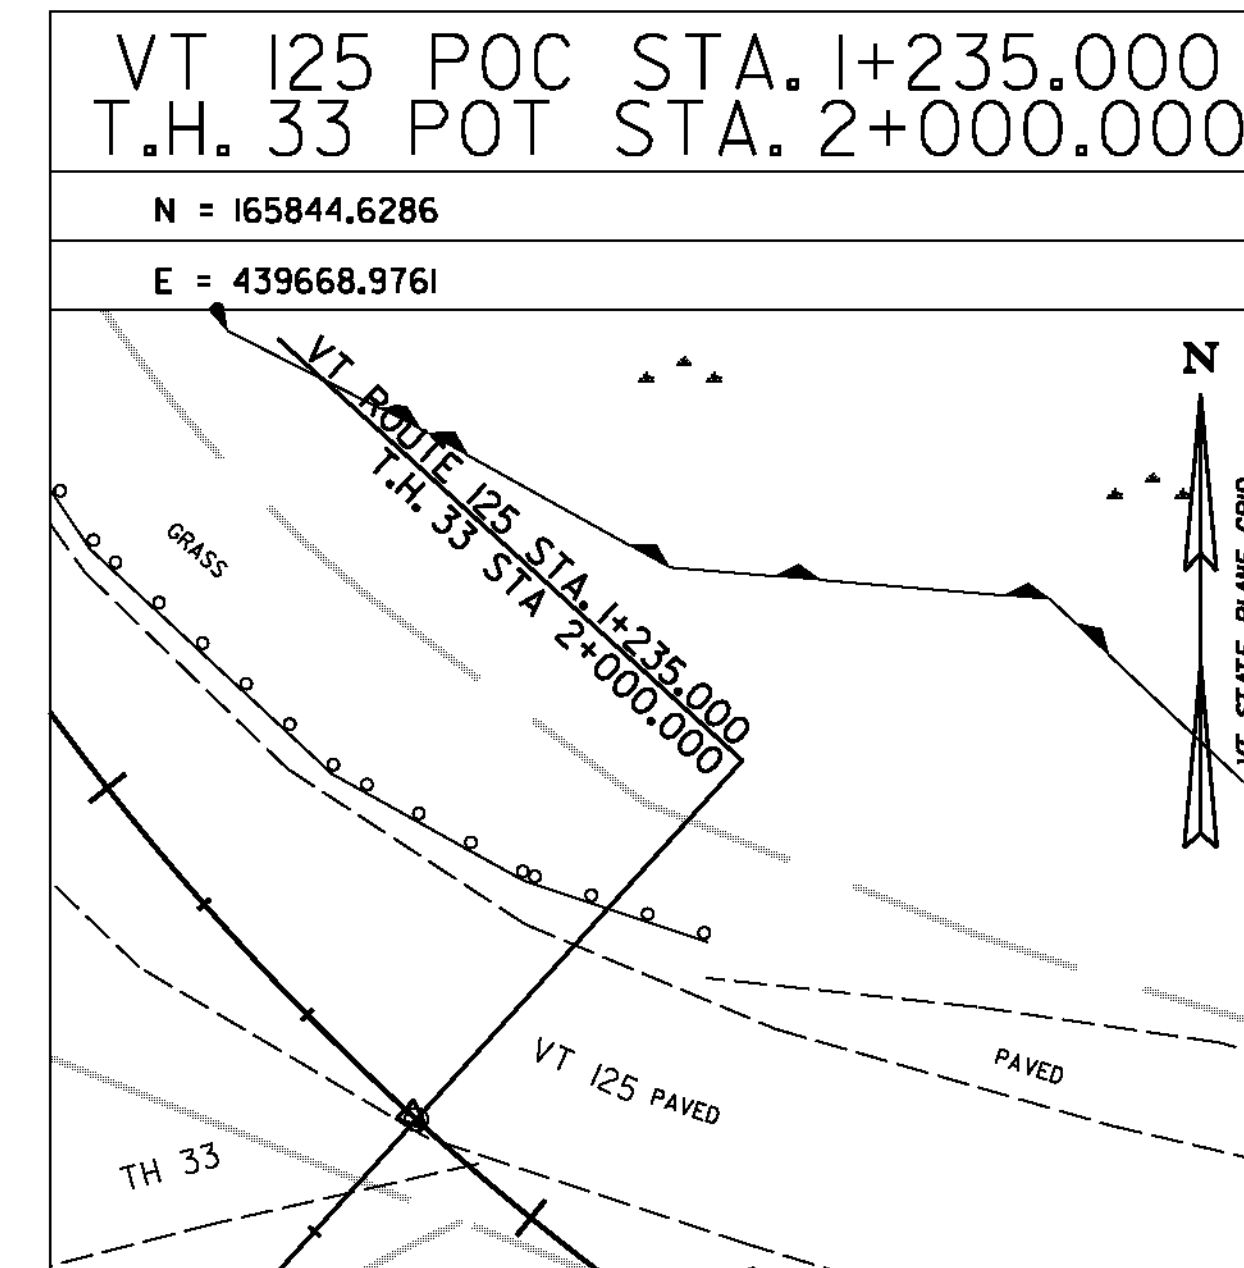
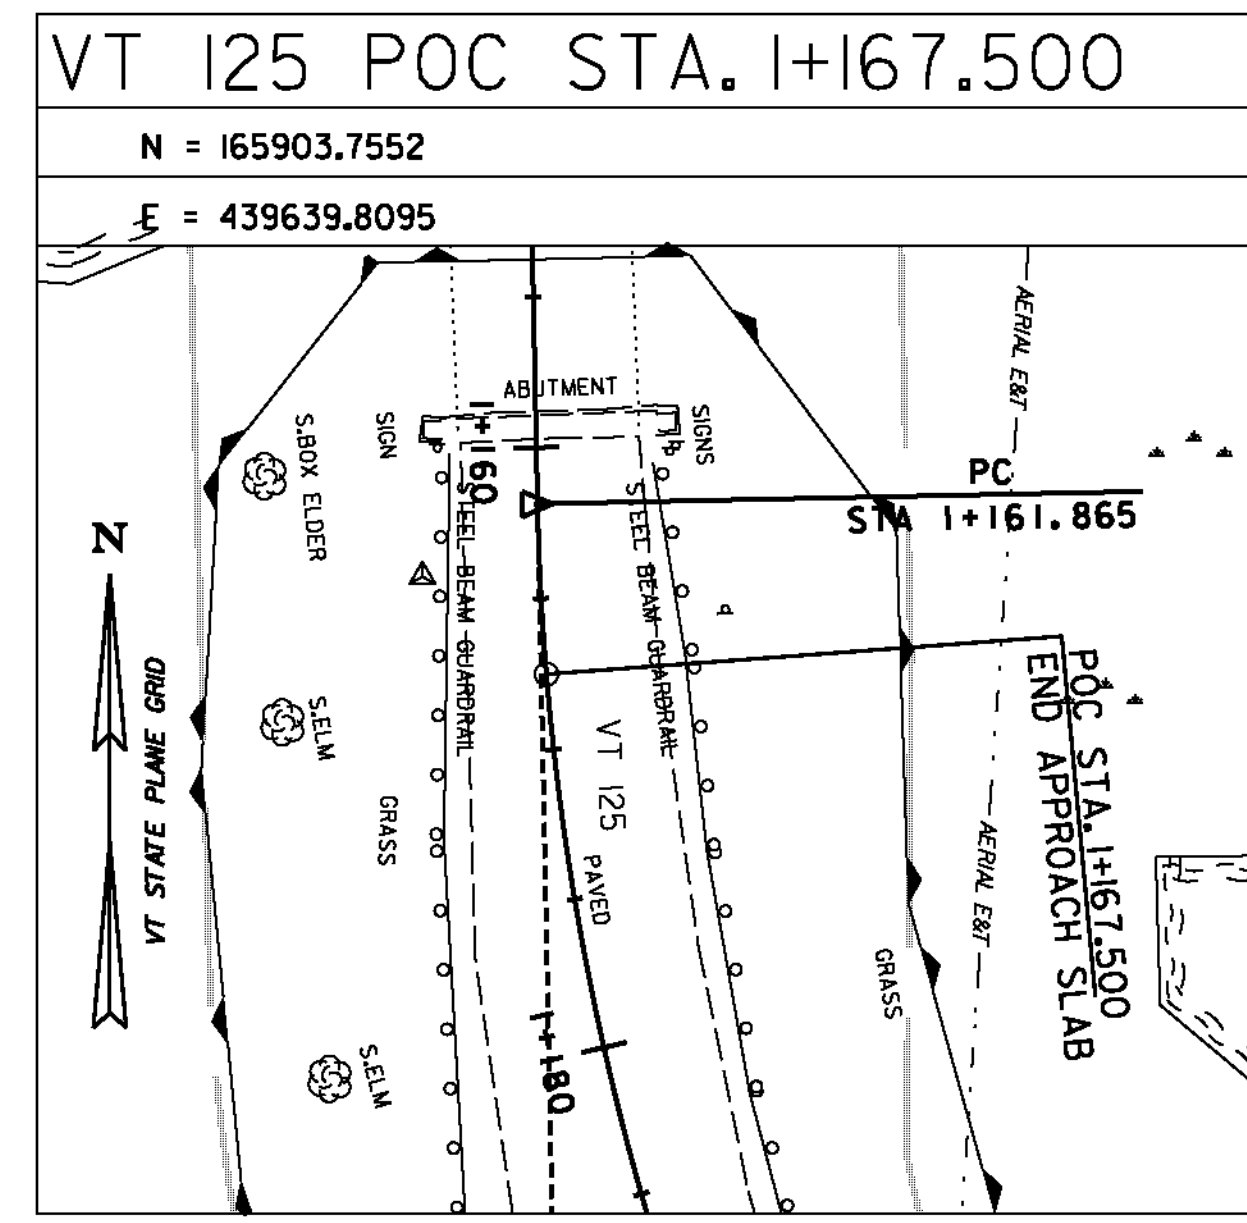
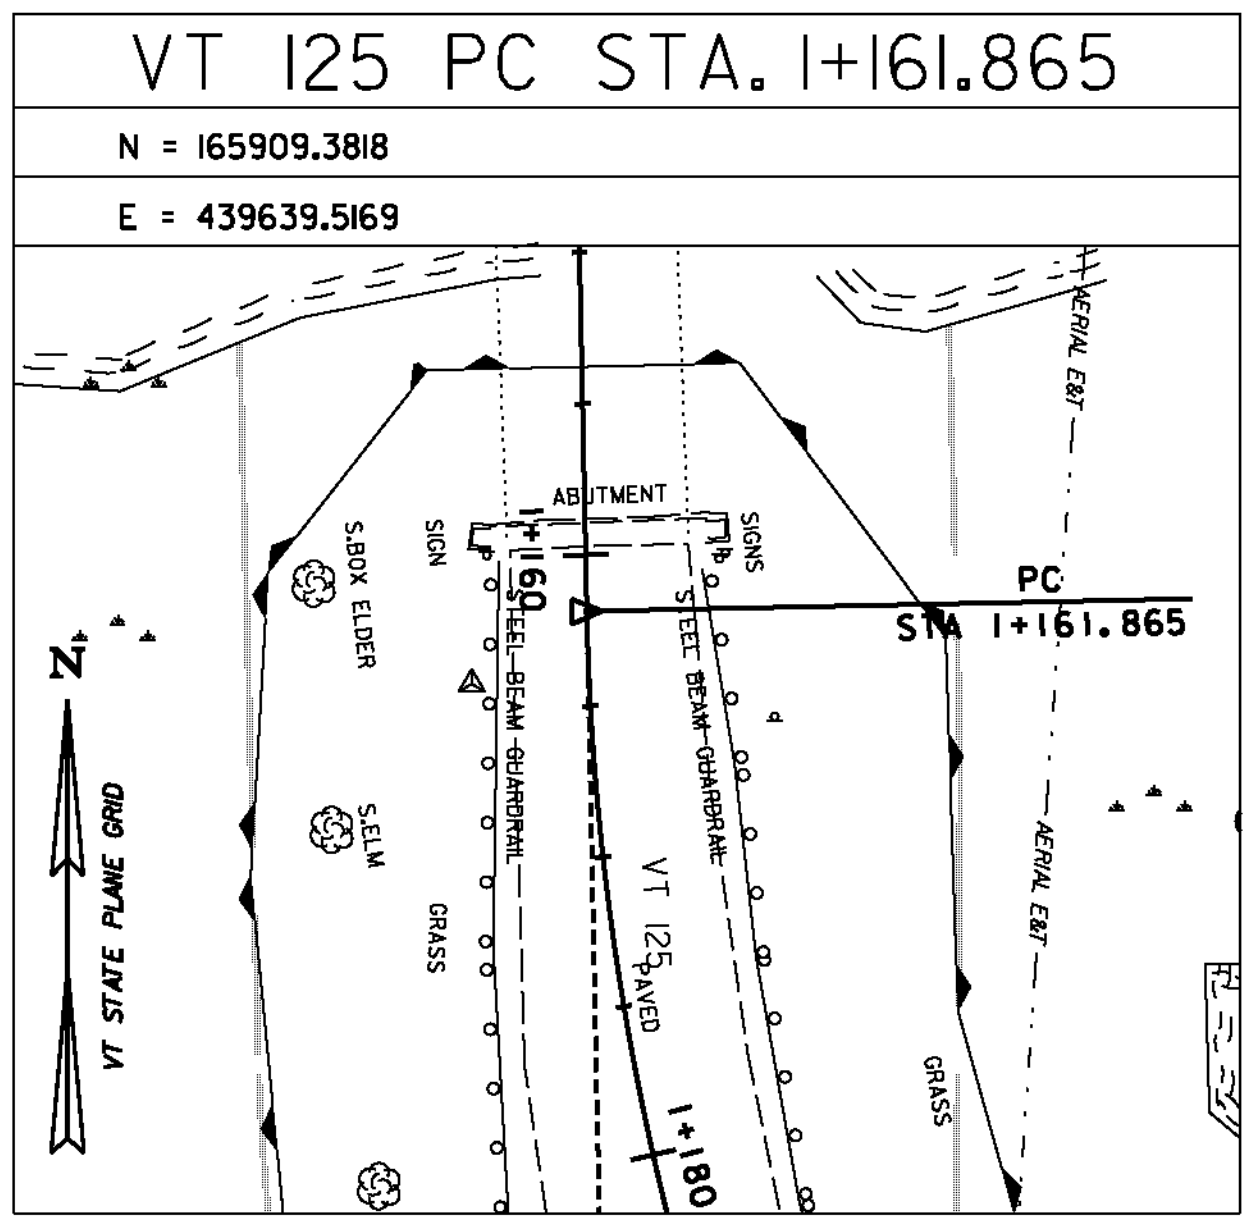
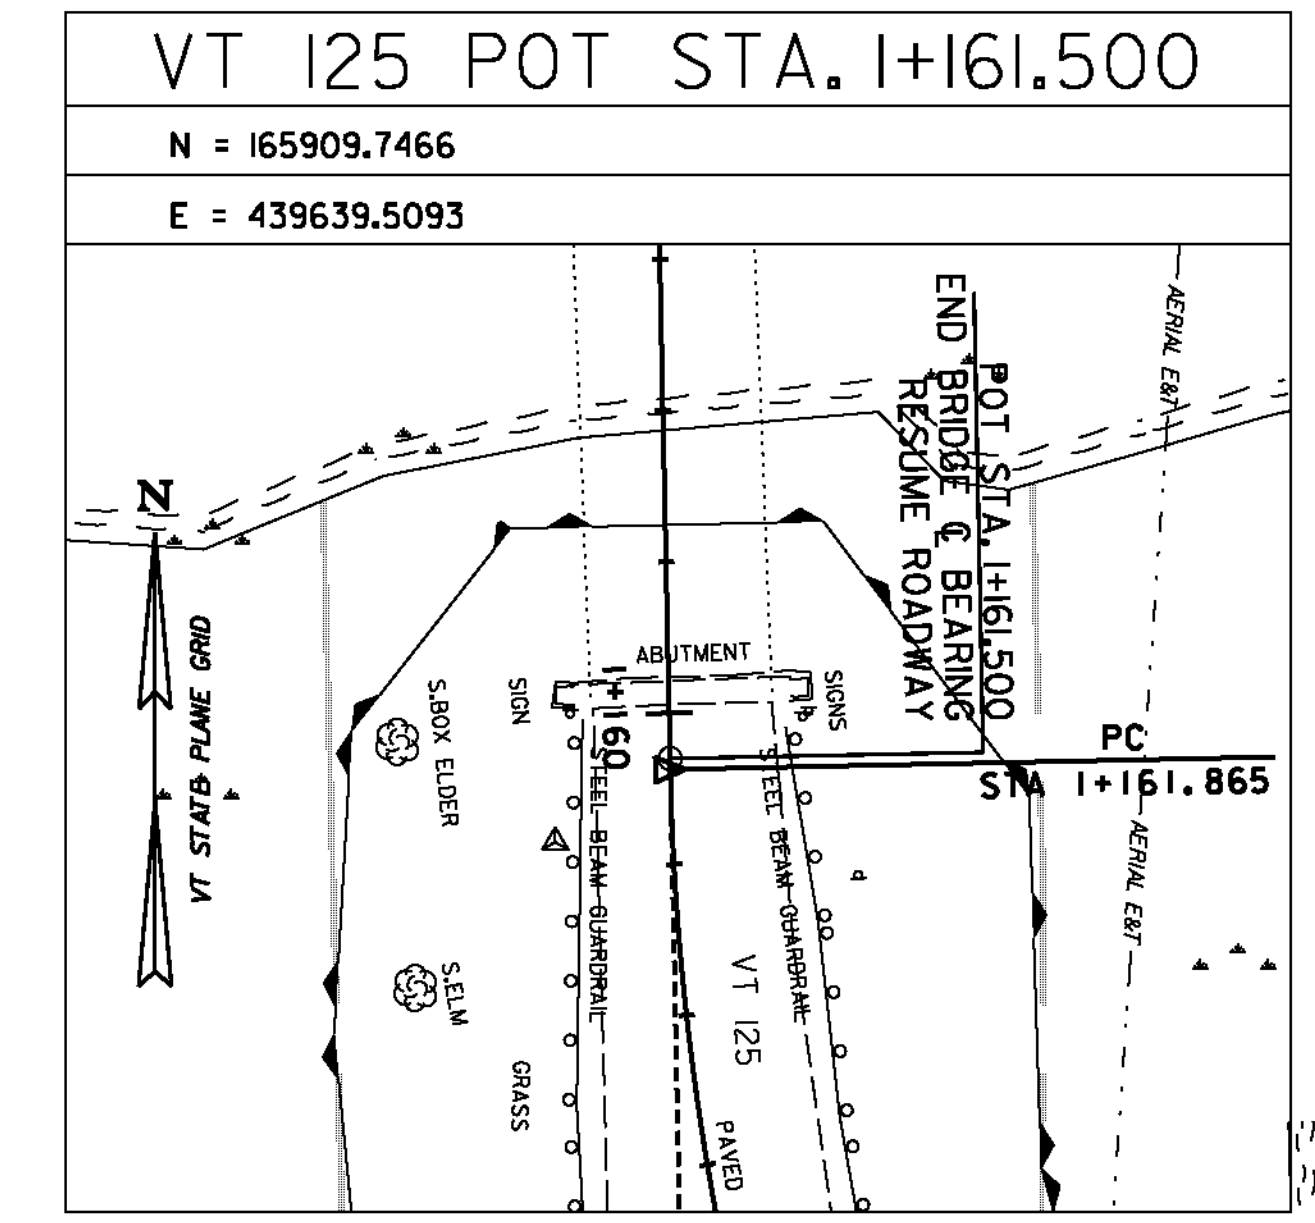
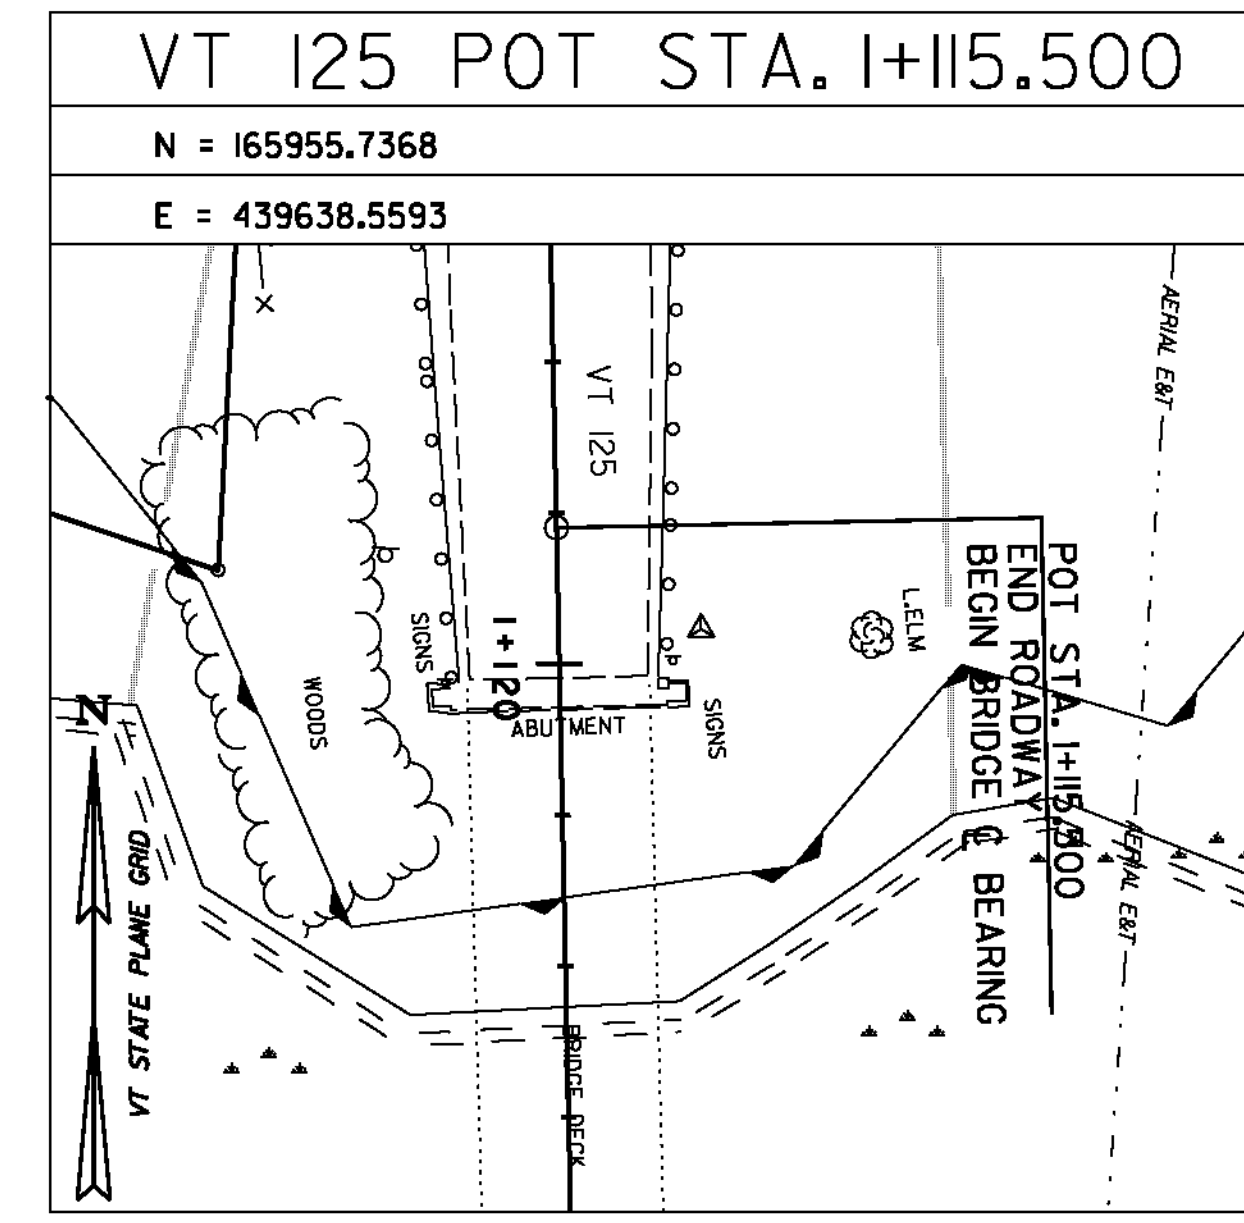


ALIGNMENT TIES

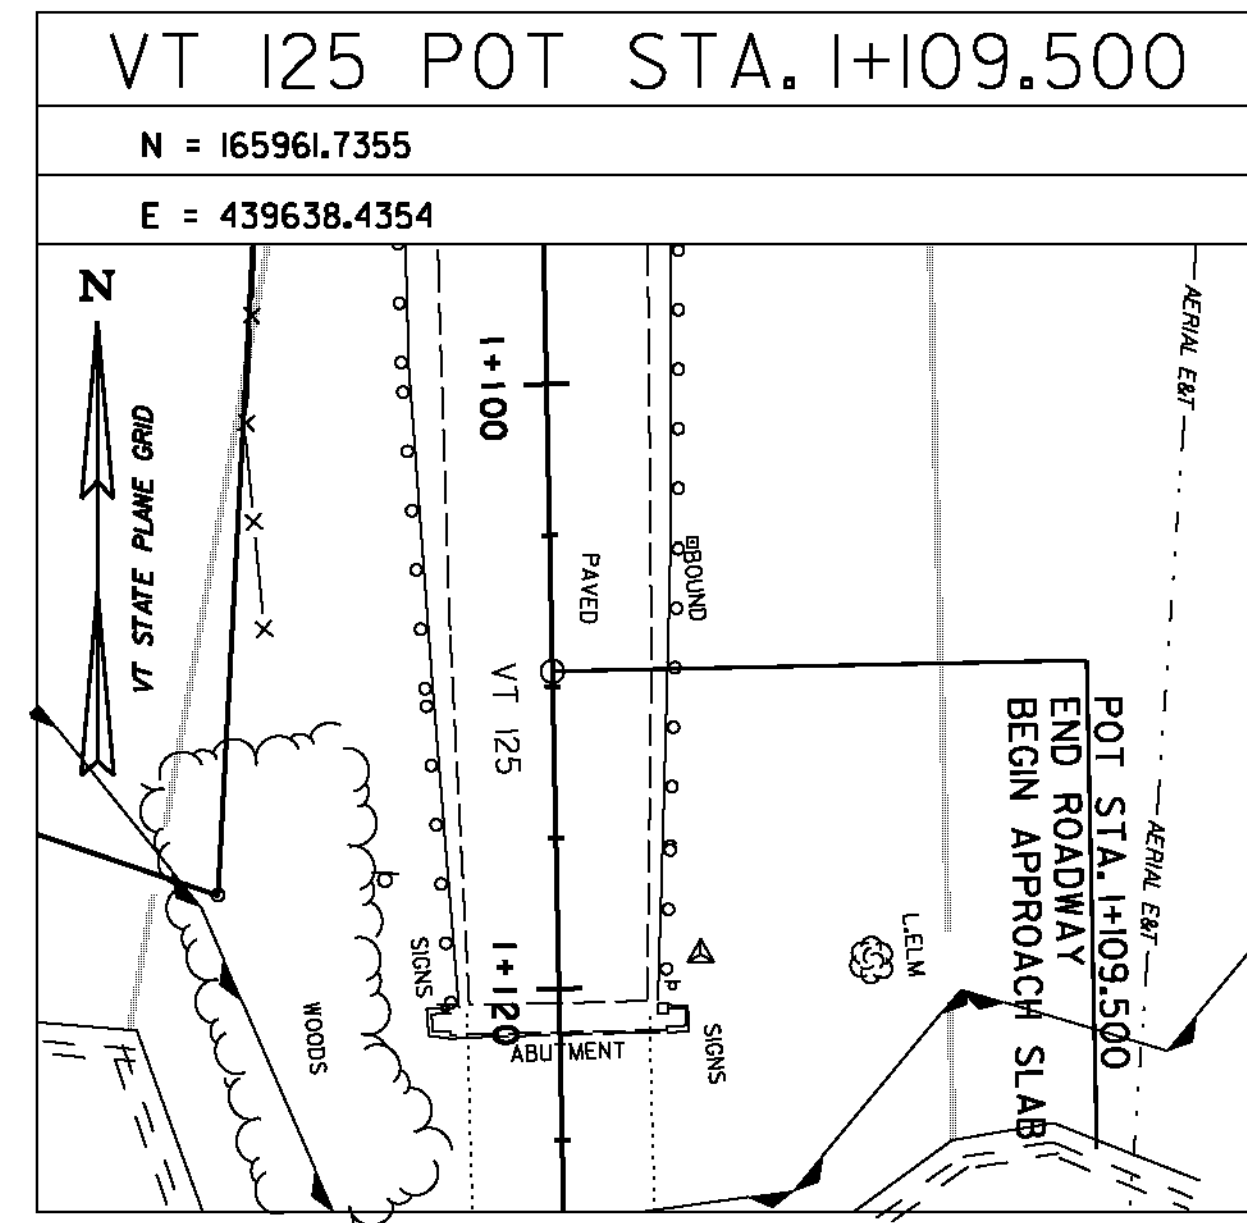

DATUM

VERTICAL	NAVD 88
HORIZONTAL	NAD 83(92)

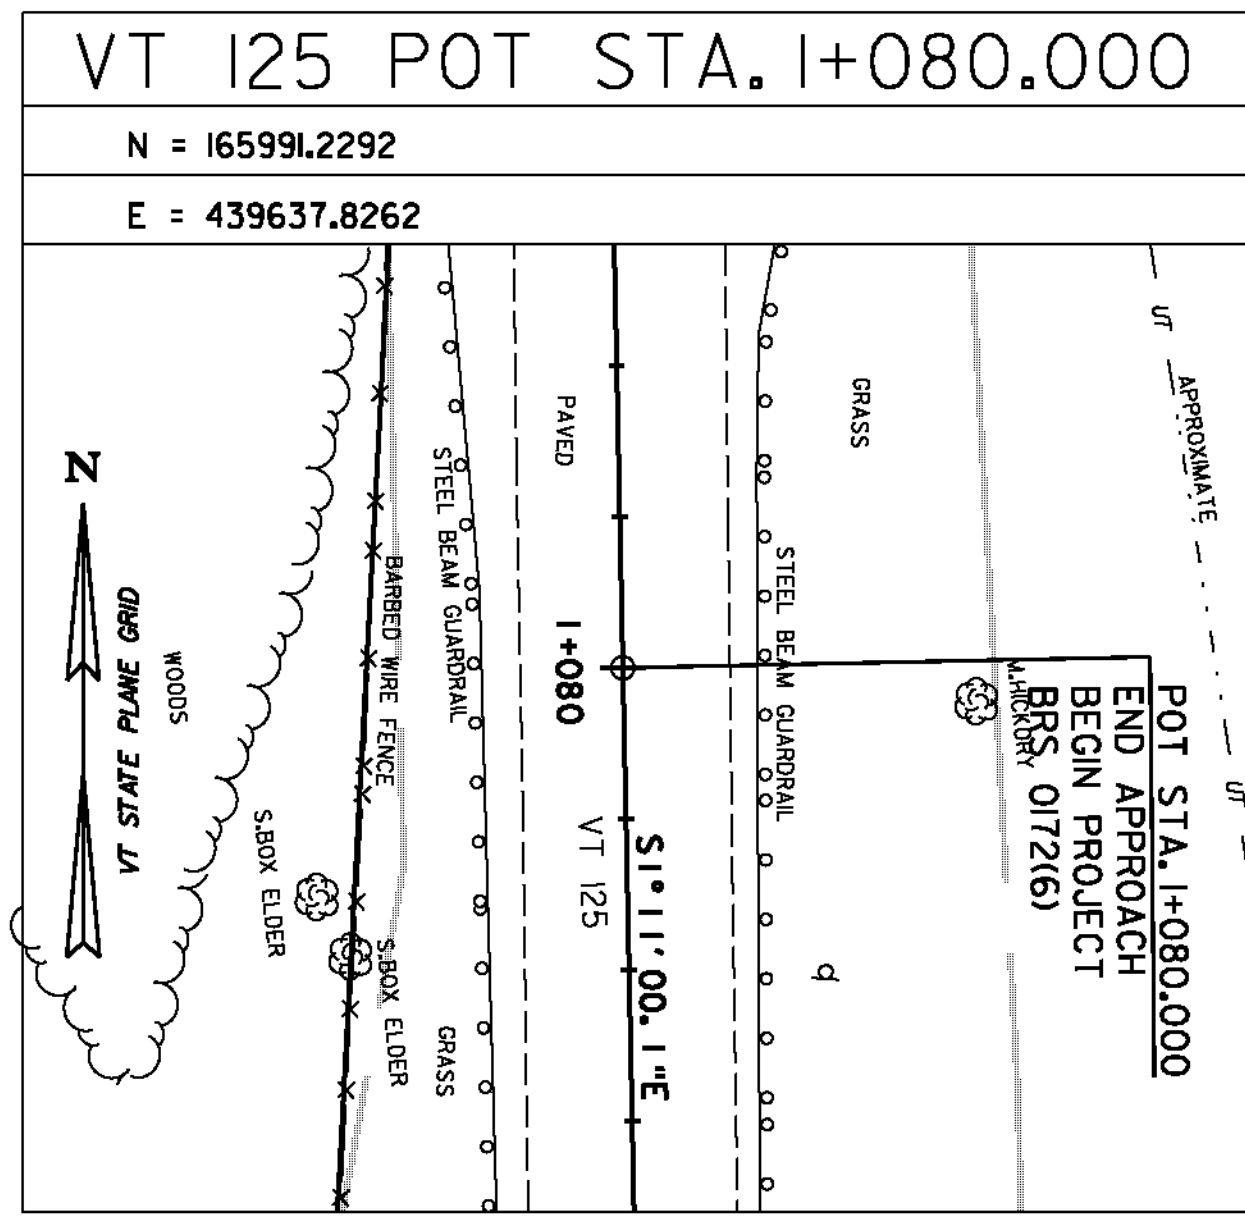

PROJECT: CORNWALL	PROJECT NO.: BRS 0172(6)
DESIGN FILE NAME: z85e0421e.dgn	PLOT DATE: 2/4/2010
IPARM FILE NAME:	SURVEY DATE: 1996&1999
SURVEYED BY: VTRANS & VT SURVEY	DRAWN BY: ERIK ATKINS
SQUAD LEADER: MARTHA EVANS-MONGEON	SHEET: 19 OF 144
TIE SHEET 2 OF 4	