
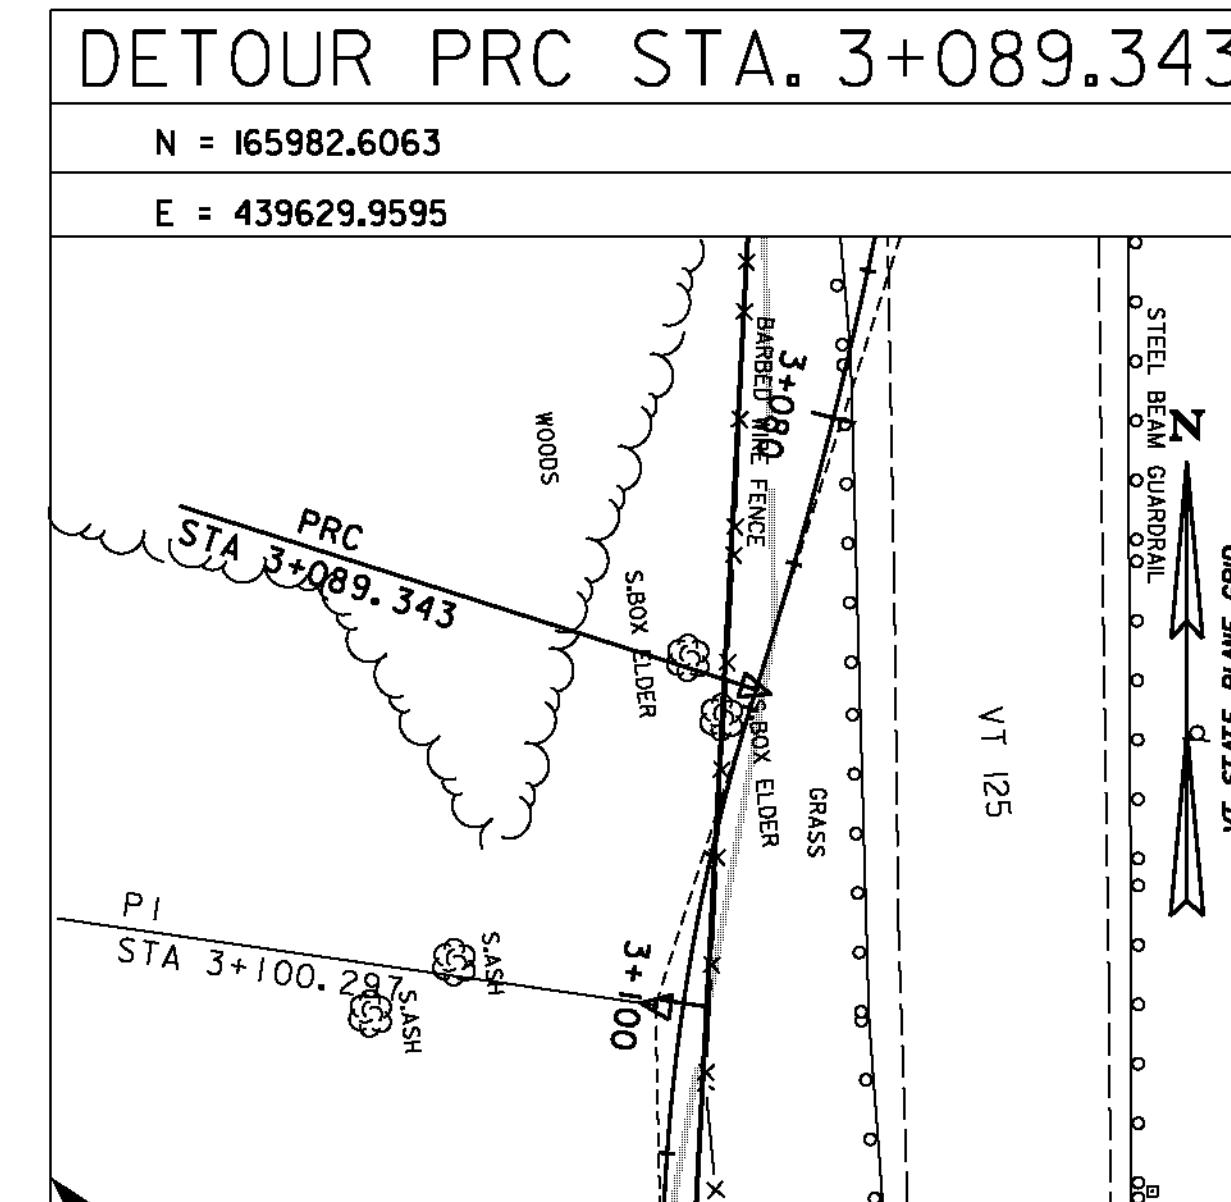
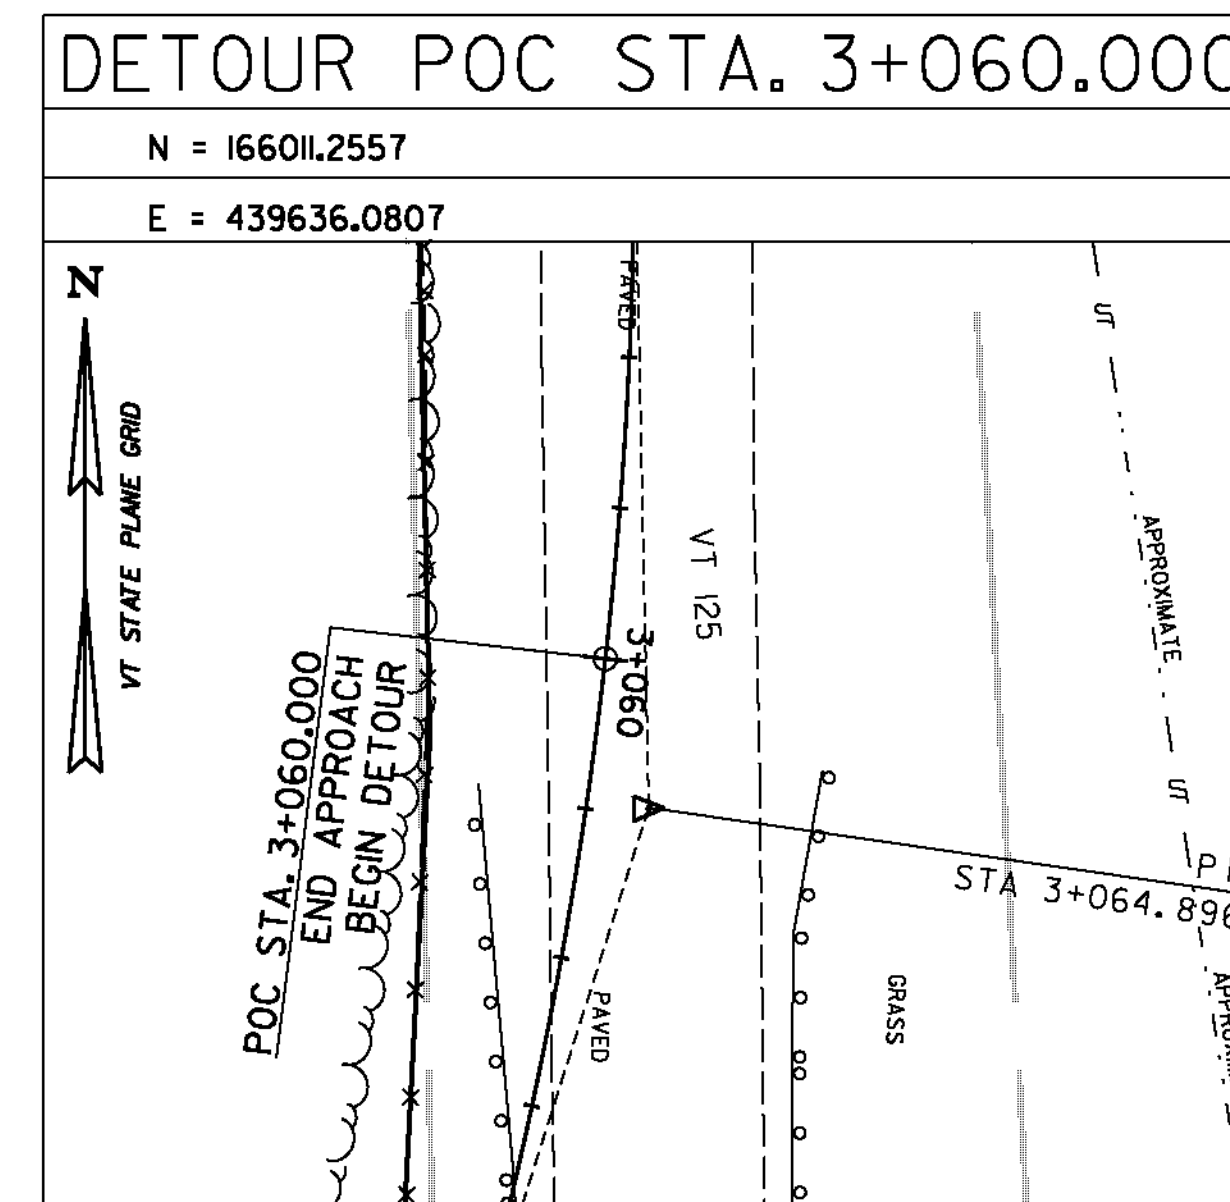
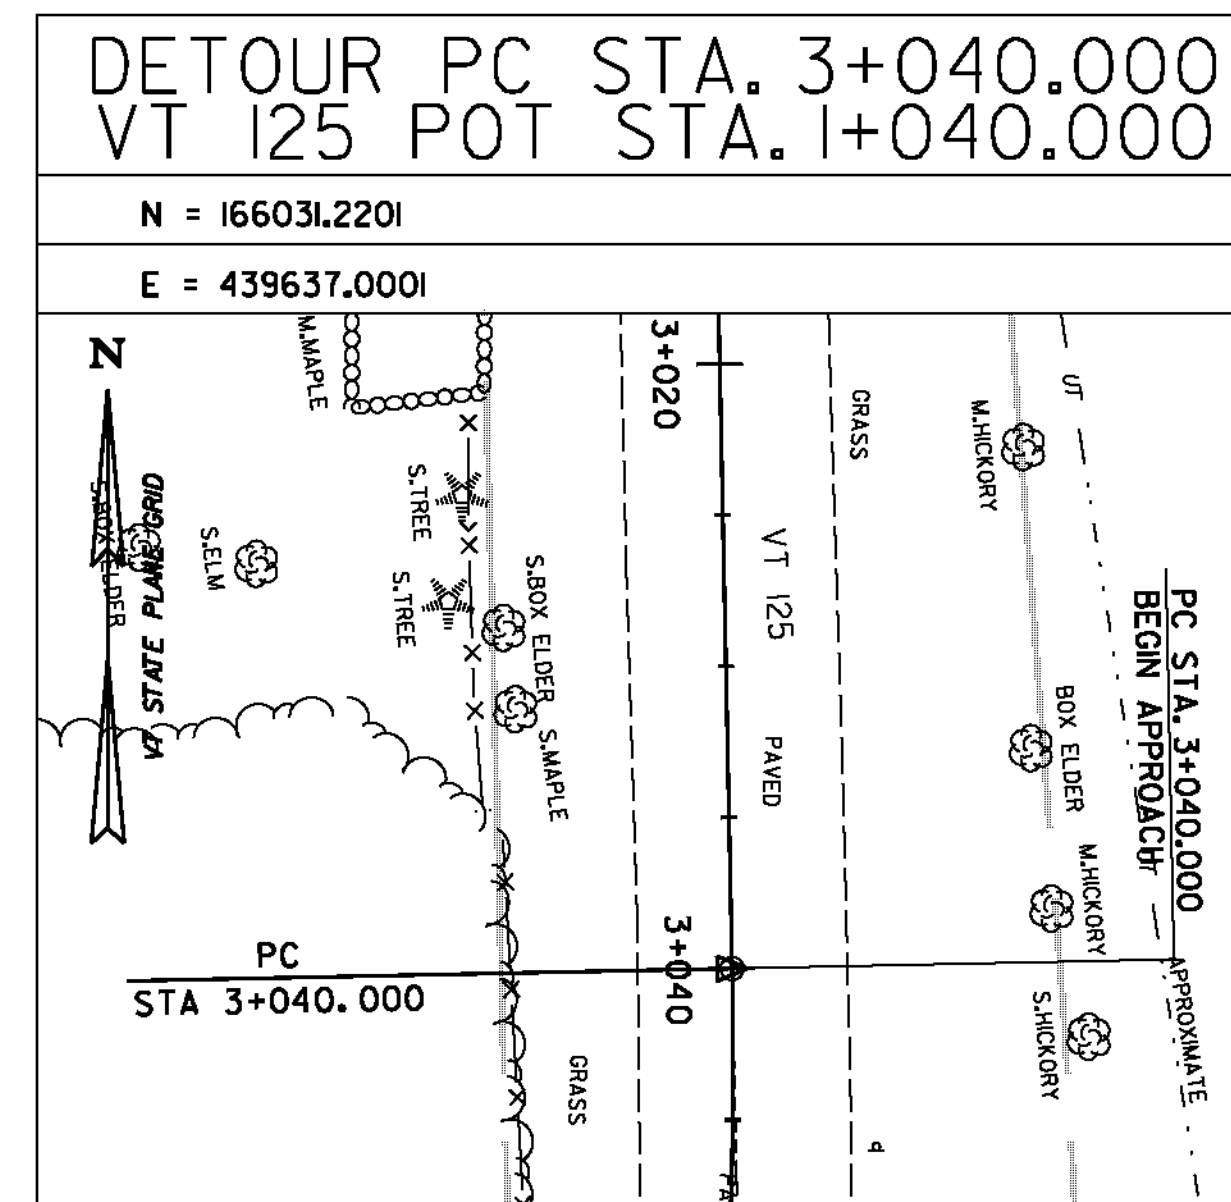
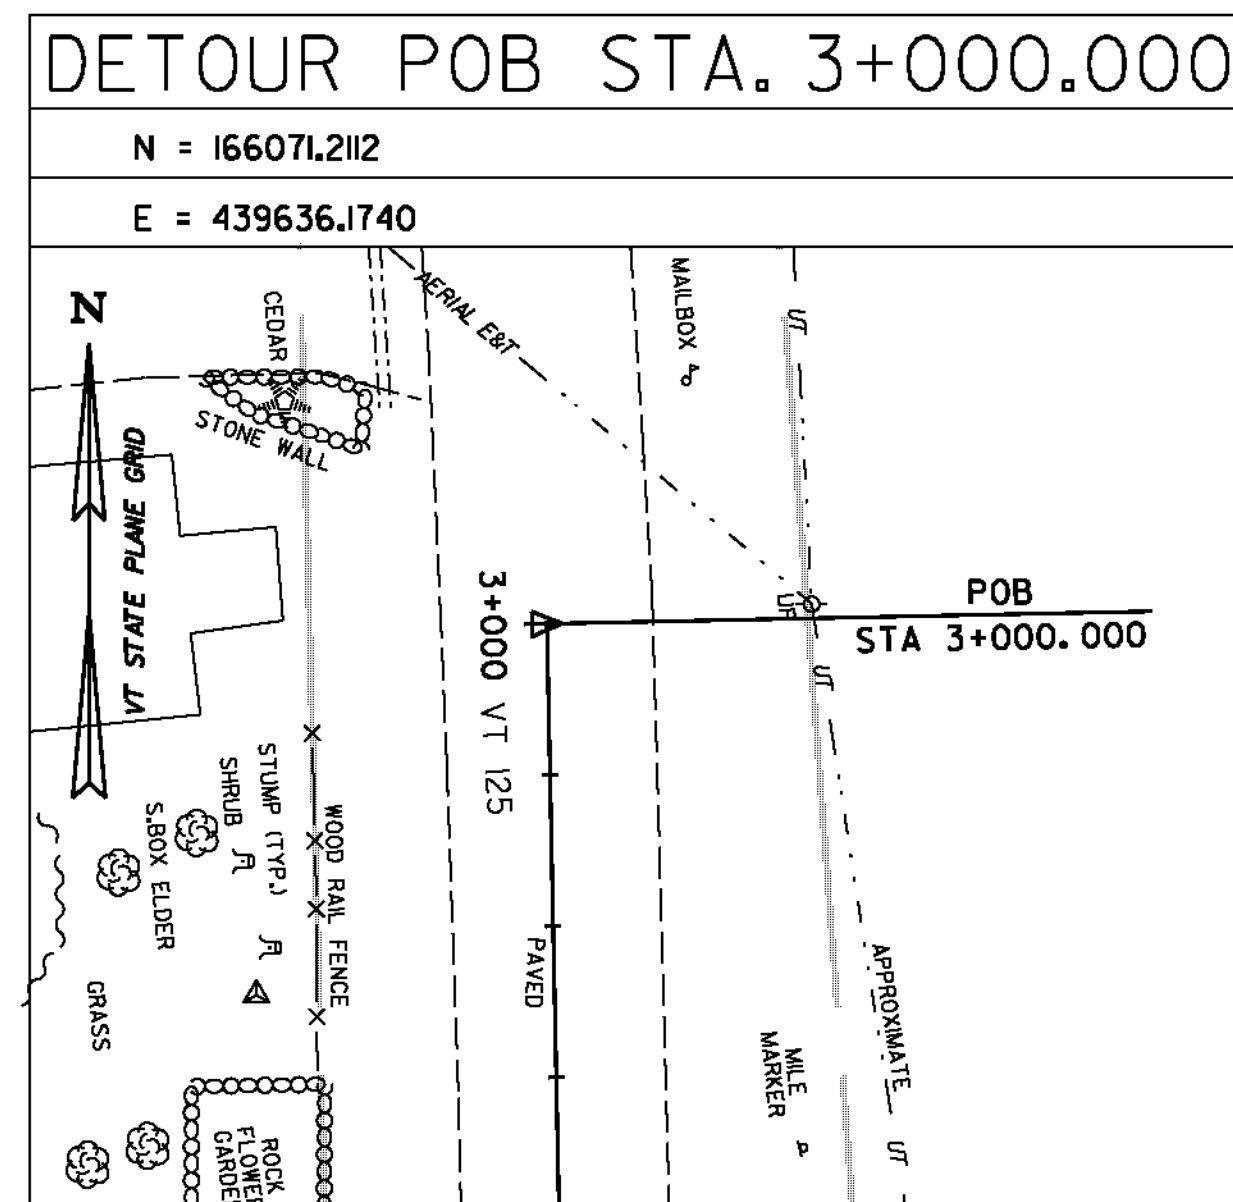
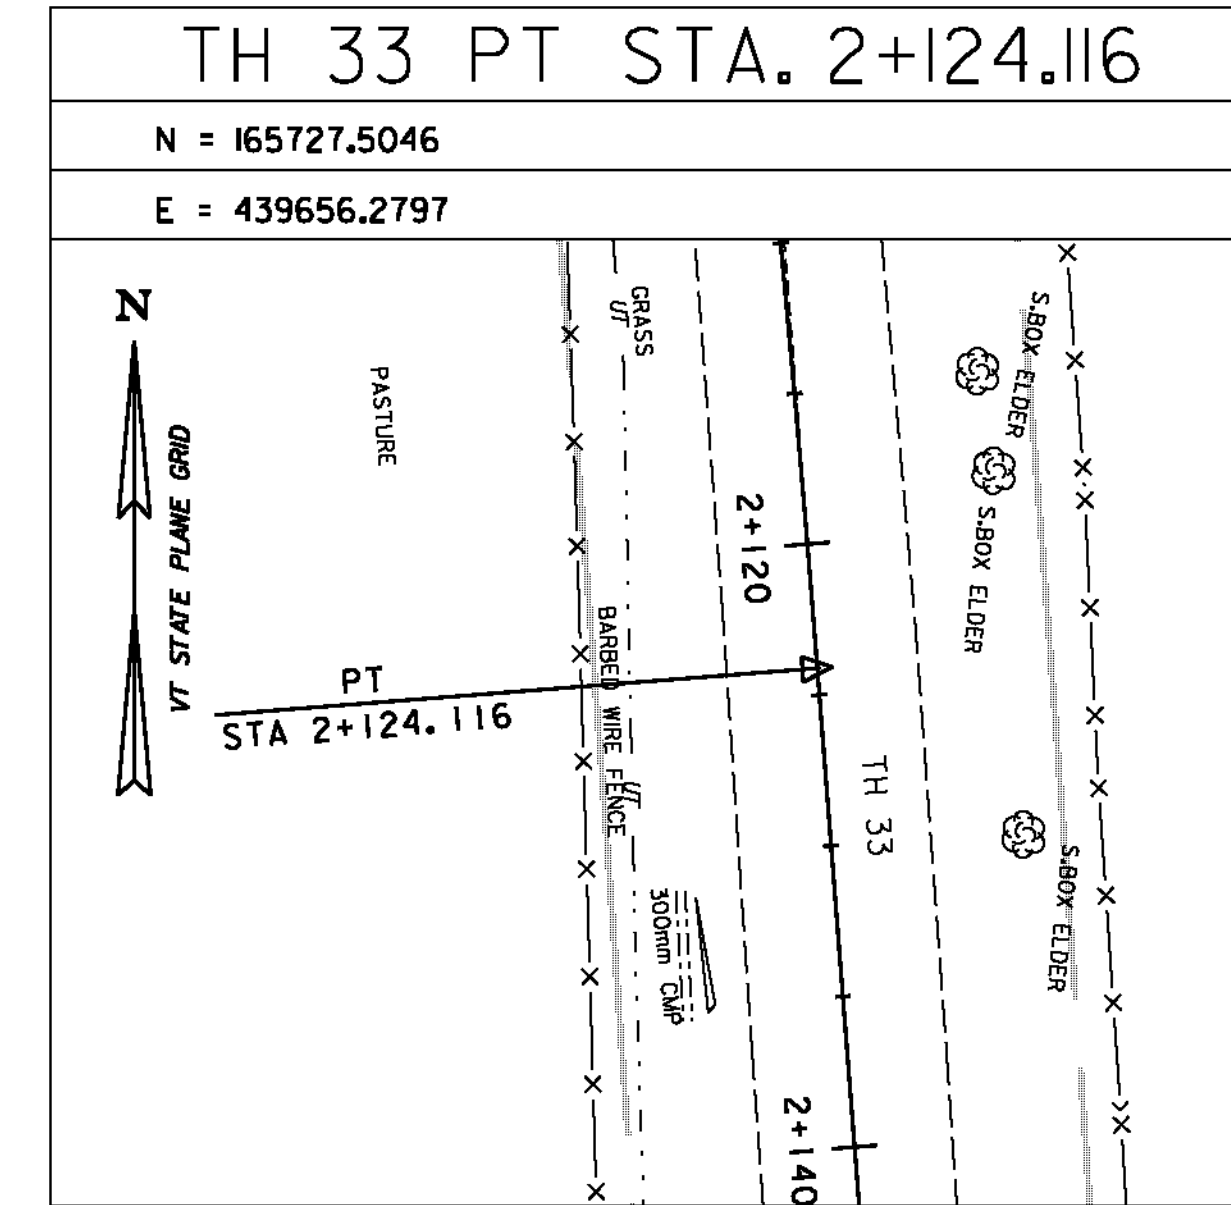
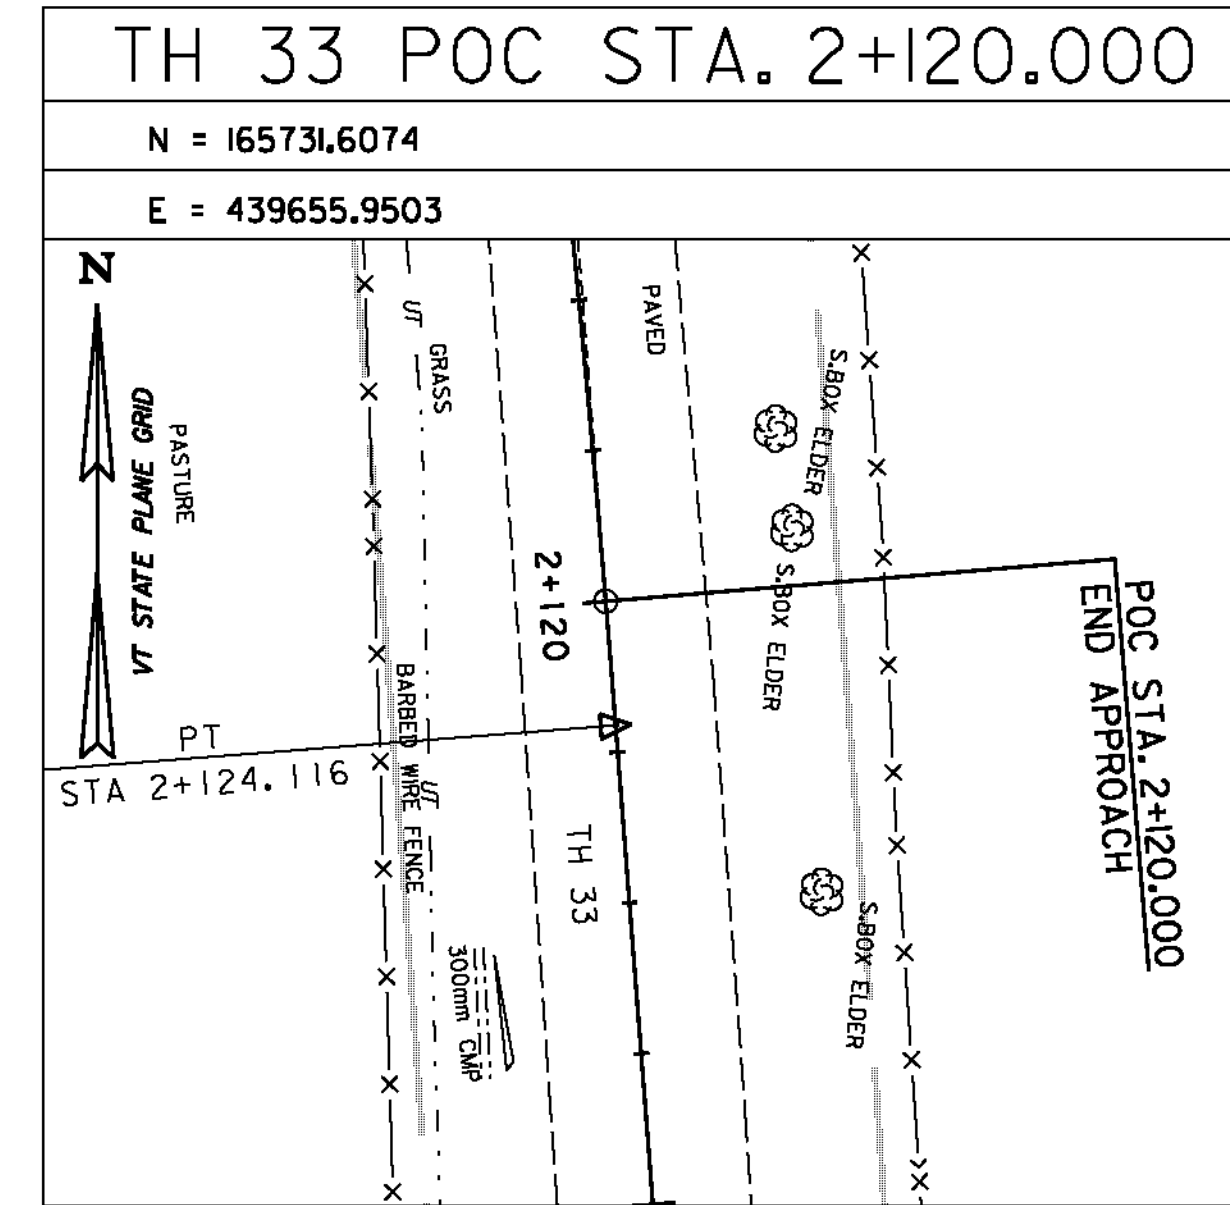
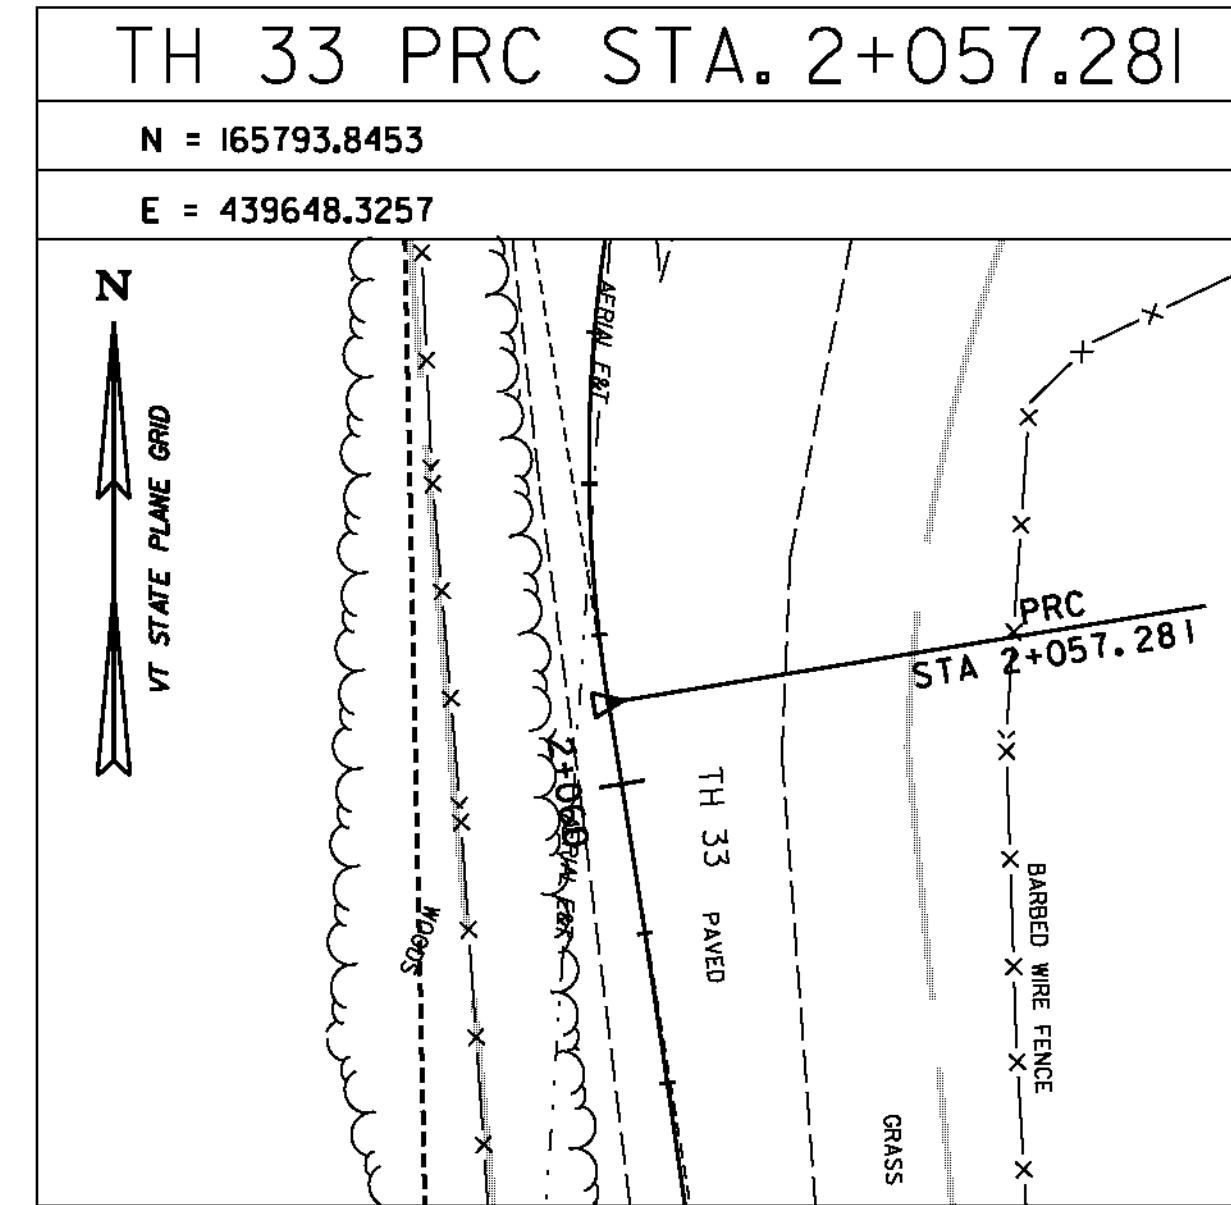


ALIGNMENT TIES

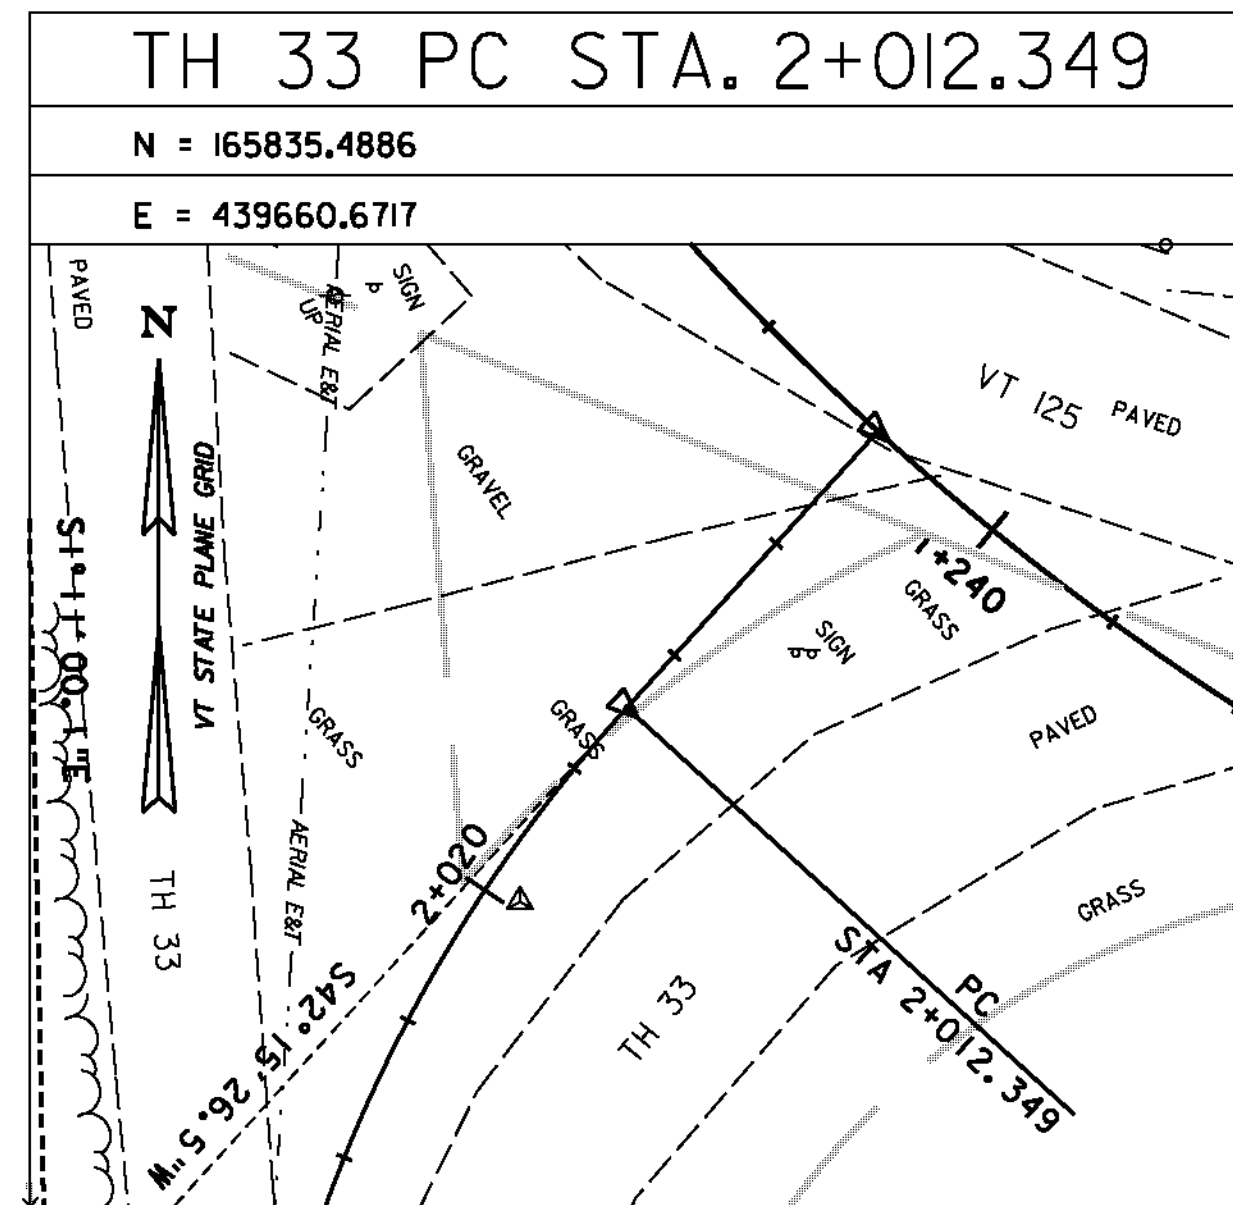

DATUM	
VERTICAL	NAVD 88
HORIZONTAL	NAD 83(92)

PROJECT: CORNWALL	PROJECT NO. : BRS 0172(6)
DESIGN FILE NAME: z85e0421e.dgn	PLOT DATE: 2/4/2010
IPARM FILE NAME:	SURVEY DATE: 1996&1999
SURVEYED BY: VTRANS & VT SURVEY	DRAWN BY: ERIK ATKINS
SQUAD LEADER: MARTHA EVANS-MONGEON	TIE SHEET 3 OF 4
	SHEET: 20 OF 144