



- DURABLE 100 MM WHITE LINE**
 VT 125 1+000 LT ~ VT 125 1+260 LT; EDGE LINE (3.3m LT)
 VT 125 1+000 RT ~ VT 125 1+219 RT; EDGE LINE (3.3m RT)
 VT 125 1+219 RT ~ TH 33 2+016.3 RT; EDGE LINE (RADIUS)
 TH 33 2+016.3 RT ~ TH 33 2+030 RT; EDGE LINE (3.0m RT)
 TH 33 2+016.3 LT ~ TH 33 2+030 LT; EDGE LINE (3.0m LT)
 VT 125 1+251.3 RT ~ TH 33 2+016.3 LT; EDGE LINE (RADIUS)
 VT 125 1+251.3 RT ~ VT 125 1+260 RT; EDGE LINE (3.3m RT)
- TEMPORARY 100 MM WHITE LINE**
 VT 125 1+000 LT ~ VT 125 1+260 LT; EDGE LINE (3.3m LT)
 VT 125 1+000 RT ~ VT 125 1+219 RT; EDGE LINE (3.3m RT)
 VT 125 1+219 RT ~ TH 33 2+016.3 RT; EDGE LINE (RADIUS)
 TH 33 2+016.3 RT ~ TH 33 2+030 RT; EDGE LINE (3.0m RT)
 TH 33 2+016.3 LT ~ TH 33 2+030 LT; EDGE LINE (3.0m LT)
 VT 125 1+251.3 RT ~ TH 33 2+016.3 LT; EDGE LINE (RADIUS)
 VT 125 1+251.3 RT ~ VT 125 1+260 RT; EDGE LINE (3.3m RT)
- REMOVING SIGNS**
 16 EACH
- DURABLE 100 MM YELLOW LINE**
 VT 125 1+000 C ~ VT 125 1+225 C SOLID DOUBLE LINE
 VT 125 1+245 C ~ VT 125 1+260 C SOLID DOUBLE LINE
 TH 33 2+006 C ~ TH 33 2+030 C SOLID DOUBLE LINE
- TEMPORARY 100 MM YELLOW LINE**
 VT 125 1+000 C ~ VT 125 1+225 C SOLID DOUBLE LINE
 VT 125 1+245 C ~ VT 125 1+260 C SOLID DOUBLE LINE
 TH 33 2+006 C ~ TH 33 2+030 C SOLID DOUBLE LINE
- DURABLE 600 MM STOP BAR**
 TH 33 2+006 LT. - 8 640 LONG
- TEMPORARY 600 MM STOP BAR**
 TH 33 2+006 LT - 8 640 LONG
- DURABLE LETTER OR SYMBOL**
 TH 33 2+007.2 LT - 2+009.7 LT - 4 EACH
- TEMPORARY LETTER OR SYMBOL**
 TH 33 2+007.2 LT - 2+009.7 LT - 4 EACH

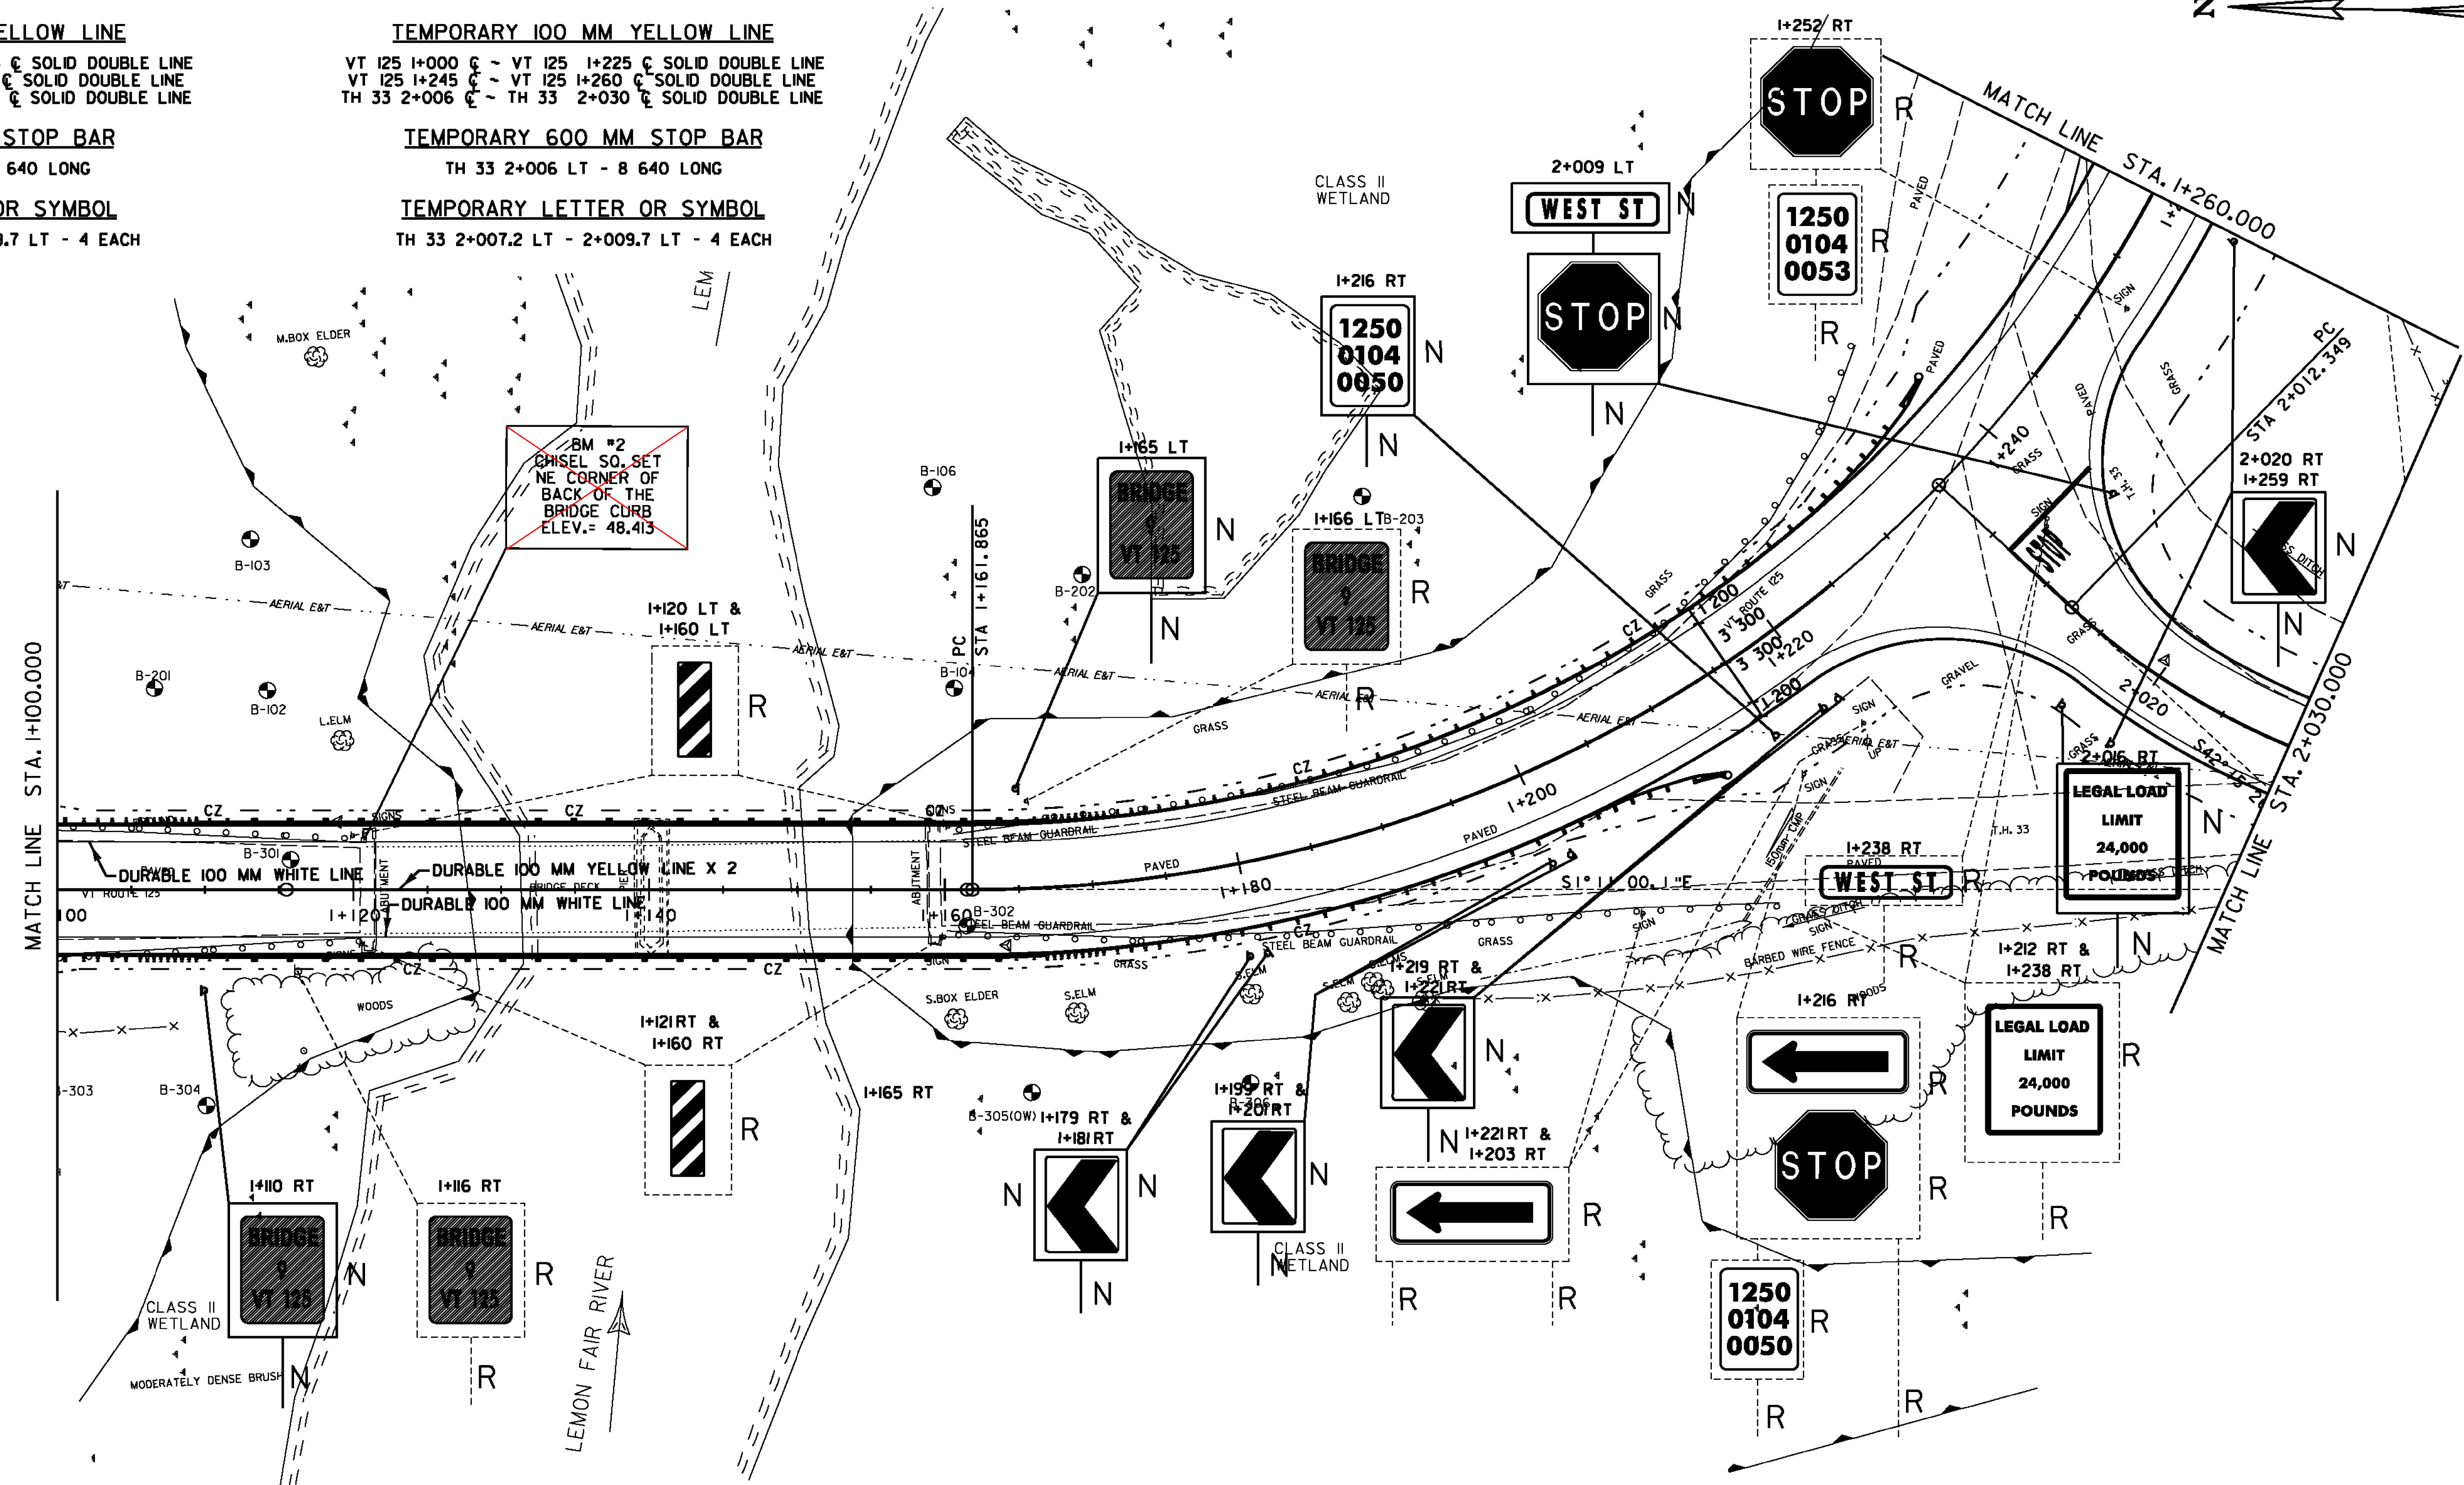

SIGN LEGEND

- = EXISTING SIGN
- = NEW SIGN
- = REMOVE
- = NEW

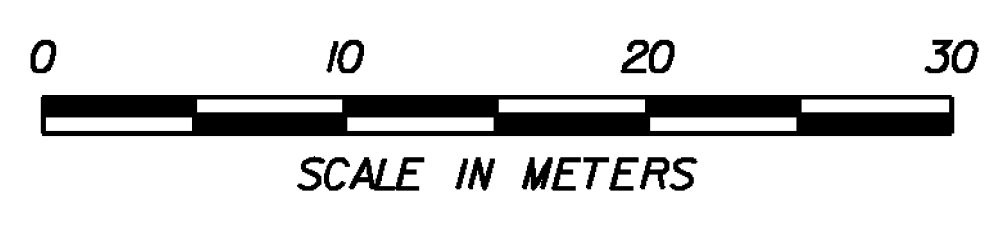

DATUM
 VERTICAL NAVD 88
 HORIZONTAL NAD 83(92)

PROJECT: CORNWALL	PROJECT NO. # BRS 0172(6)
DESIGN FILE NAME: z85e042+sbdr.dgn	PLOT DATE: 3/15/2010
IPARM FILE NAME:	SURVEY DATE: 1996&1999
SURVEYED BY: VTRANS & VT SURVEY	DRAWN BY: ERIK ATKINS
SQUAD LEADER: MARTHA EVANS-MONGEON	SHEET: 58 OF 144
PVMT MARKINGS AND SIGNS LAYOUT SHEET 2	